


Work - 500
1725

1725
1622
1221
5081

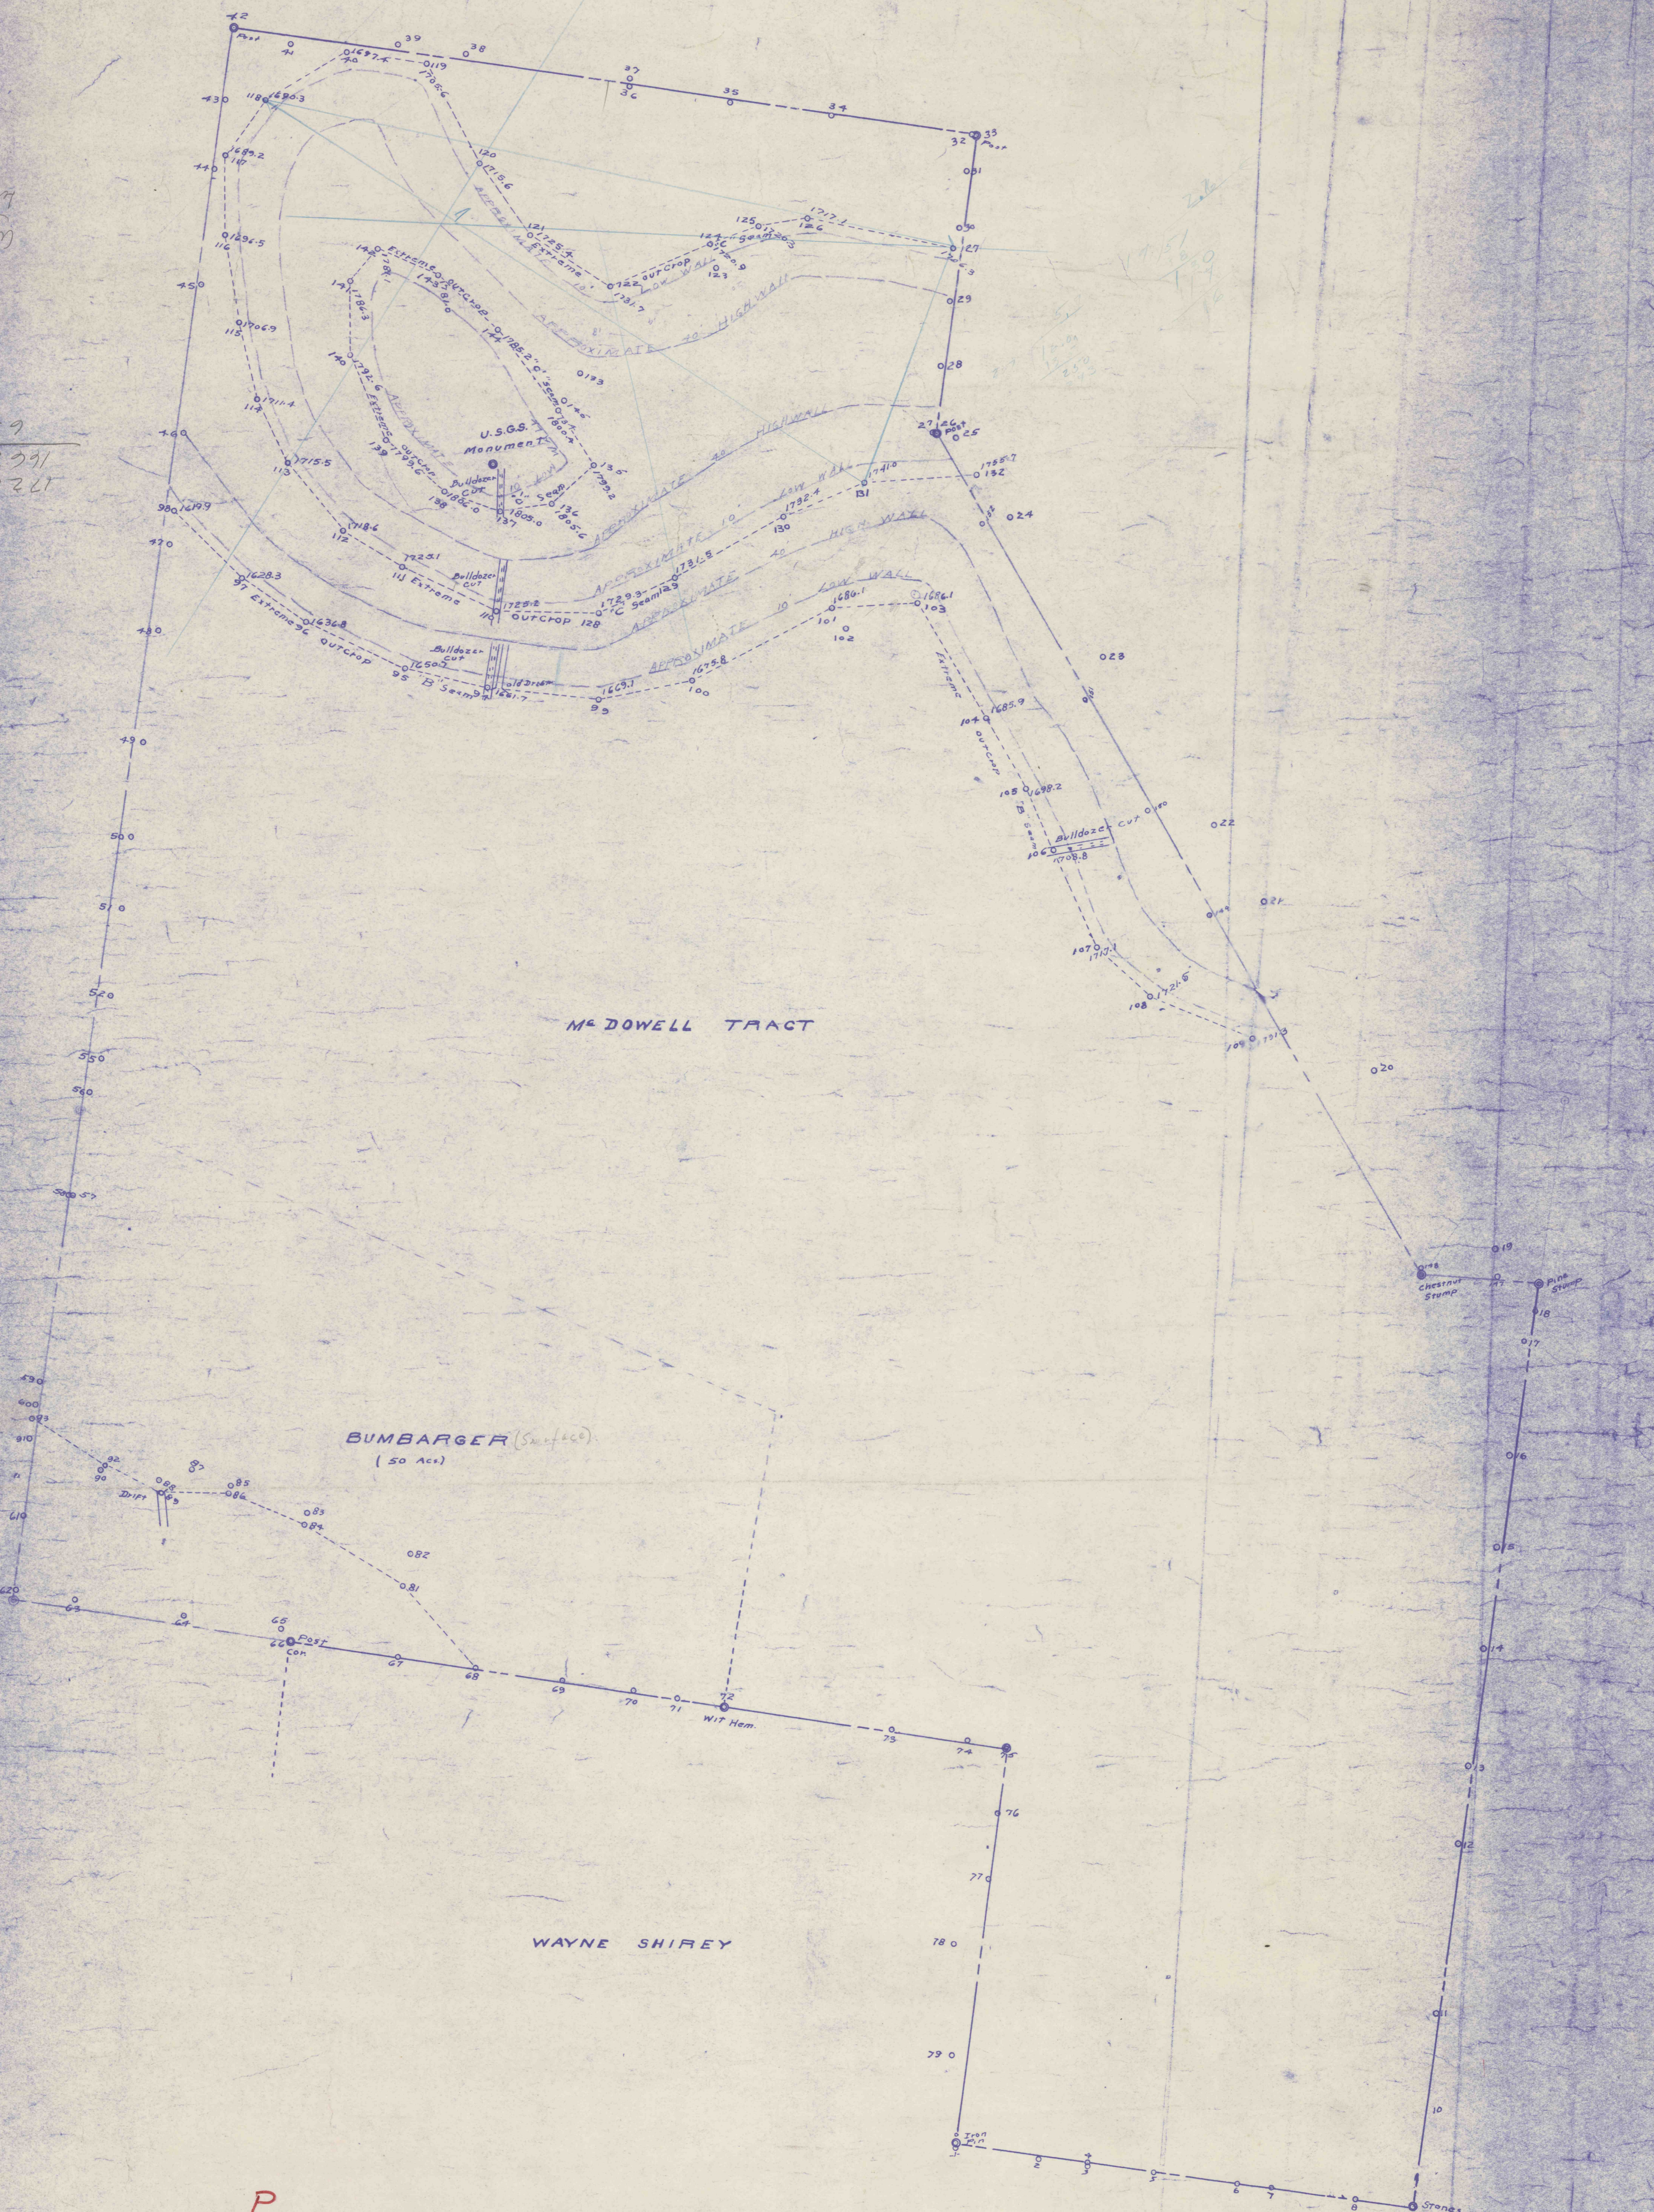

P
8259

WOOLRIDGE COAL CO.
CLEARFIELD, PA.
MAP OF COAL LANDS
MCDOWELL TRACT
IN
BRADFORD TWP., CLFD. CO., PA.
SCALE 1" = 200'
CLEARFIELD, PA. ROY C. KINDIG
APRIL 8 1949 REG. ENGR.

6942