

WATKINS COAL COMPANY

J. M. WEAHLAND

W. LANTY

J. M. WEAHLAND

HENRY STAMBLER


COAL COMPANY

HILL

RICH

COAL

COMPANY

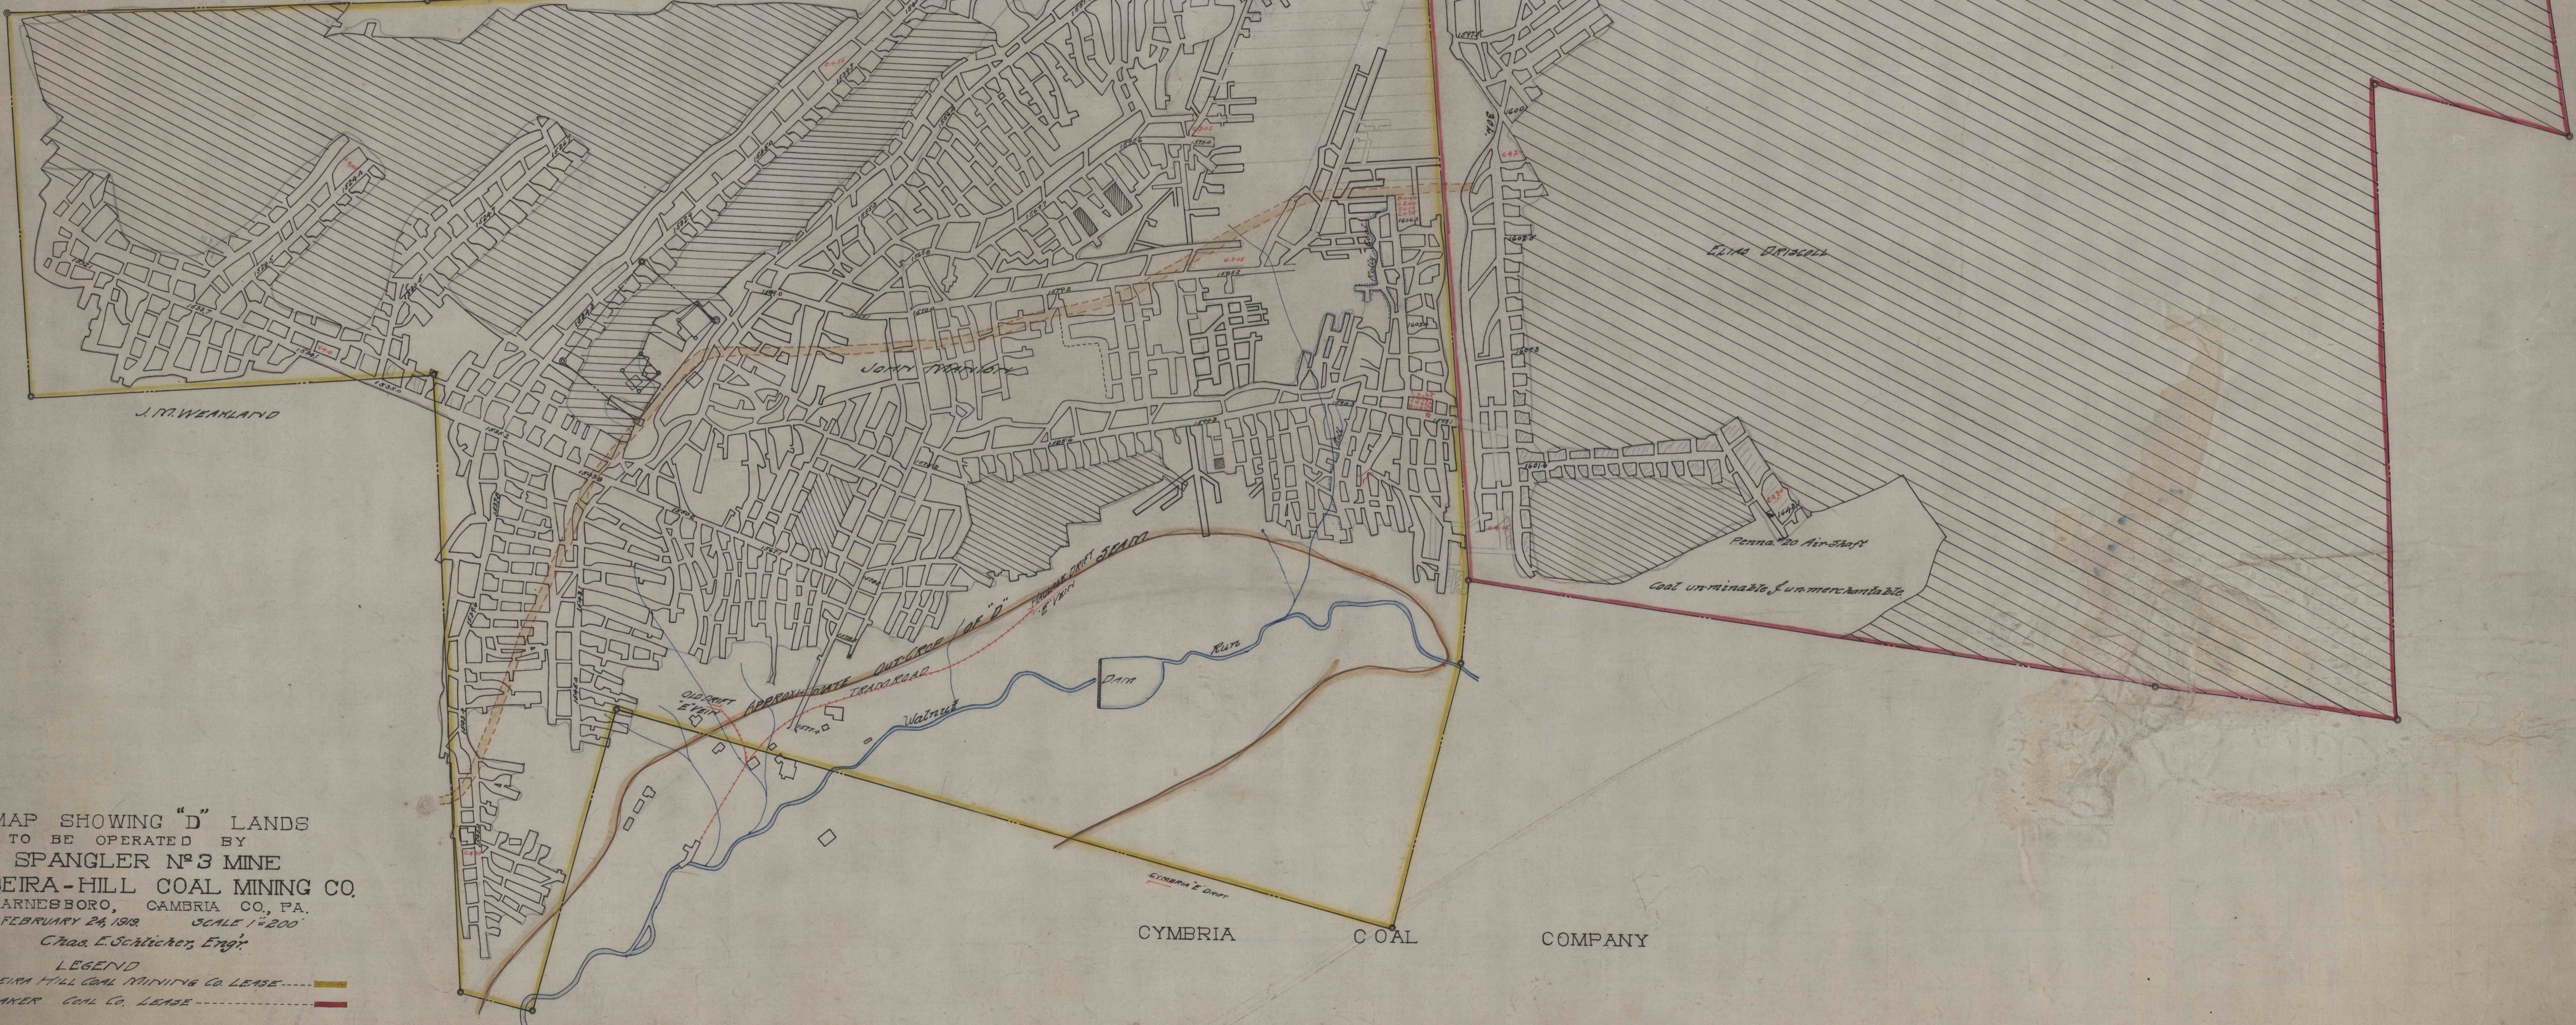

MAP SHOWING "D" LANDS  
 TO BE OPERATED BY  
 SPANGLER N°3 MINE  
 MADEIRA-HILL COAL MINING CO.  
 BARNESBORO, CAMBRIA CO., PA.  
 FEBRUARY 24, 1912 SCALE 1"=200'  
 Chas. L. Schlichter, Eng'r

LEGEND  
 MADEIRA HILL COAL MINING CO. LEASE-----  
 BURNHAM COAL CO. LEASE-----

CYBERIA COAL COMPANY

714  
A117