

GREEN GLEN SUR.
J. S. REITZ EST. MIN.

GREEN GLEN SUR.
J. S. REITZ EST. MIN.


GREEN GLEN SUR.
J. E. DUBOIS EST. MIN.
LOWER FREEPORT COAL

GREEN GLEN SUR.
J. S. REITZ EST. MIN.

GREEN GLEN SUR.
J. S. REITZ EST. MIN.

Legend:

- Lower Freeport Coal Removed by Deep Mine.
- Lower Freeport Coal Removed by Strip Mine.
- Fault Area.
- Lower Freeport Coal in place.

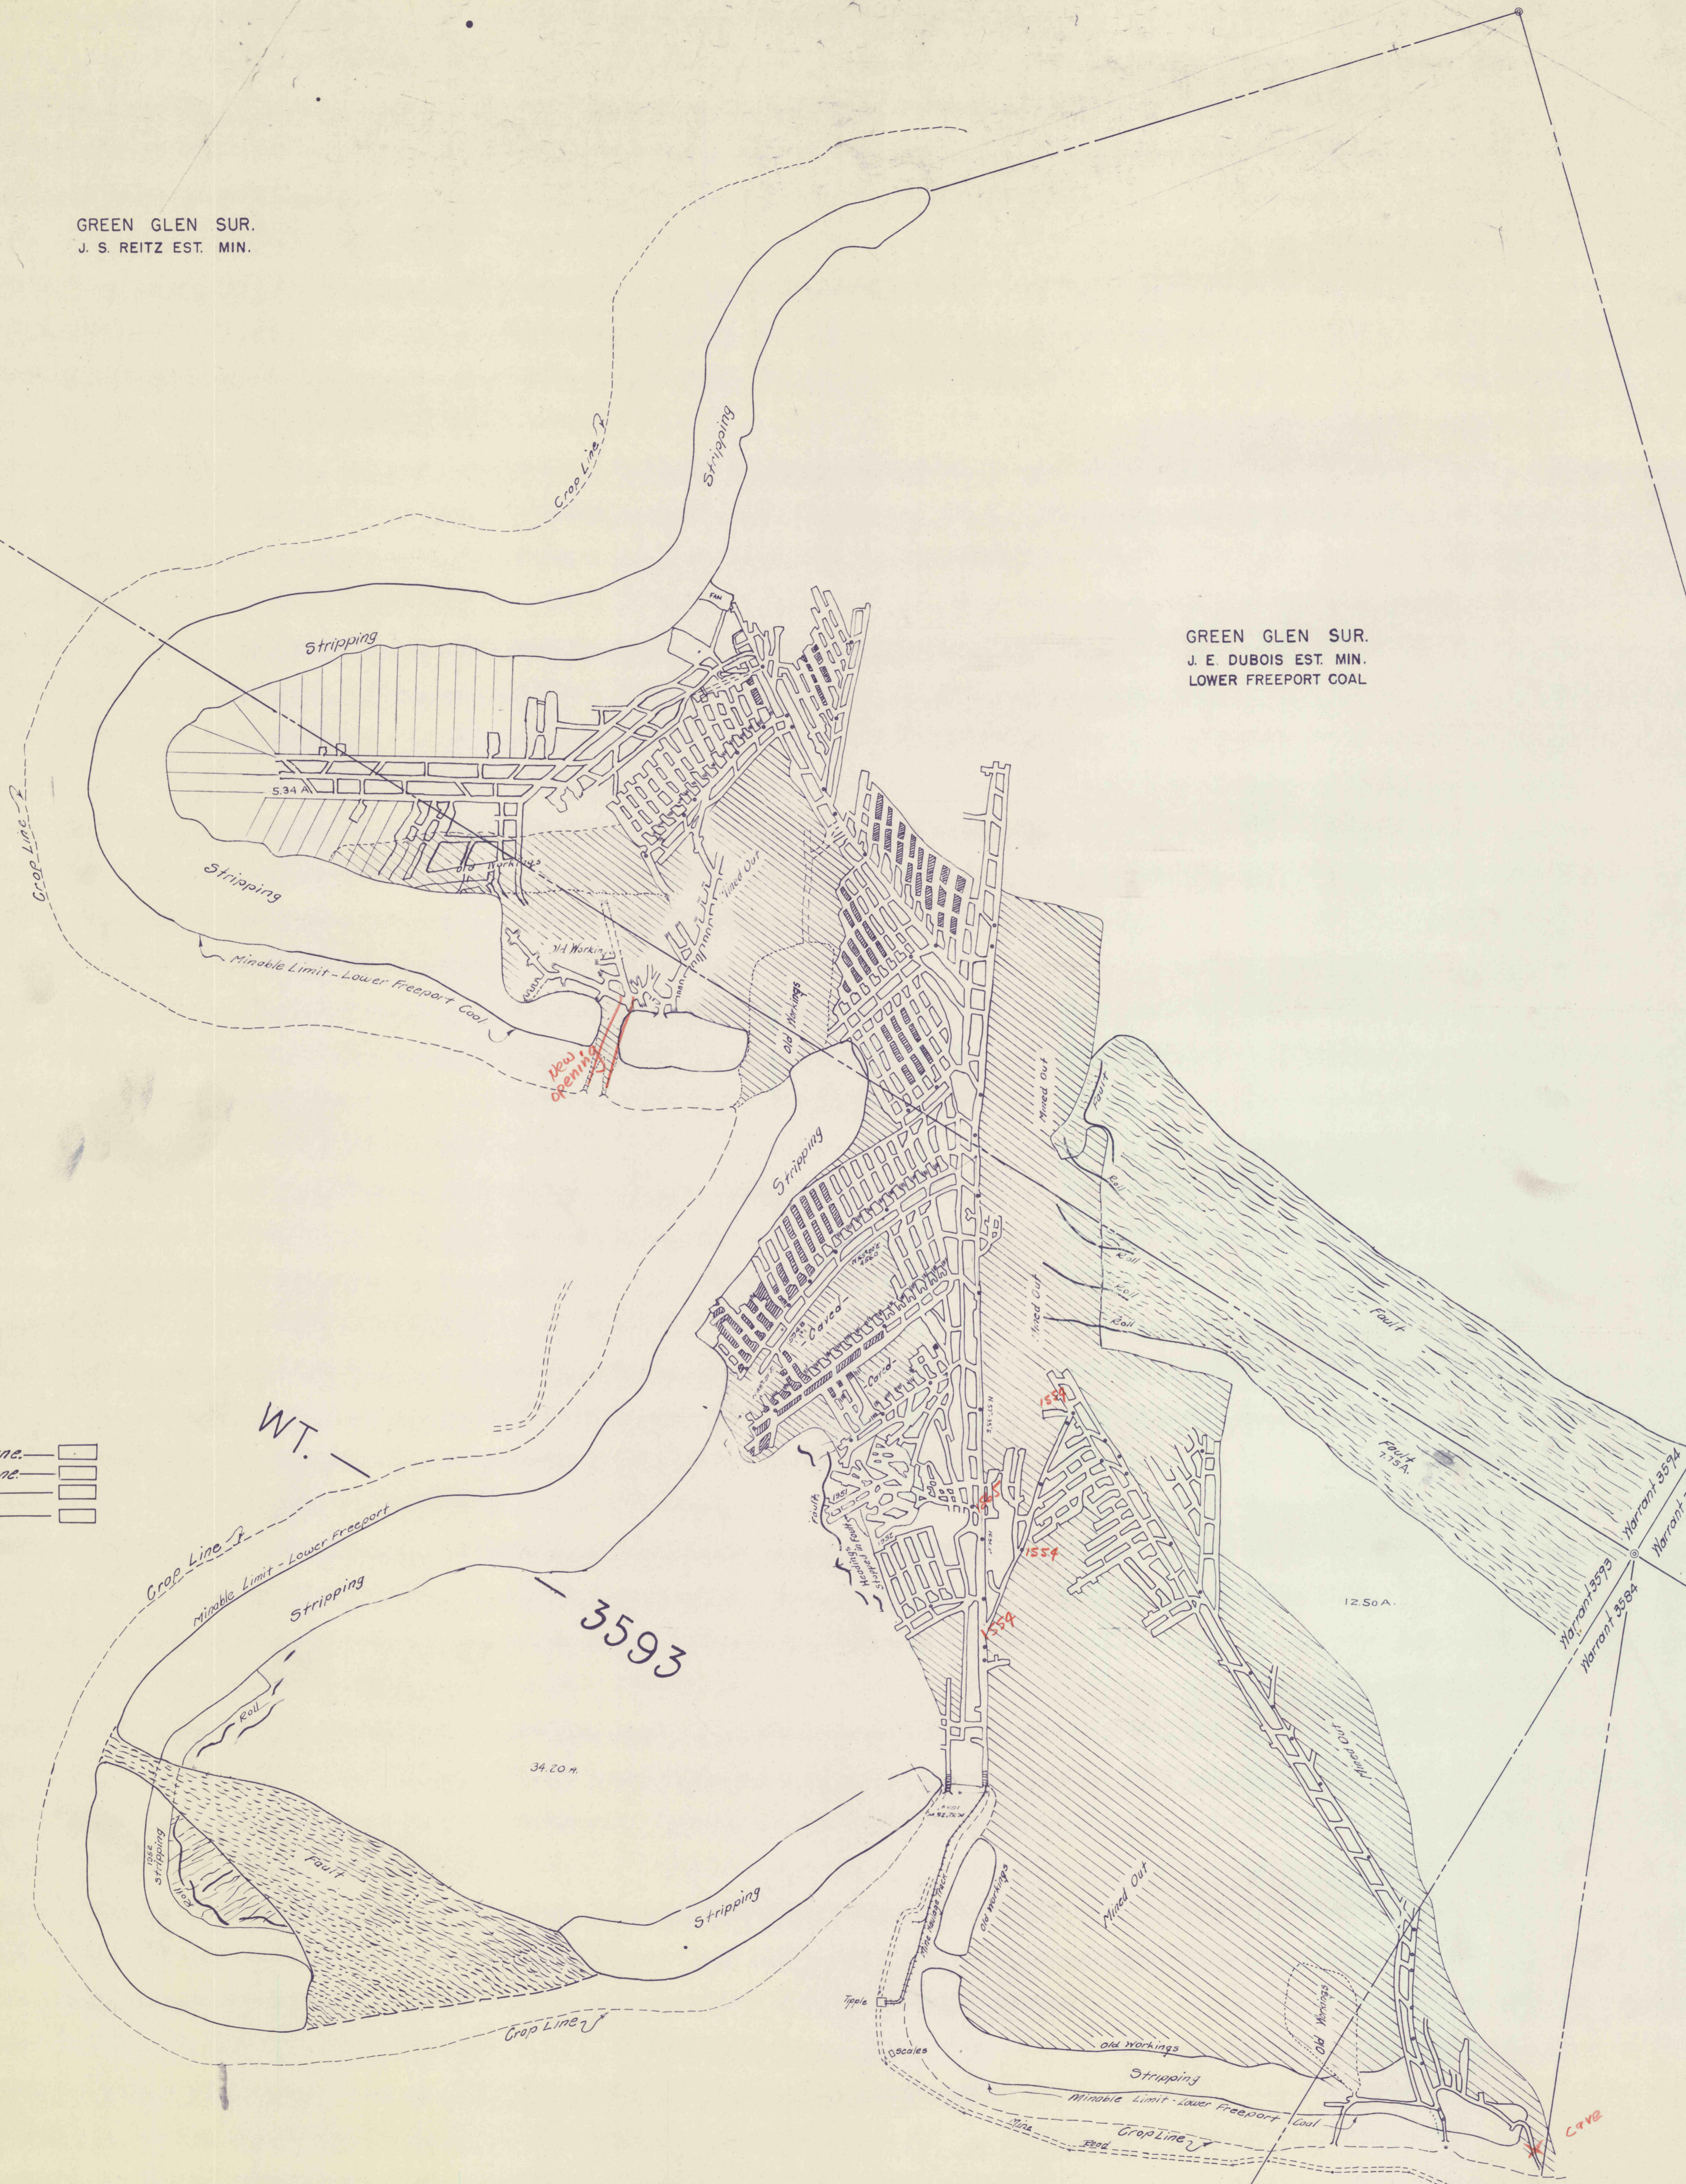

John E. Du Bois Est.
Map of
CLEAR RUN MINE
Du Bois, Pa.

SCALE 1 in. = 200 ft.
Compiled From Map of J. E. Fry Eng. and Actual Surveys
Jan. 10, 1949
Jan. 3, 1950
Sep. 6, 1950
Jan. 12, 1951
Jan. 21, 1953
Feb. 11, 1956

Simpson & Madison, Engrs.