


TEST HOLE DATA			
T.H. #	SUR. ELEV.	B.C.	COAL SEAM / THICKNESS
1.	1593	1563	UPPER FREEPORT DEEP MINE
3.	1595	1559	UPPER FREEPORT 48"
		1520	LOWER FREEPORT DEEP MINE
5.	1580	1543	UPPER FREEPORT 48"
		1500	LOWER FREEPORT DEEP MINE
7.	1565	1531	UPPER FREEPORT DEEP MINE
		1490	LOWER FREEPORT DEEP MINE
8.	1560	1528	UPPER FREEPORT 48"
		1485	LOWER FREEPORT DEEP MINE
10.	1535	1511	UPPER FREEPORT 48"
		1477	LOST AIR
		1445	WET
11.	1520	1500	LOWER FREEPORT DEEP MINE
14.	1580	1549	UPPER FREEPORT DEEP MINE



LOCATION MAP
SCALE: 1" = 2000'

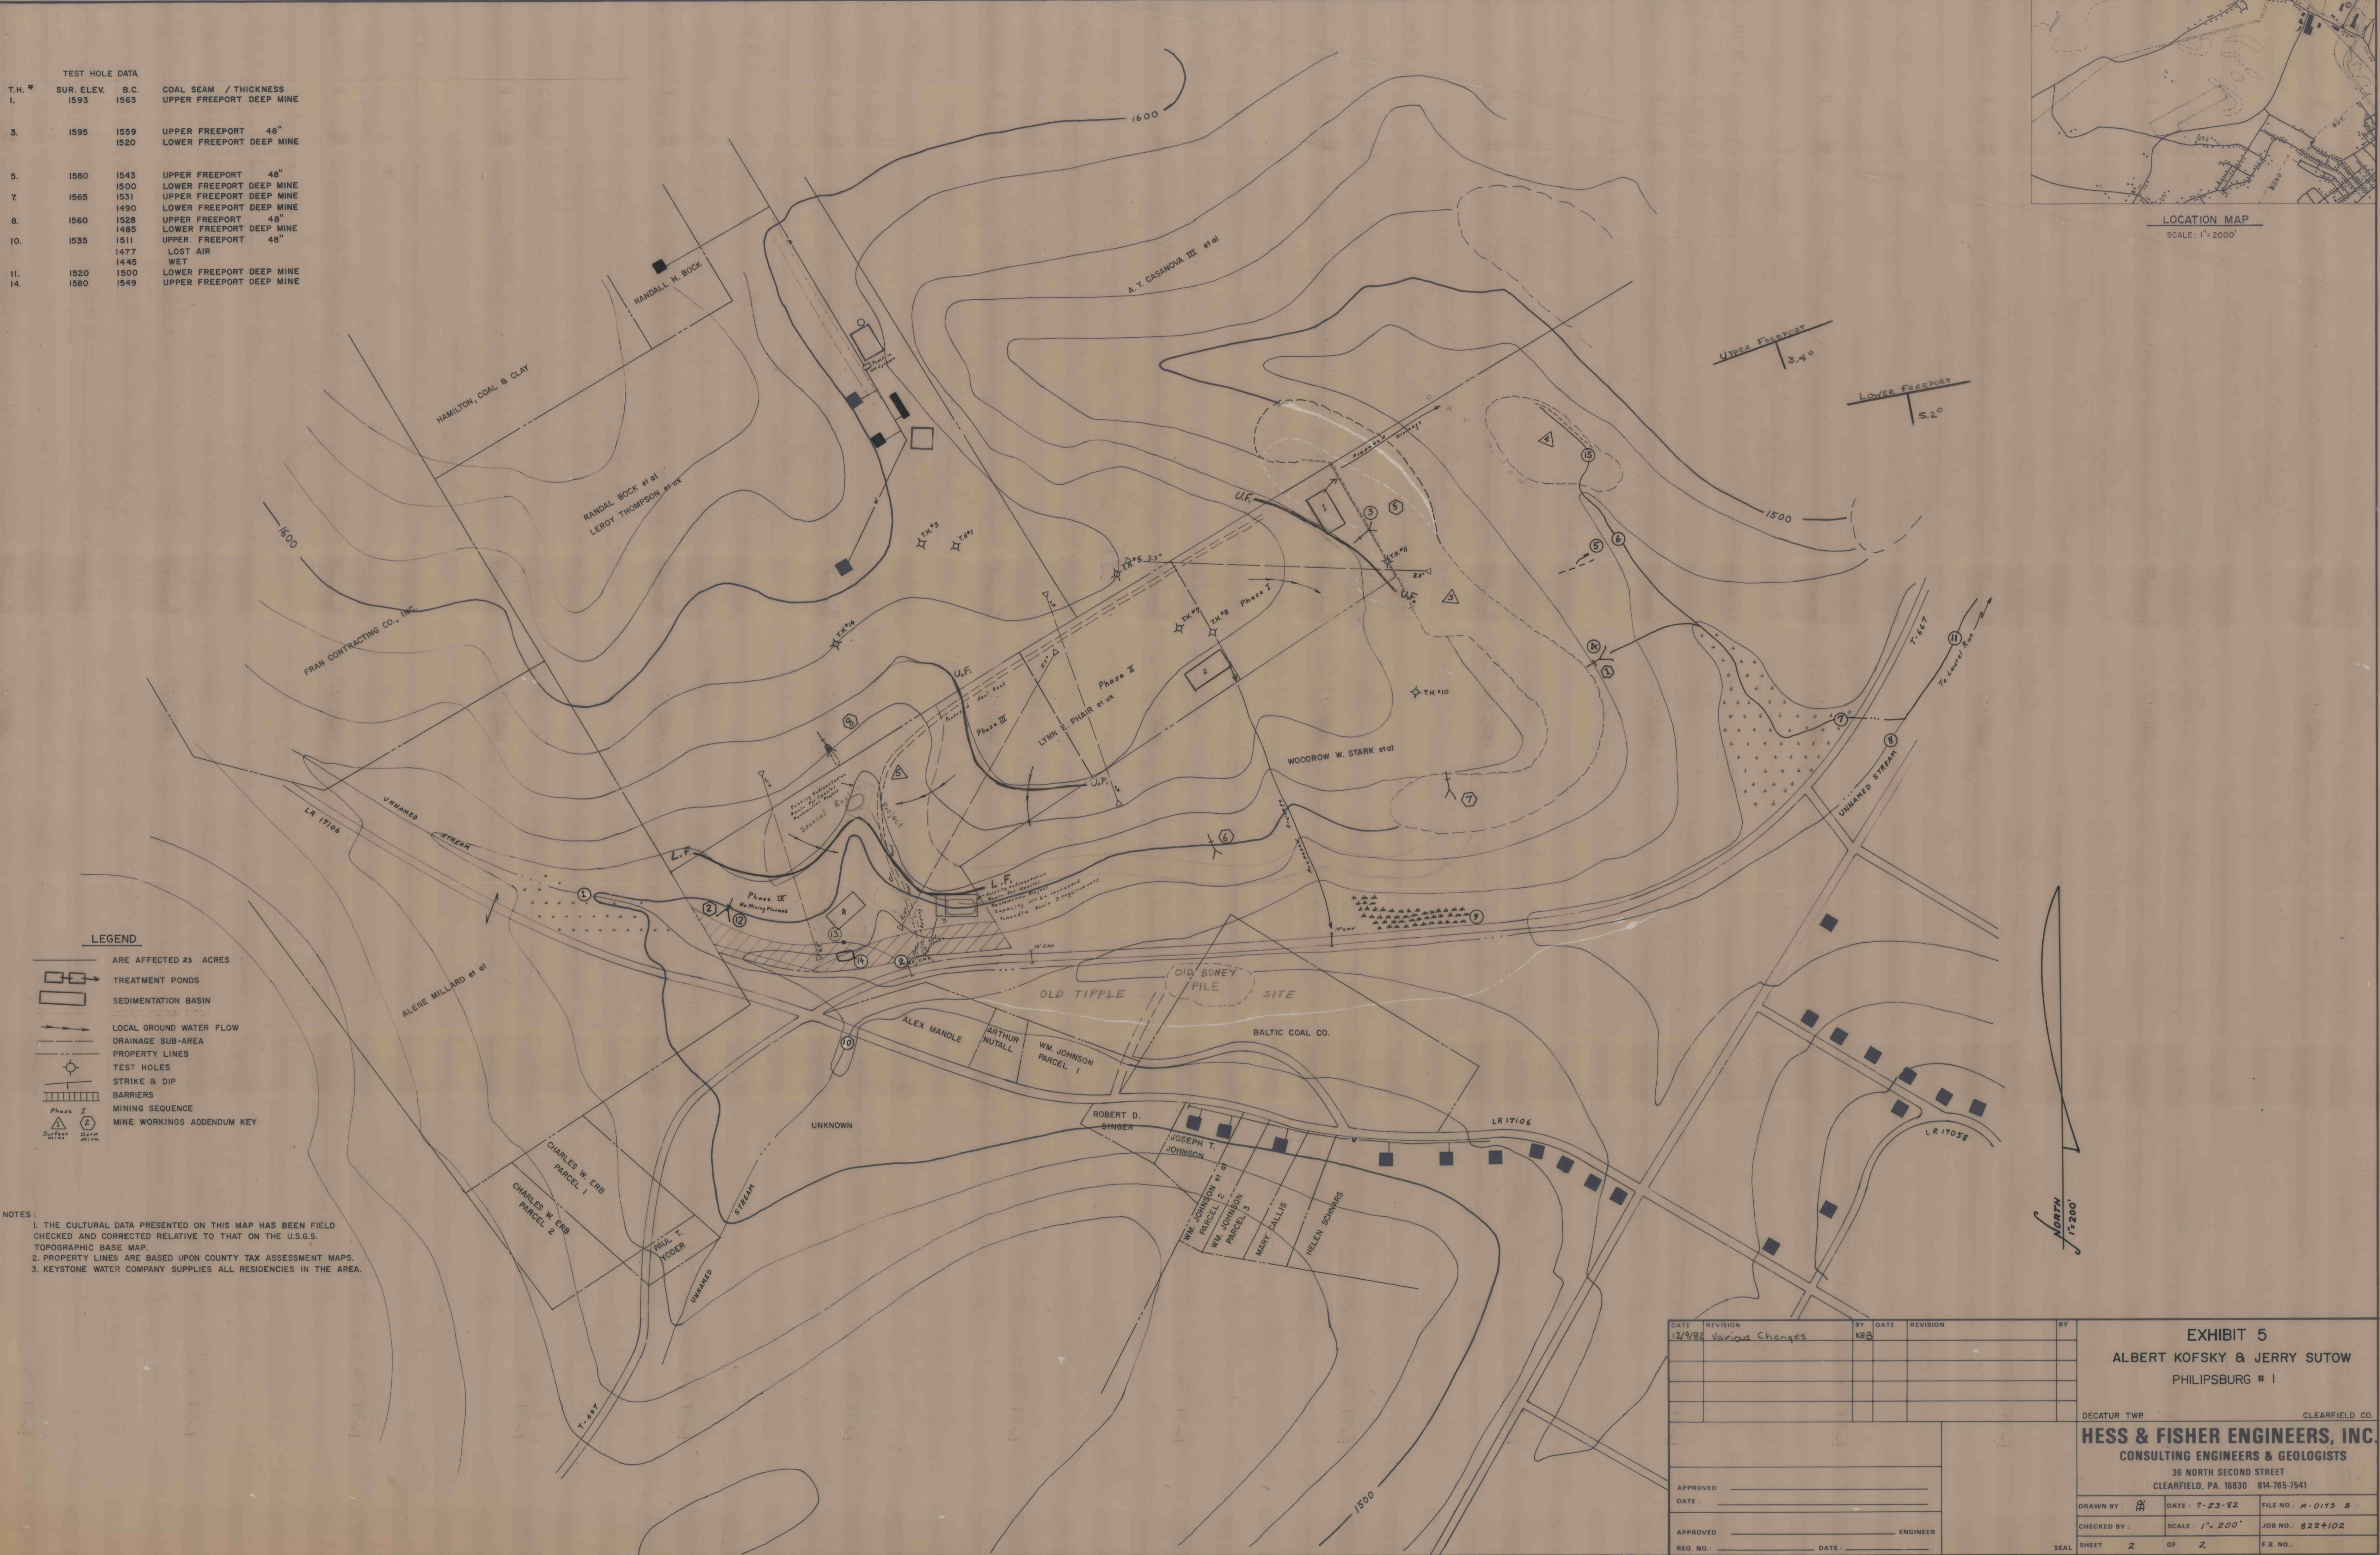

- LEGEND**
- ARE AFFECTED 23 ACRES
 - TREATMENT PONDS
 - SEDIMENTATION BASIN
 - LOCAL GROUND WATER FLOW
 - DRAINAGE SUB-AREA
 - PROPERTY LINES
 - TEST HOLES
 - STRIKE & DIP
 - BARRIERS
 - MINING SEQUENCE
 - MINING WORKINGS ADDENDUM KEY

NOTES:
 1. THE CULTURAL DATA PRESENTED ON THIS MAP HAS BEEN FIELD CHECKED AND CORRECTED RELATIVE TO THAT ON THE U.S.G.S. TOPOGRAPHIC BASE MAP.
 2. PROPERTY LINES ARE BASED UPON COUNTY TAX ASSESSMENT MAPS.
 3. KEYSTONE WATER COMPANY SUPPLIES ALL RESIDENCES IN THE AREA.

NORTH
1" = 200'

DATE	REVISION	BY	DATE	REVISION	BY
12/9/82	Various Changes	KEB			

APPROVED: _____	DATE: _____	ENGINEER
APPROVED: _____	DATE: _____	ENGINEER
REG. NO. _____	DATE: _____	

EXHIBIT 5	
ALBERT KOFSKY & JERRY SUTOW	
PHILIPSBURG # 1	
DECATUR TWP.	CLEARFIELD CO.
HESS & FISHER ENGINEERS, INC.	
CONSULTING ENGINEERS & GEOLOGISTS	
36 NORTH SECOND STREET	
CLEARFIELD, PA. 16830 814-765-7541	
DRAWN BY: <i>AF</i>	DATE: 7-23-82 FILE NO.: H-0173 B
CHECKED BY: _____	SCALE: 1" = 200' JOB NO.: 822+102
REG. NO. _____	F.B. NO. _____

SEAL SHEET 2 OF 2