



FINAL SURVEY
 SURVEYED
 NOTE BOOK
 TEMPLATE
 AREAS
 CHECKED

ORIGINAL SURVEY
 SURVEYED
 NOTE BOOK
 TEMPLATE
 AREAS
 CHECKED

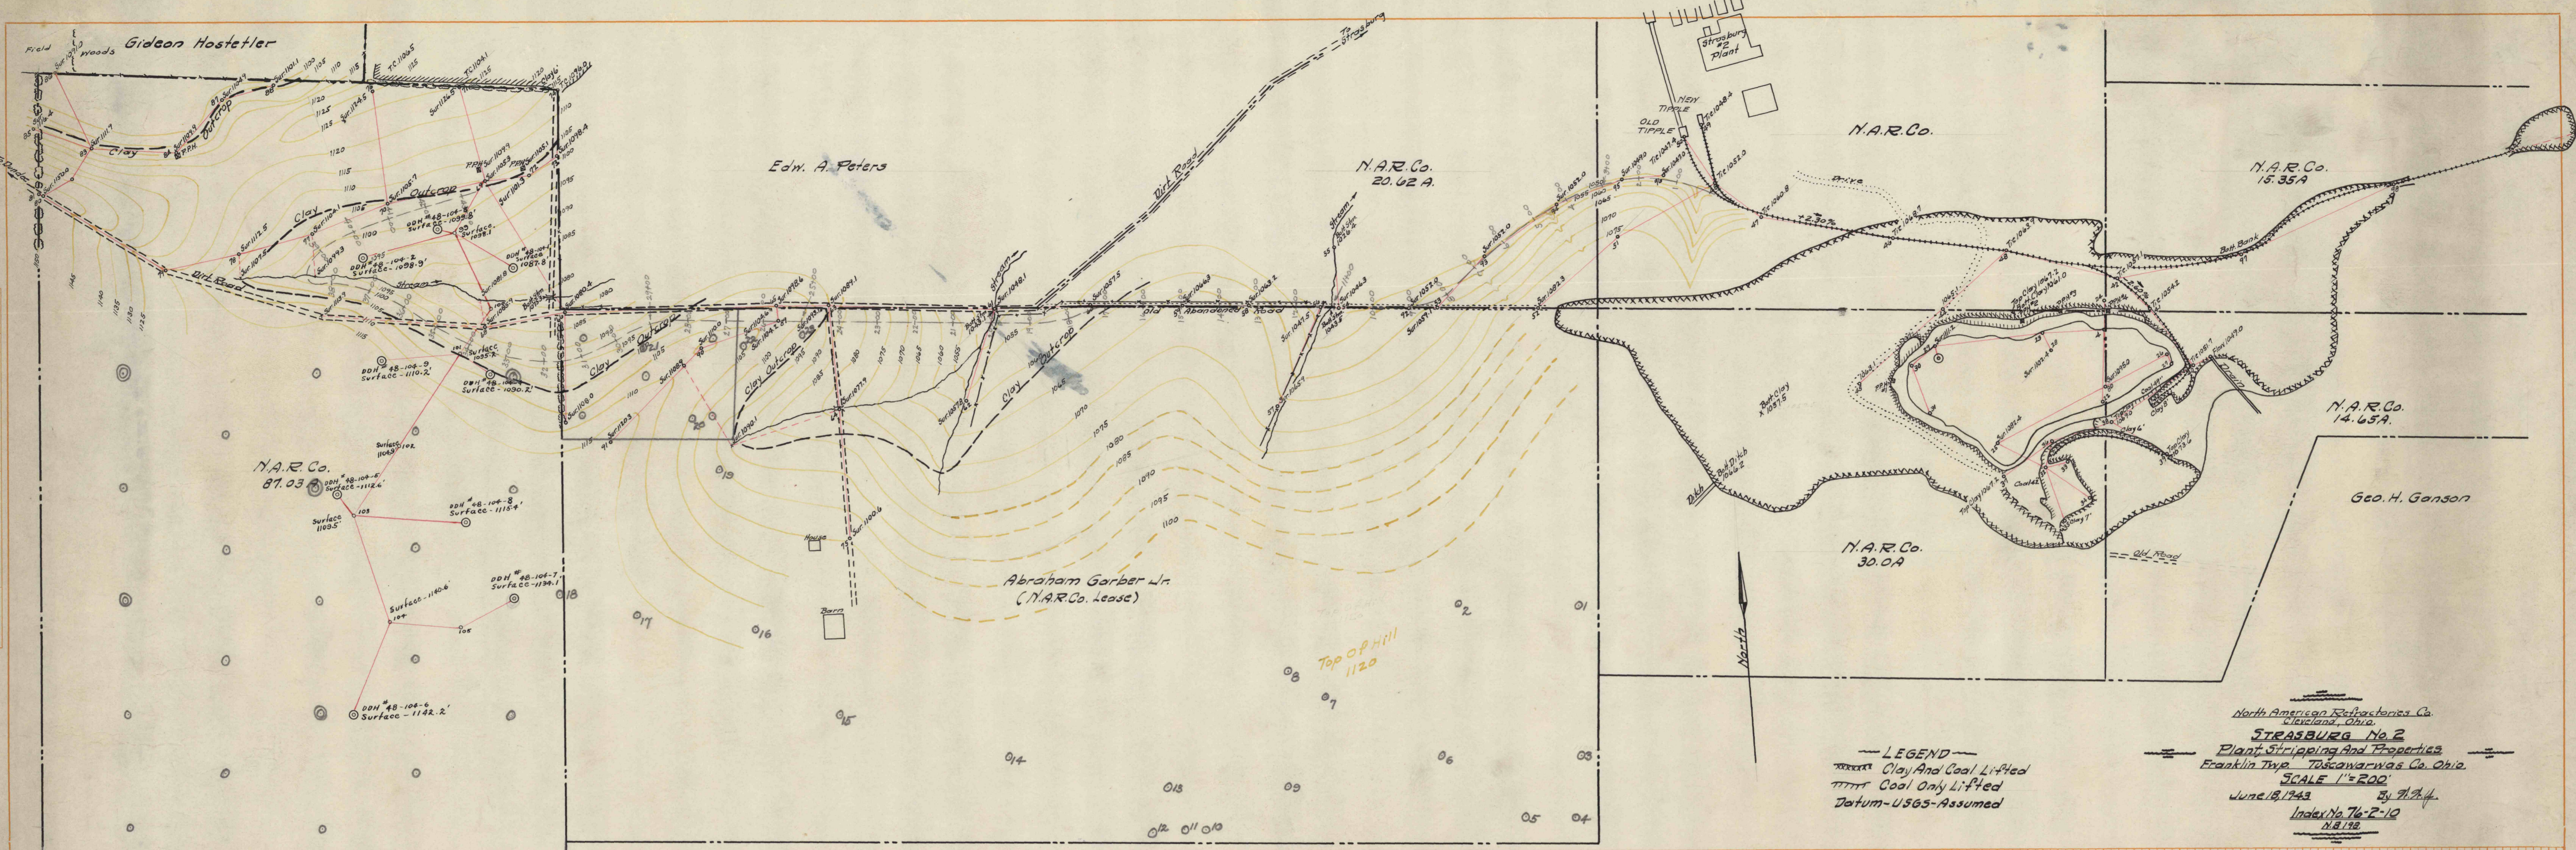

LEGEND
 Clay and Coal Lifted
 Coal Only Lifted
 Datum - USGS - Assumed

North American Refractories Co.
 Cleveland, Ohio
STRASBURG No. 2
 Plant, Stripping and Properties
 Franklin Twp. Tuscarawas Co. Ohio.
 SCALE 1" = 200'
 June 18, 1943 By A.H.H.
 Index No. 76-P-10
 11.8.1942

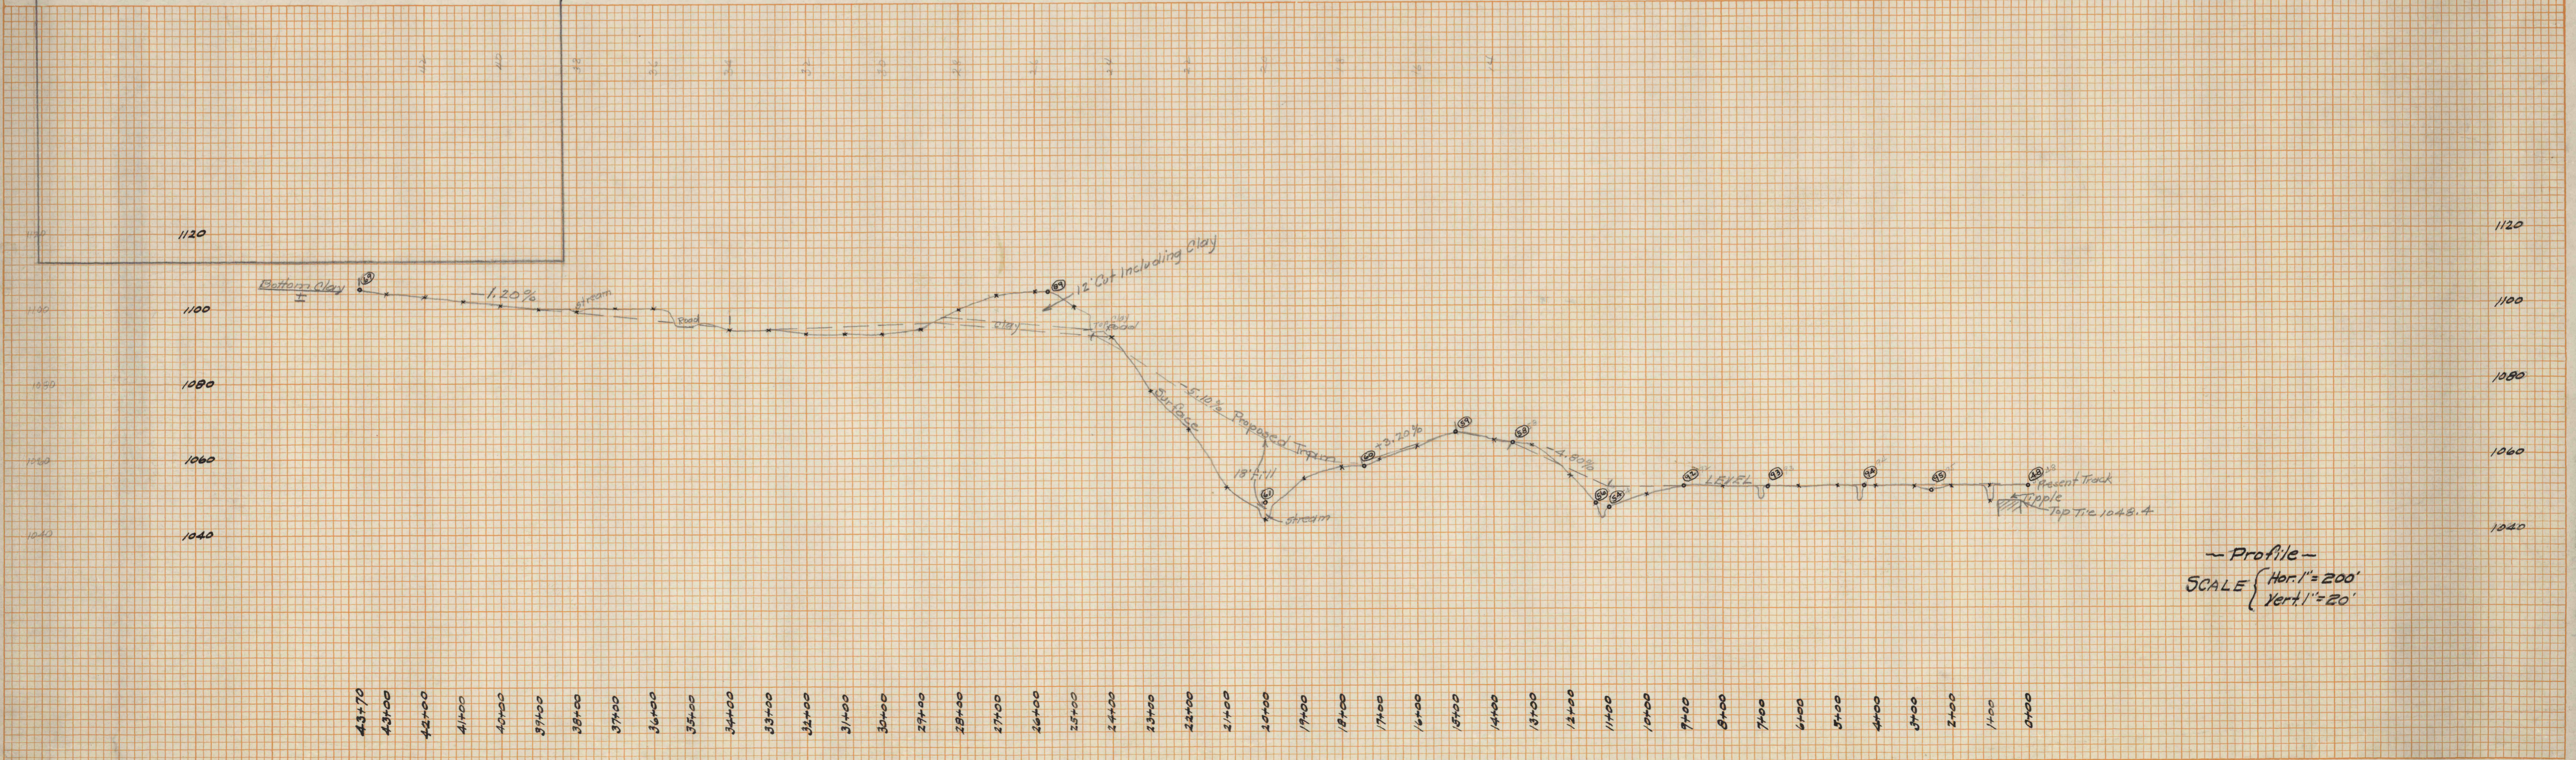

Profile
 SCALE { Hor. 1" = 200'
 Vert. 1" = 20'