


Philipsburg Coal & Land Company

Philipsburg Coal & Land Company

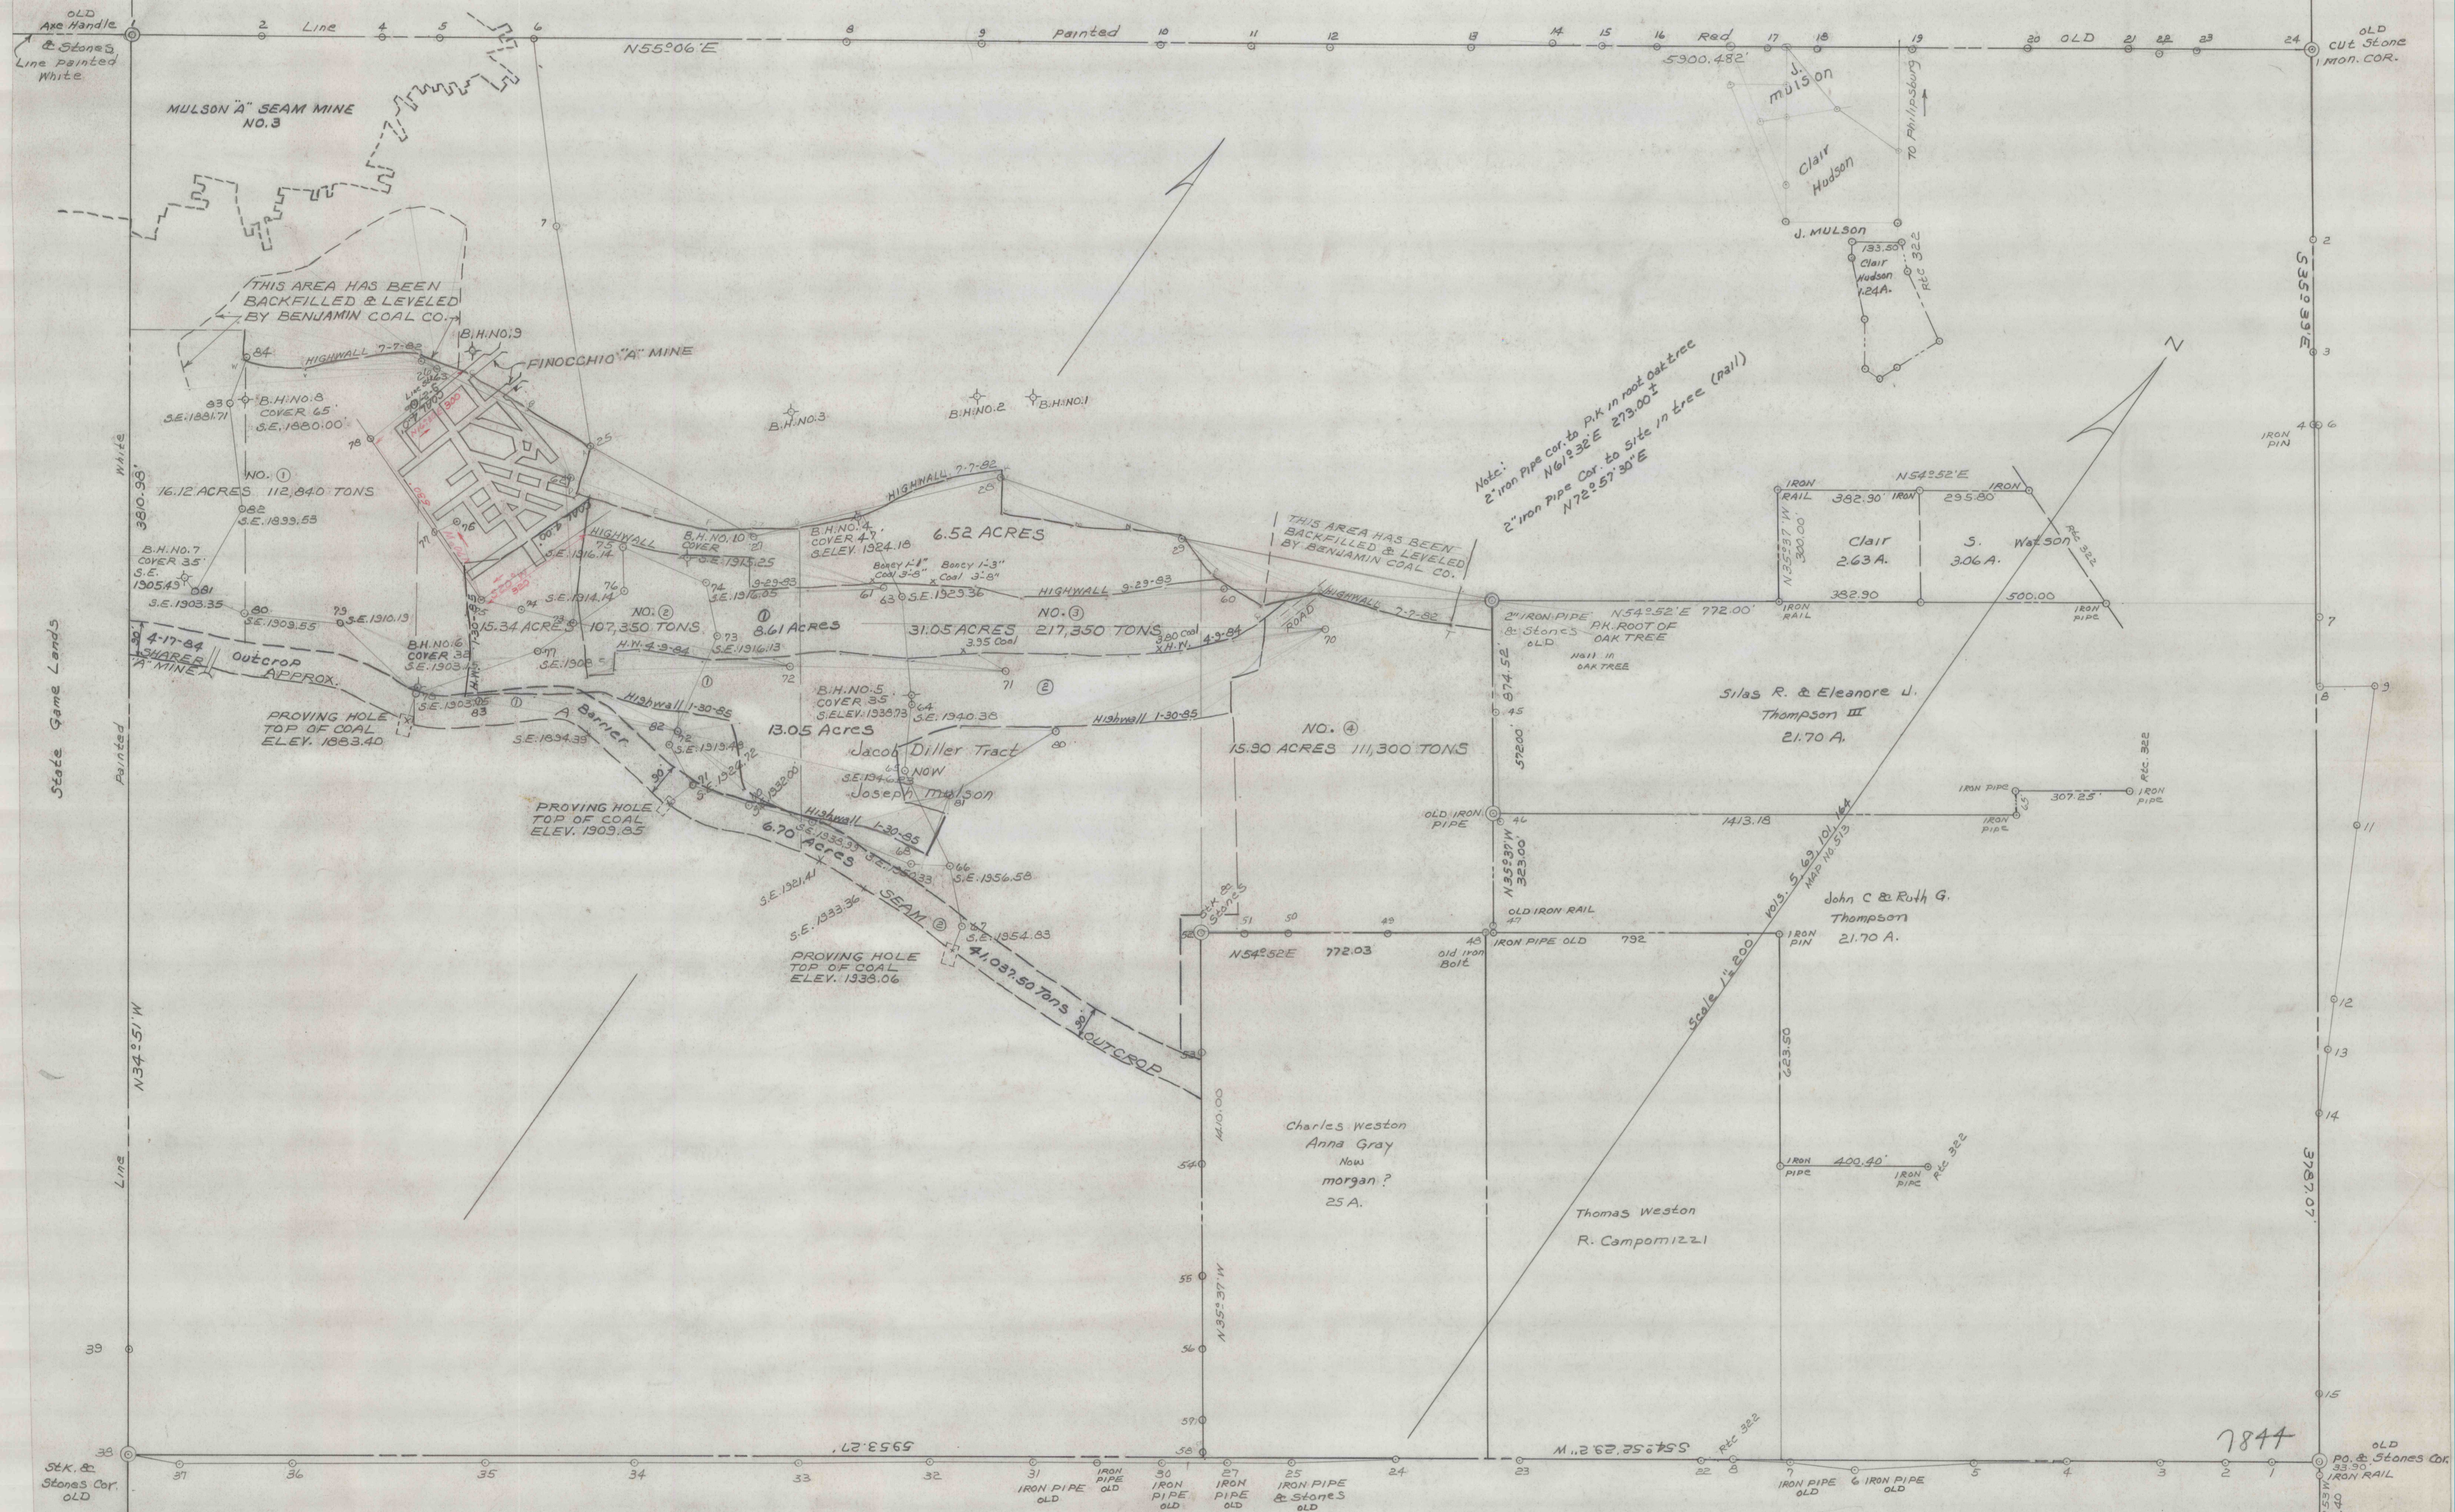

Note:  
 2" Iron Pipe cor. to P.K. in root oak tree  
 N61°32'E 273.00'  
 2" Iron Pipe Cor. to Site in tree (rail)  
 N72°57'30"E

Scale 1" = 200'

PMD

7844

BWD

BWD  
481