


ORVIS ESTATE
 TOTAL COAL AREA - 443 ACRES
 LESS RUSTY CROP - 413
 TOTAL GOOD COAL - 30

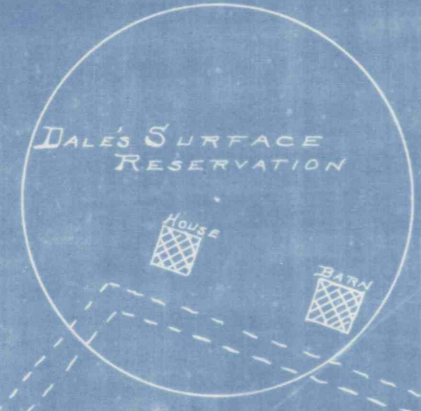

PHILIPSBURG LAND COAL CO.

TOTAL COAL AREA - 443 ACRES
 LESS RUSTY CROP - 413
 TOTAL GOOD COAL - 30

MAP
 OF
Eureka No. 21 Mine
 OPERATED BY
BERWIND WHITE COAL MINING CO.
 AT
OSCEOLA
 CENTRE CO. PA

Scale - 1" = 200'
 HOUTSDALE, PA, MAR 24, '97
 OCT 15 '97