

HALE SWAN (surf)  
C.B.C. CORP. (Coal)


**ELBA COAL CO.**  
MADERA, PA.

MAP OF STRIPPING MINES  
JORDAN TWP, CLFD. CO., PA.

SCALE 1" = 200'

CLEARFIELD, PA.  
MAR. 10, 1949

ROY C. KINDIG  
REG. ENGR.

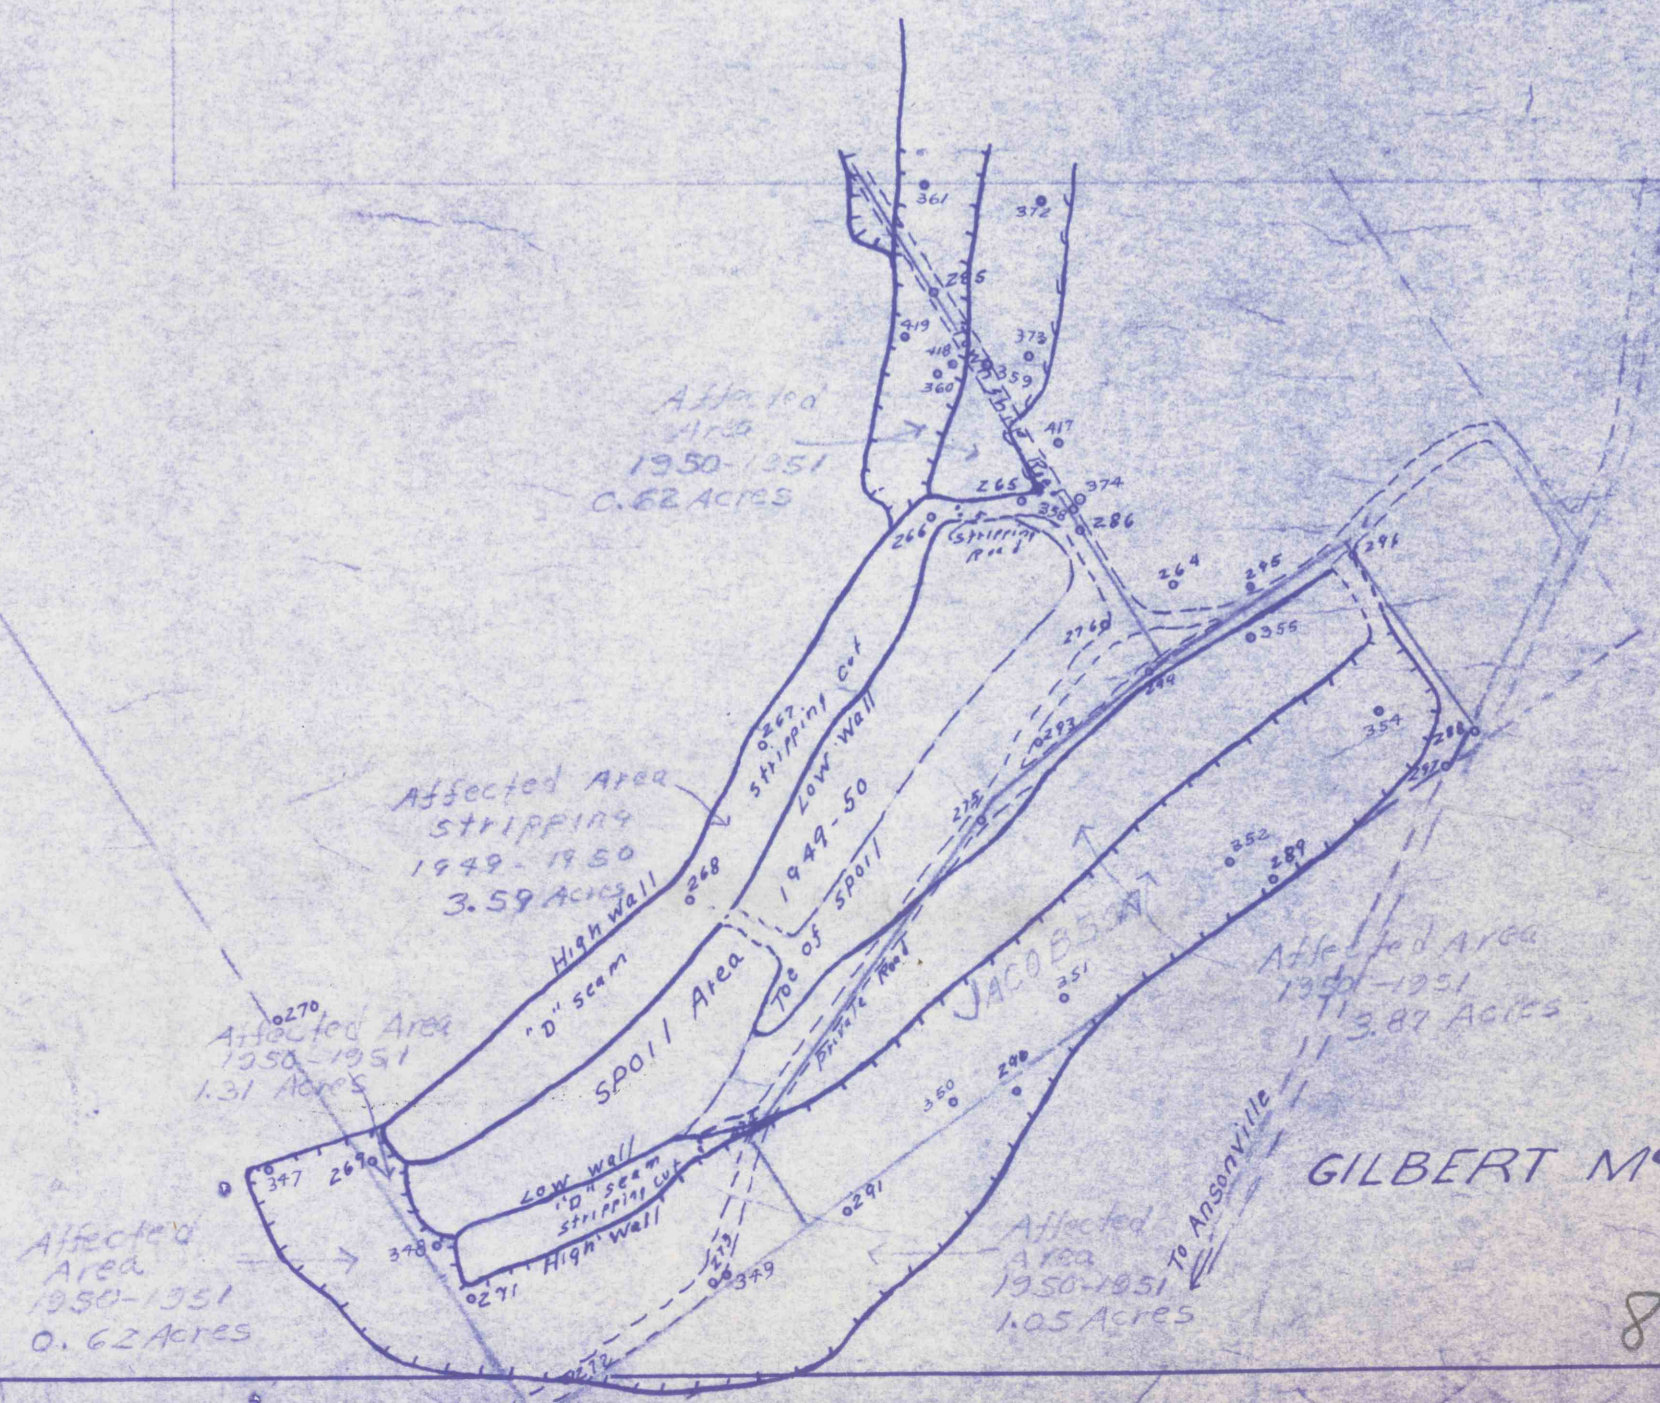

GILBERT MCGARVEY

8156