


INDEX TO SURVEYS			
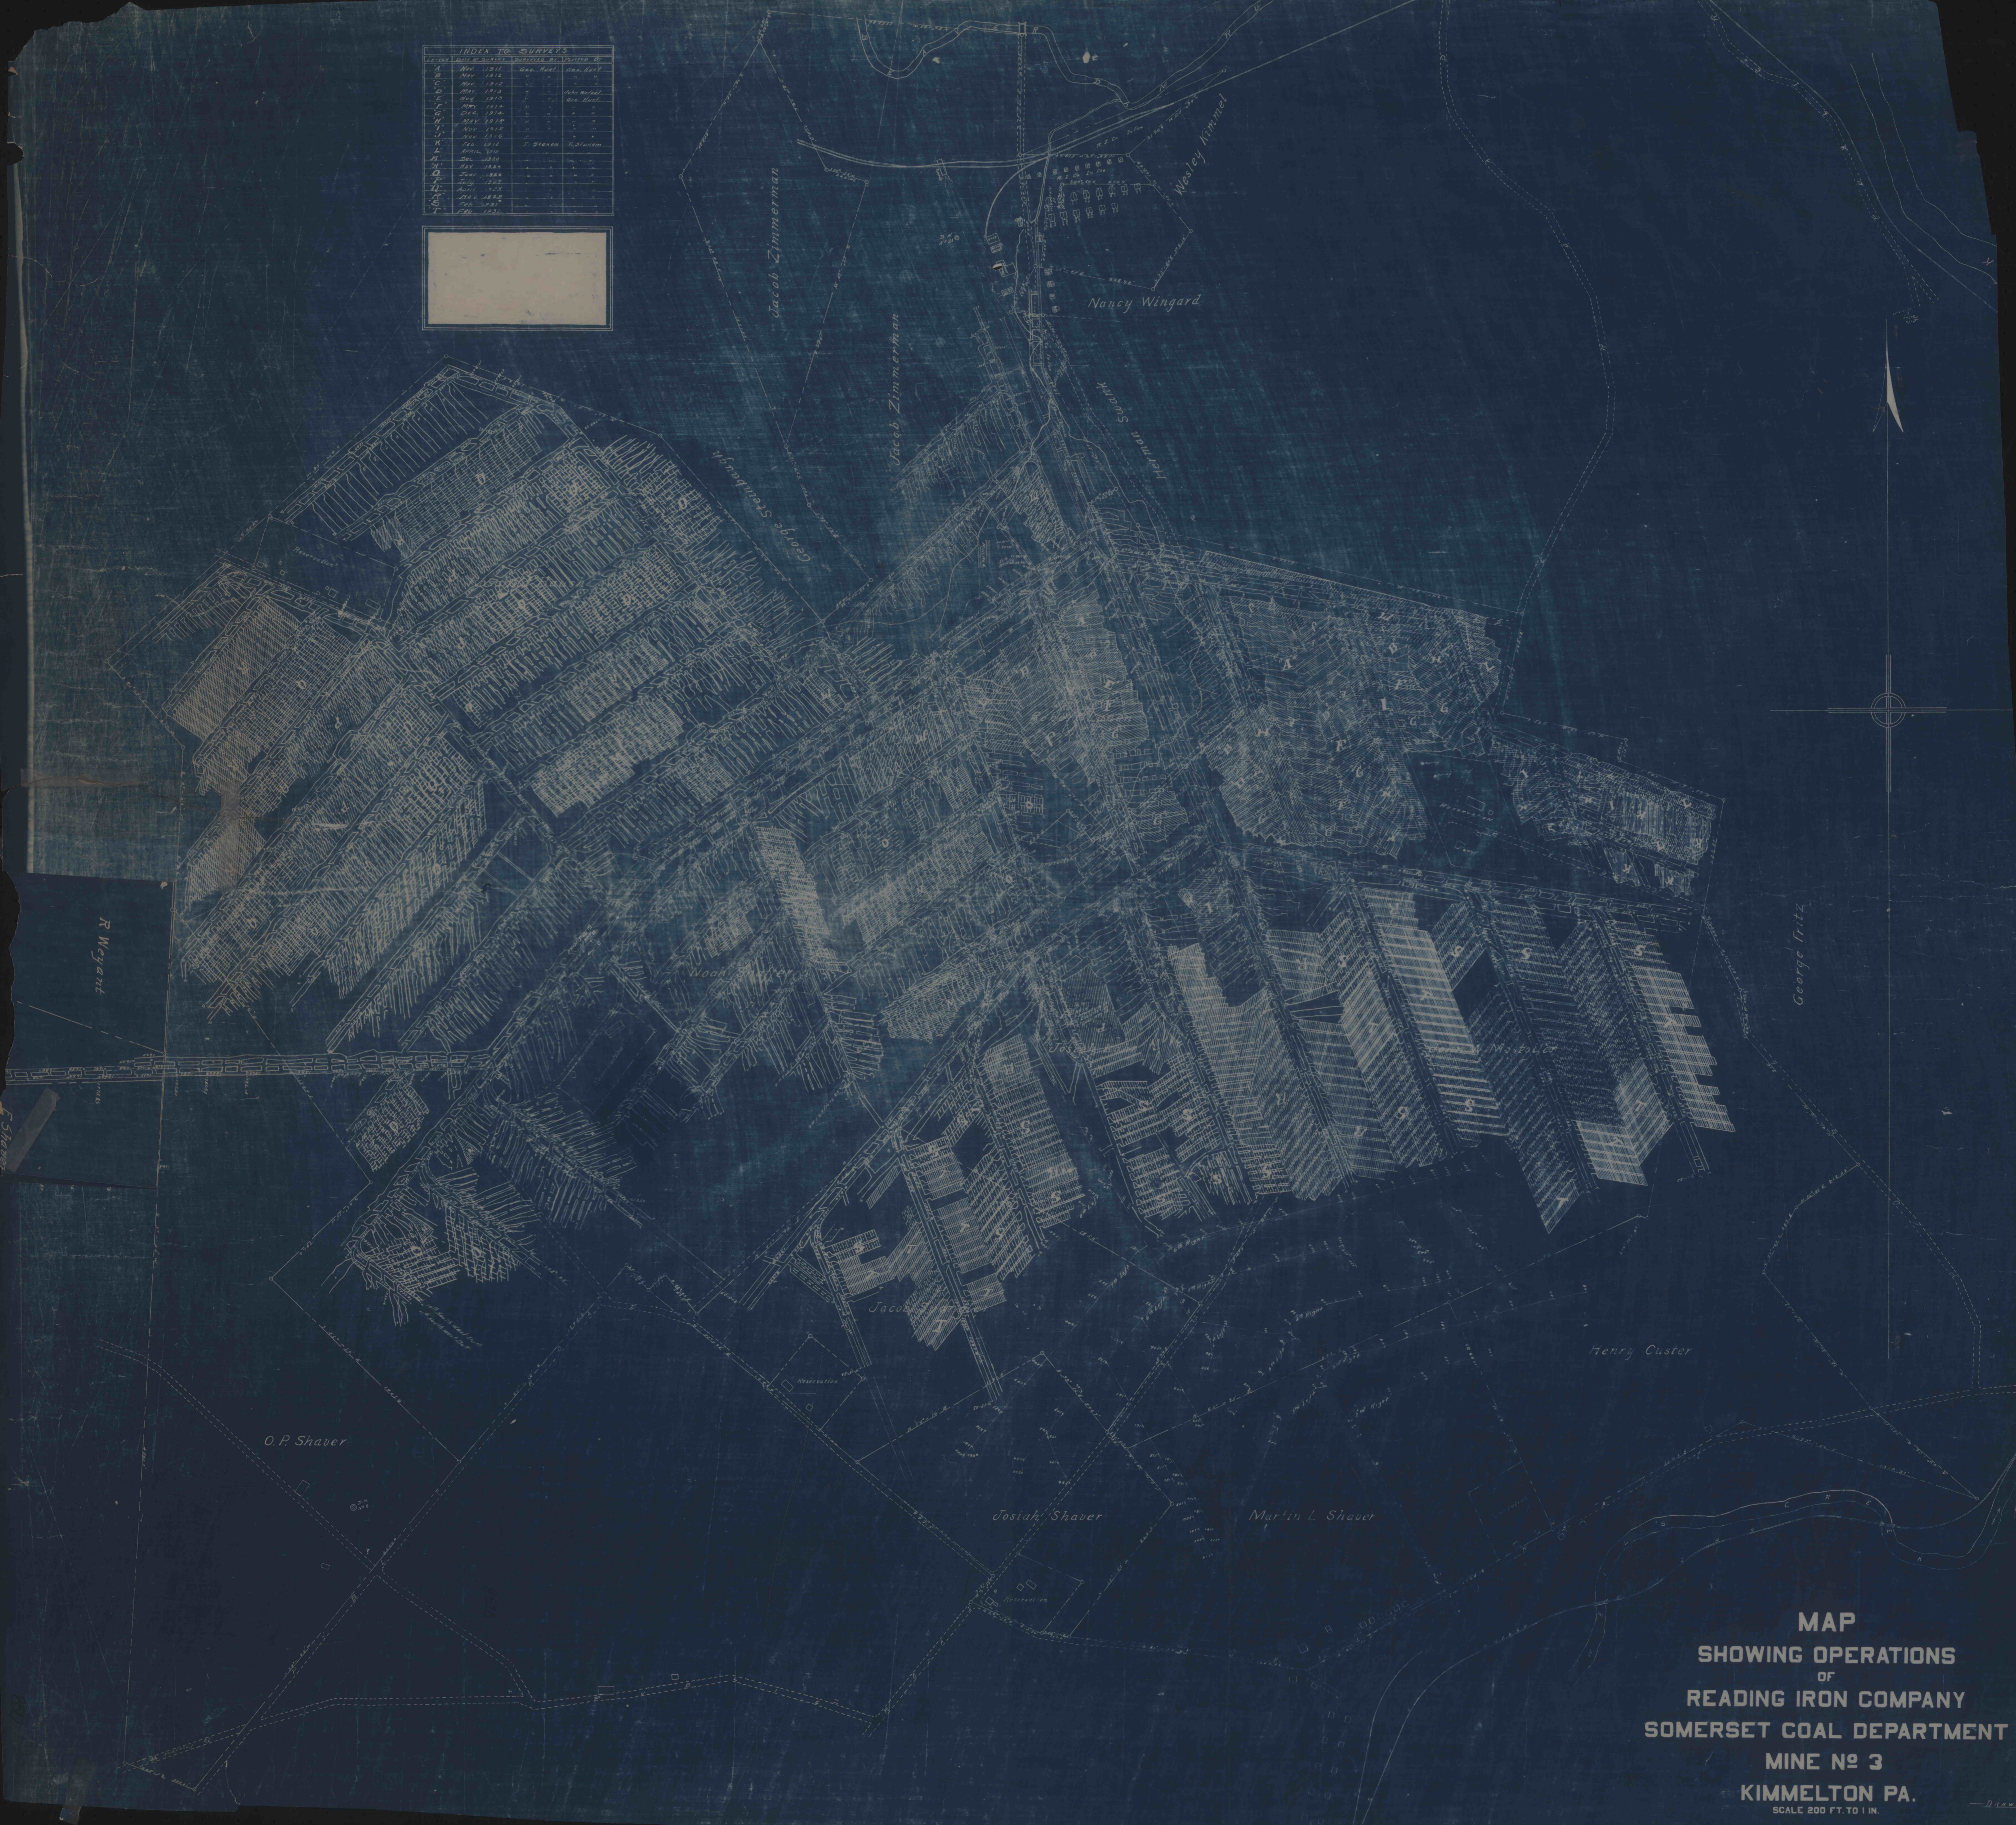

MAP
SHOWING OPERATIONS
OF
READING IRON COMPANY
SOMERSET COAL DEPARTMENT
MINE No 3
KIMMELTON PA.
 SCALE 200 FT. TO 1 IN.