


8585  
8584  
8584

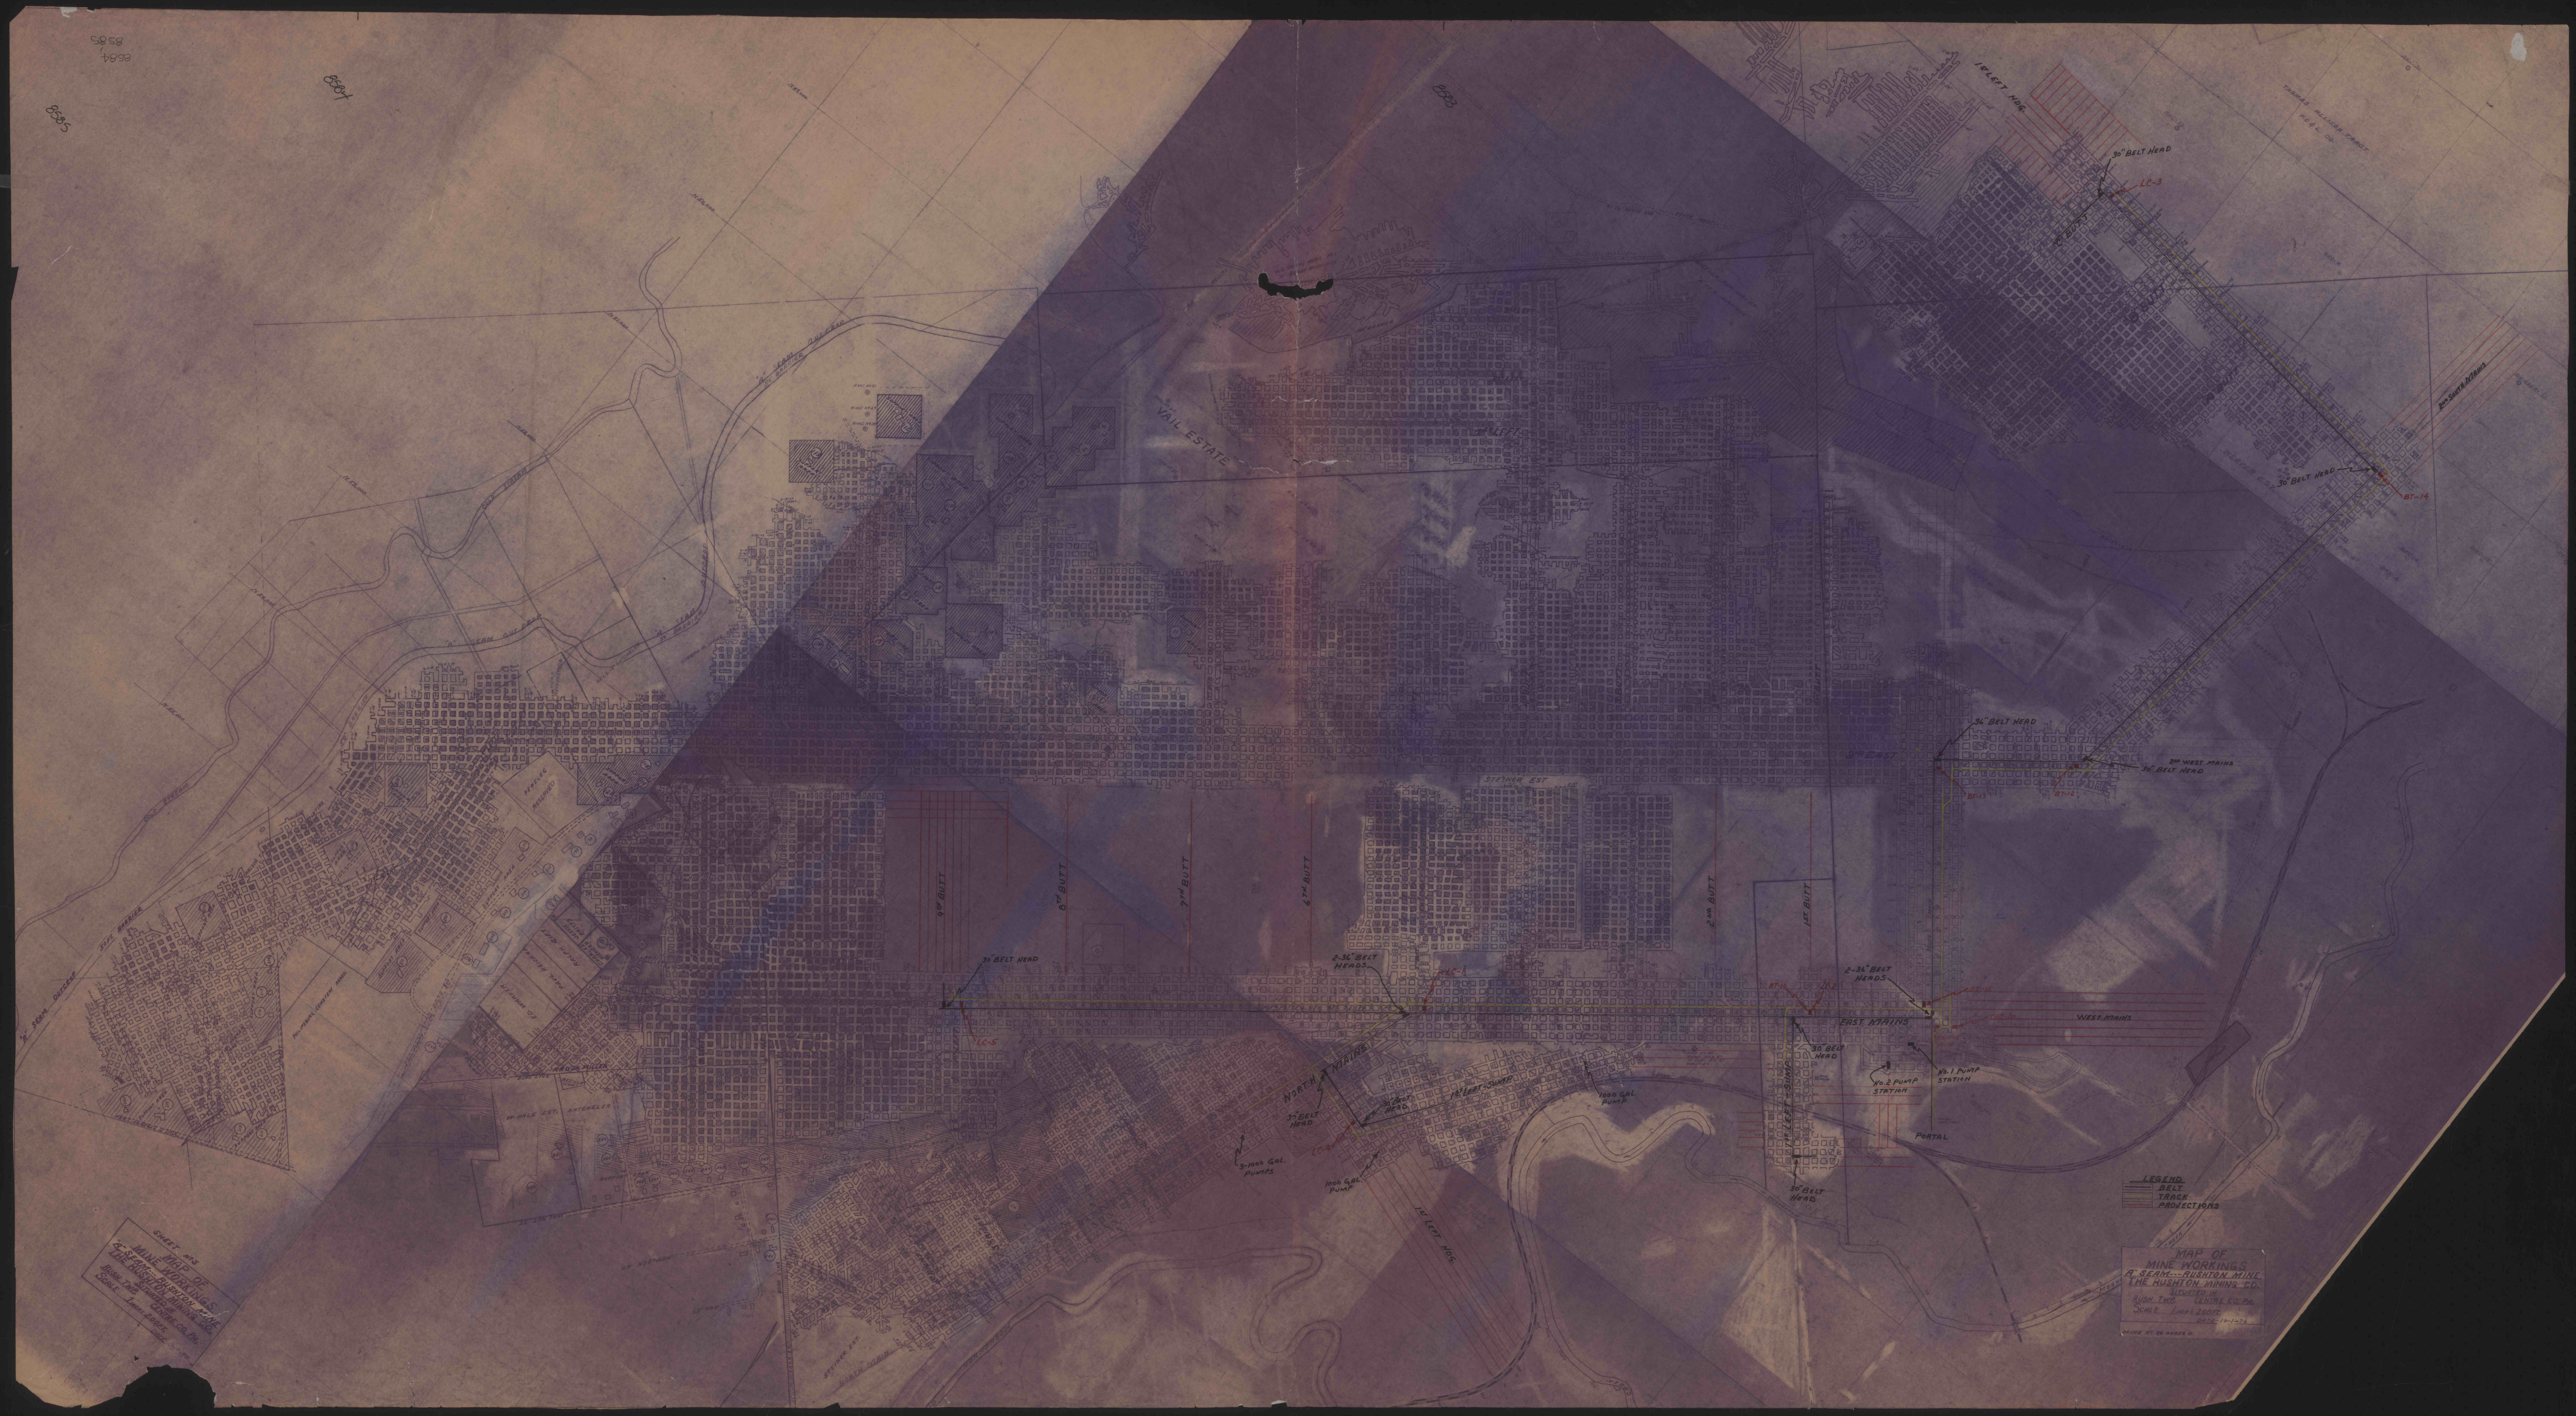

SHEET NO. 2  
MINE WORKINGS  
A SEAM - RUSHTON MINE  
THE RUSHTON MINING CO.  
SCALE 1" = 200'

LEGEND  
BELT  
TRACK  
PROJECTIONS

MAP OF  
MINE WORKINGS  
A SEAM - RUSHTON MINE  
THE RUSHTON MINING CO.  
RUSHTON, CENTRE CO. PA.  
SCALE 1" = 200'  
MAY 1924