


151

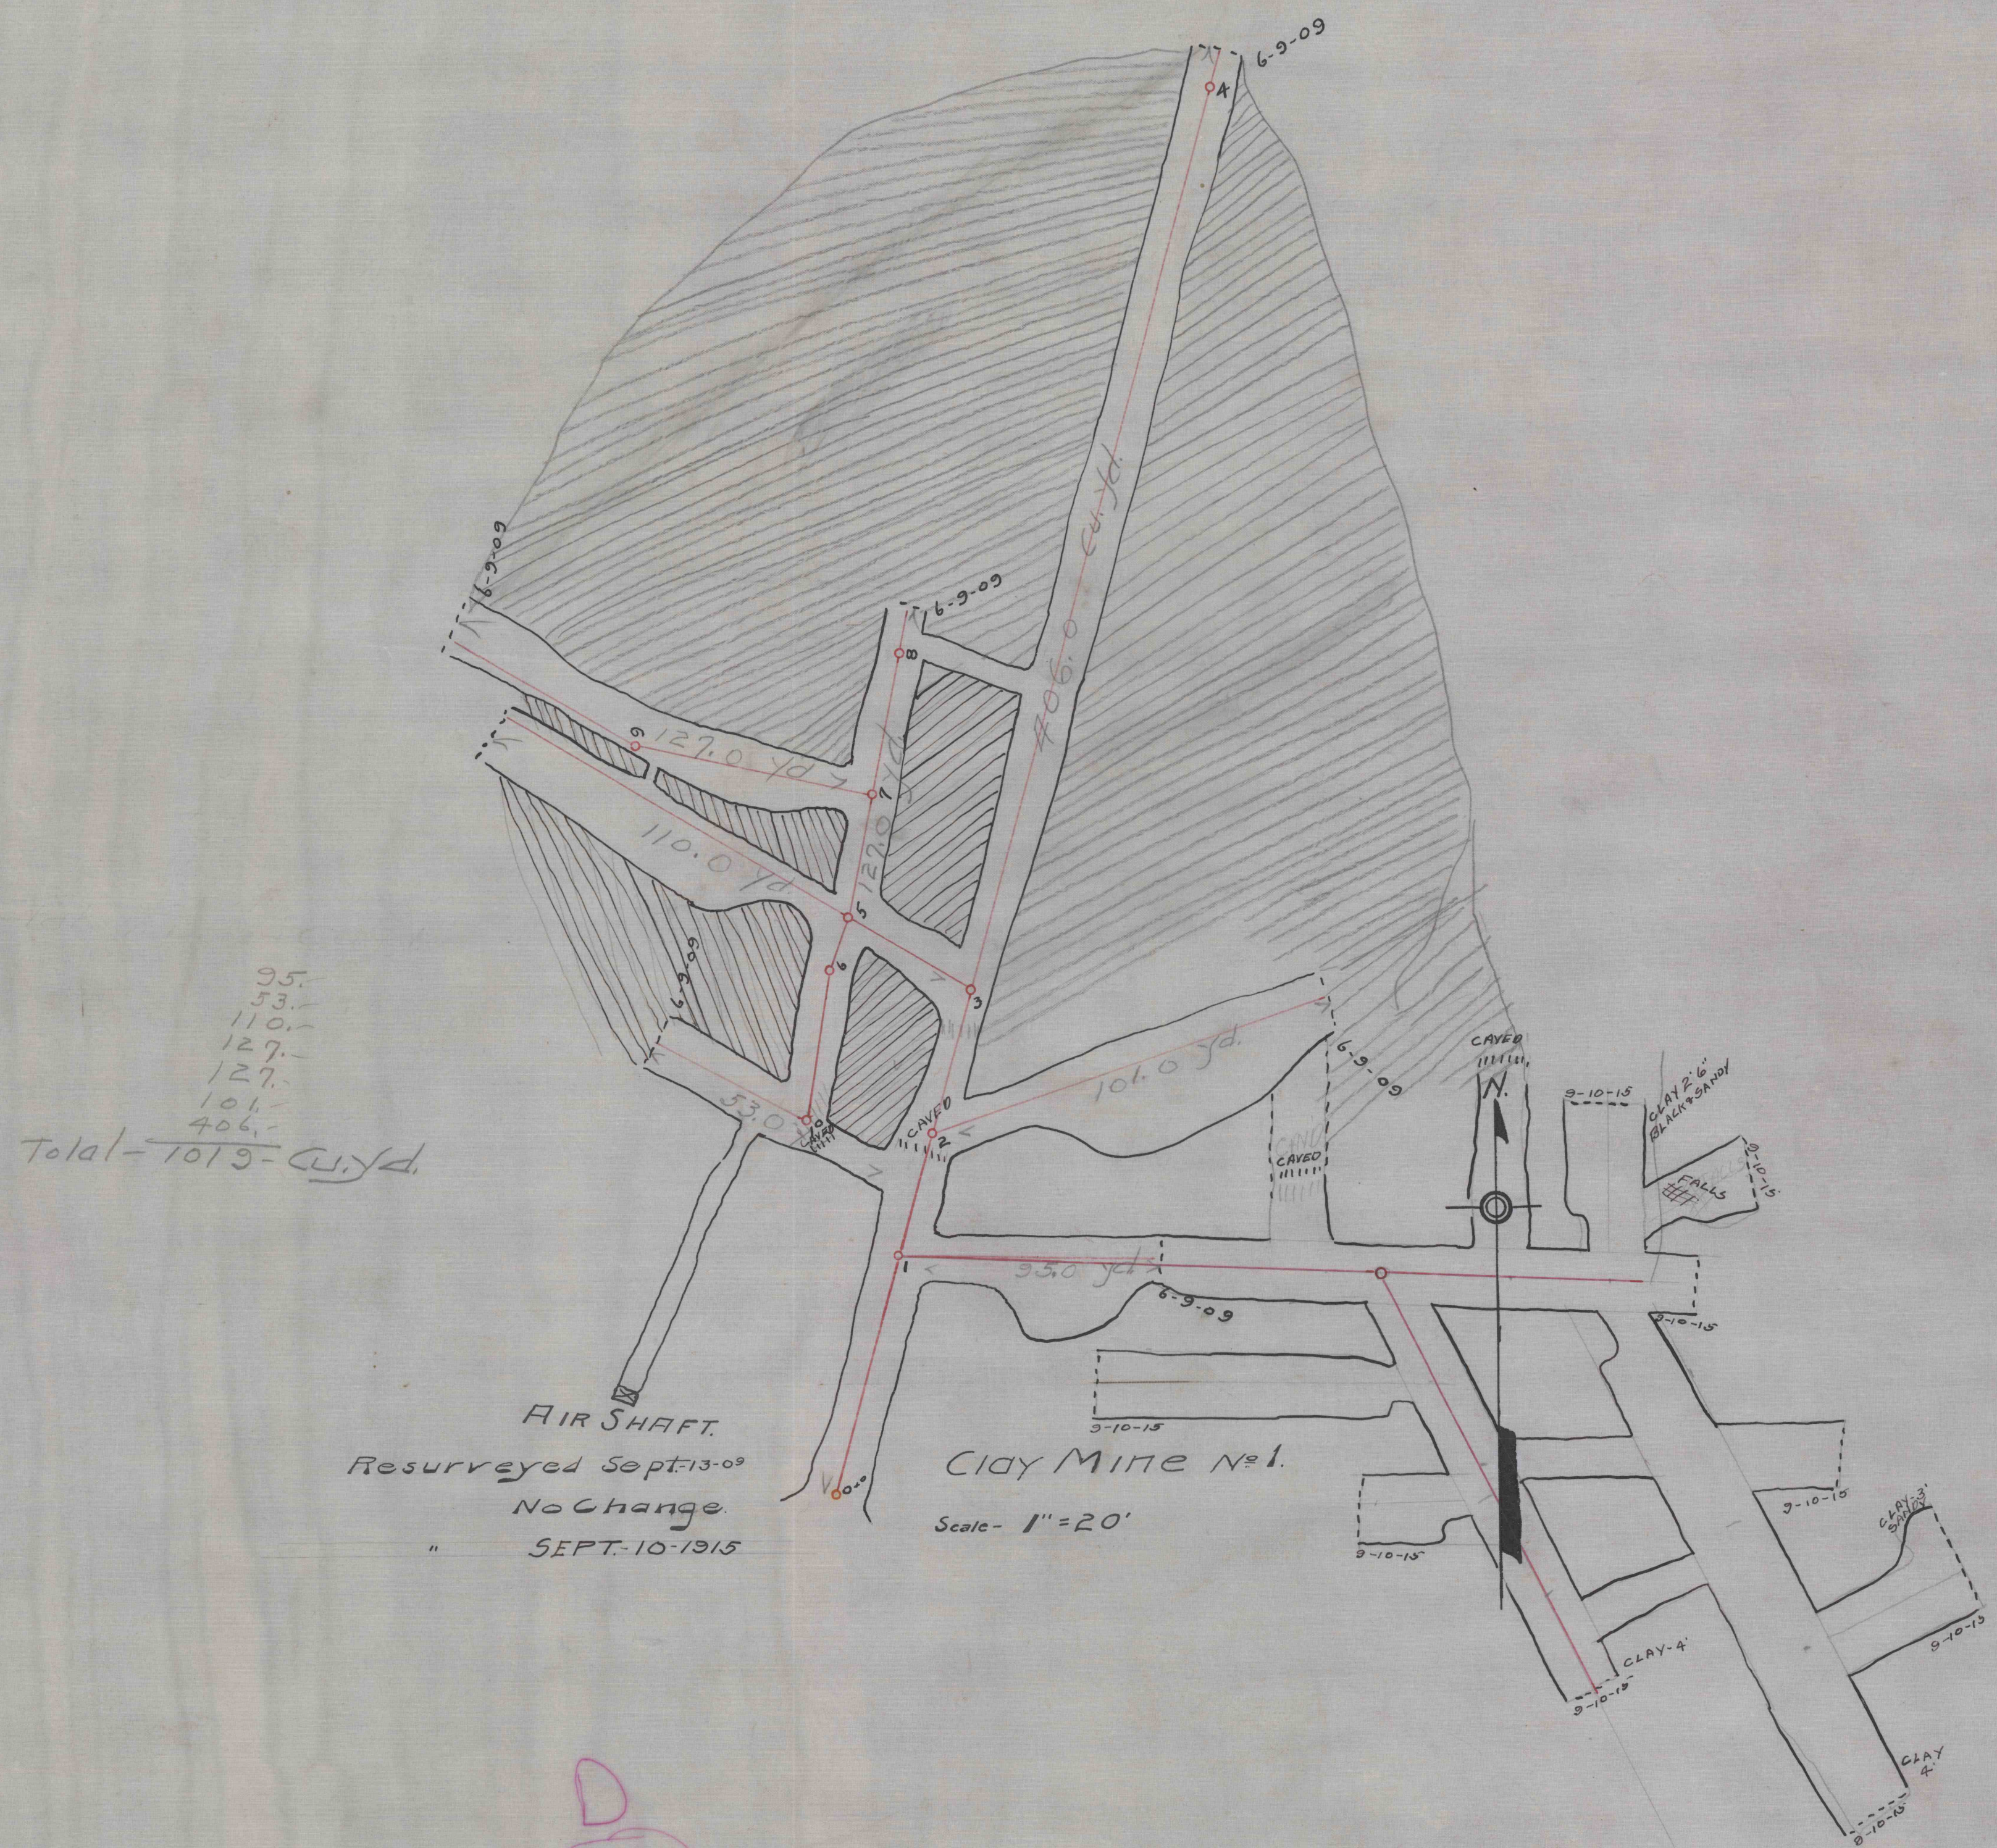

95.
53.
110.
127.
101.
406.
Total - 1019 - Cu. yd.

AIR SHAFT.
Resurveyed Sept. 13-09
No Change
SEPT. 10-1915

CLAY MINE No. 1.
Scale - 1" = 20'

D
970

1677

93.50
125