

Worings of No. 1 Mine

Air Shaft

El. 1200.5

El. 1194.0

Air Shaft

SURF. EL. 1210.0
Clay 1169.5

COURSE N 67° 53' E of Proposed No. 2 Opening

Radius 100'

LOADS


PISTLES

El. 1181.1 C. 2.6
3+50
El. 1185.7 C. 15.5
3+50
El. 1190.0 Surf. 69.4 Sub Grade
3+97
C. 2.7 Below Sub Grade

Nov. 22-09
DEC. 30-09.

Map Showing Clay Mine No. 2,
Paterson Clay Products Company,
Clearfield Pa. Office of E.W. Hess,
Engineer

Scale 1"=20'

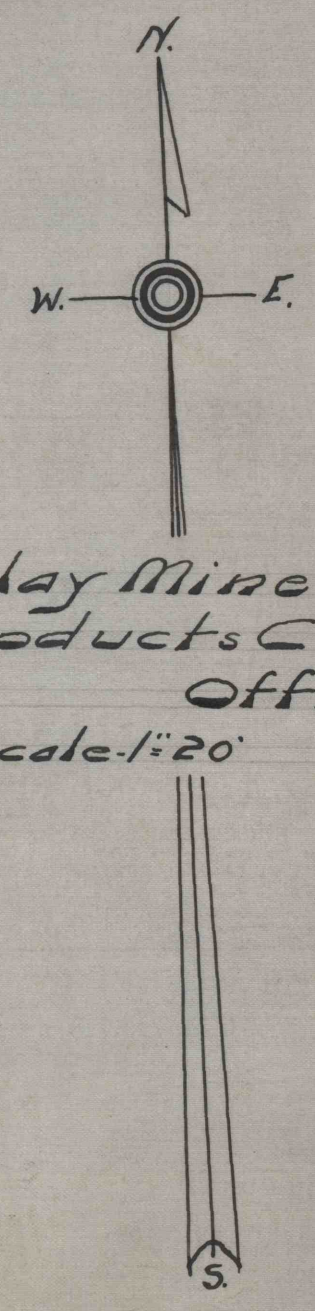

987

2017