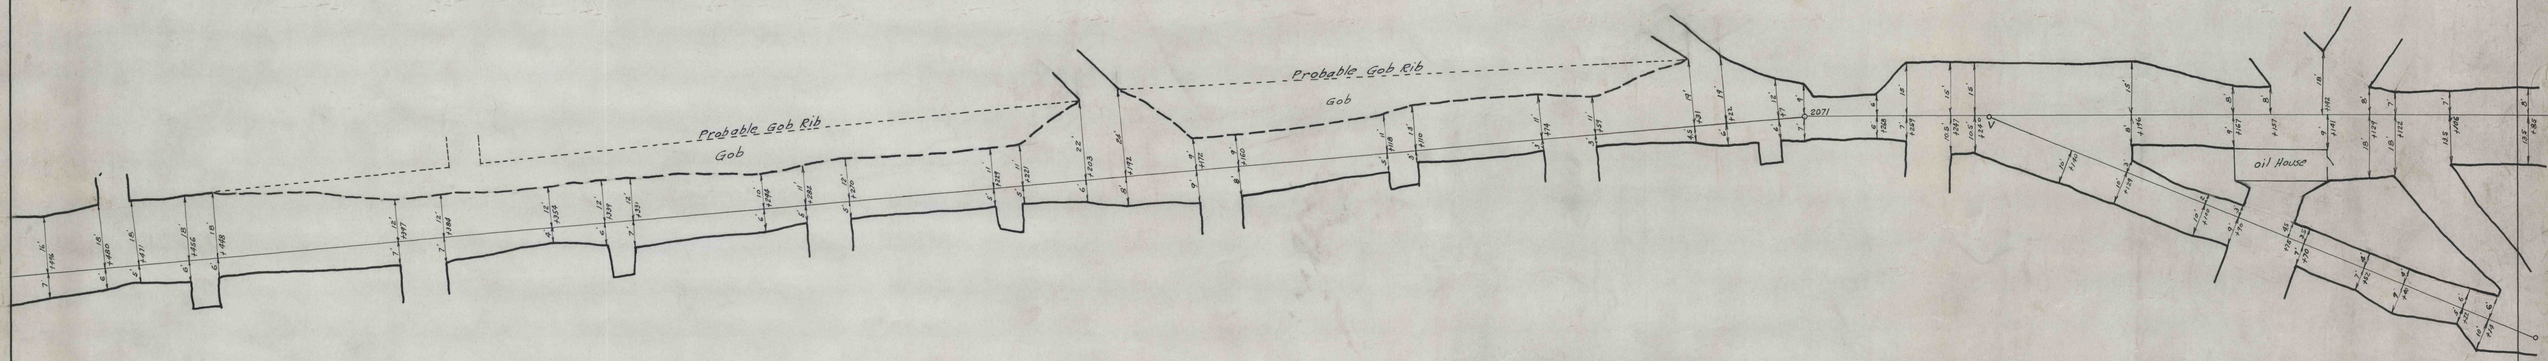

	NAME	DATE
DRAWN BY	G.M.R.	9-23-44
TRACED BY	G.M.R.	9-23-44
CHECKED BY		

EASTERN GAS & FUEL ASSOCIATES
KOPPERS COAL DIVISION
SONMAN, PA.

SCALE 1"=20' 9-23-44

G-50

SHEET 3 OF 3