

MILLARD BLOOM HARBISON-WALKER CLAY

G.B. CALDWELL

ROAD TO CURWENSVILLE →


D
 GEORGE S. GOOD
 FIRE BRICK CO.
 LUMBER CITY, CLEARFIELD, CO. PA.
 MAP SHOWING LINES AS
 CLAIMED BY I. J. GUPPY.
 SCALE 1" = 20'
 E. W. HESS, ENGINEER.
 MAR. 9 1914.

826A

2642
18
472
154
800
4086 TON

3054

ROSS

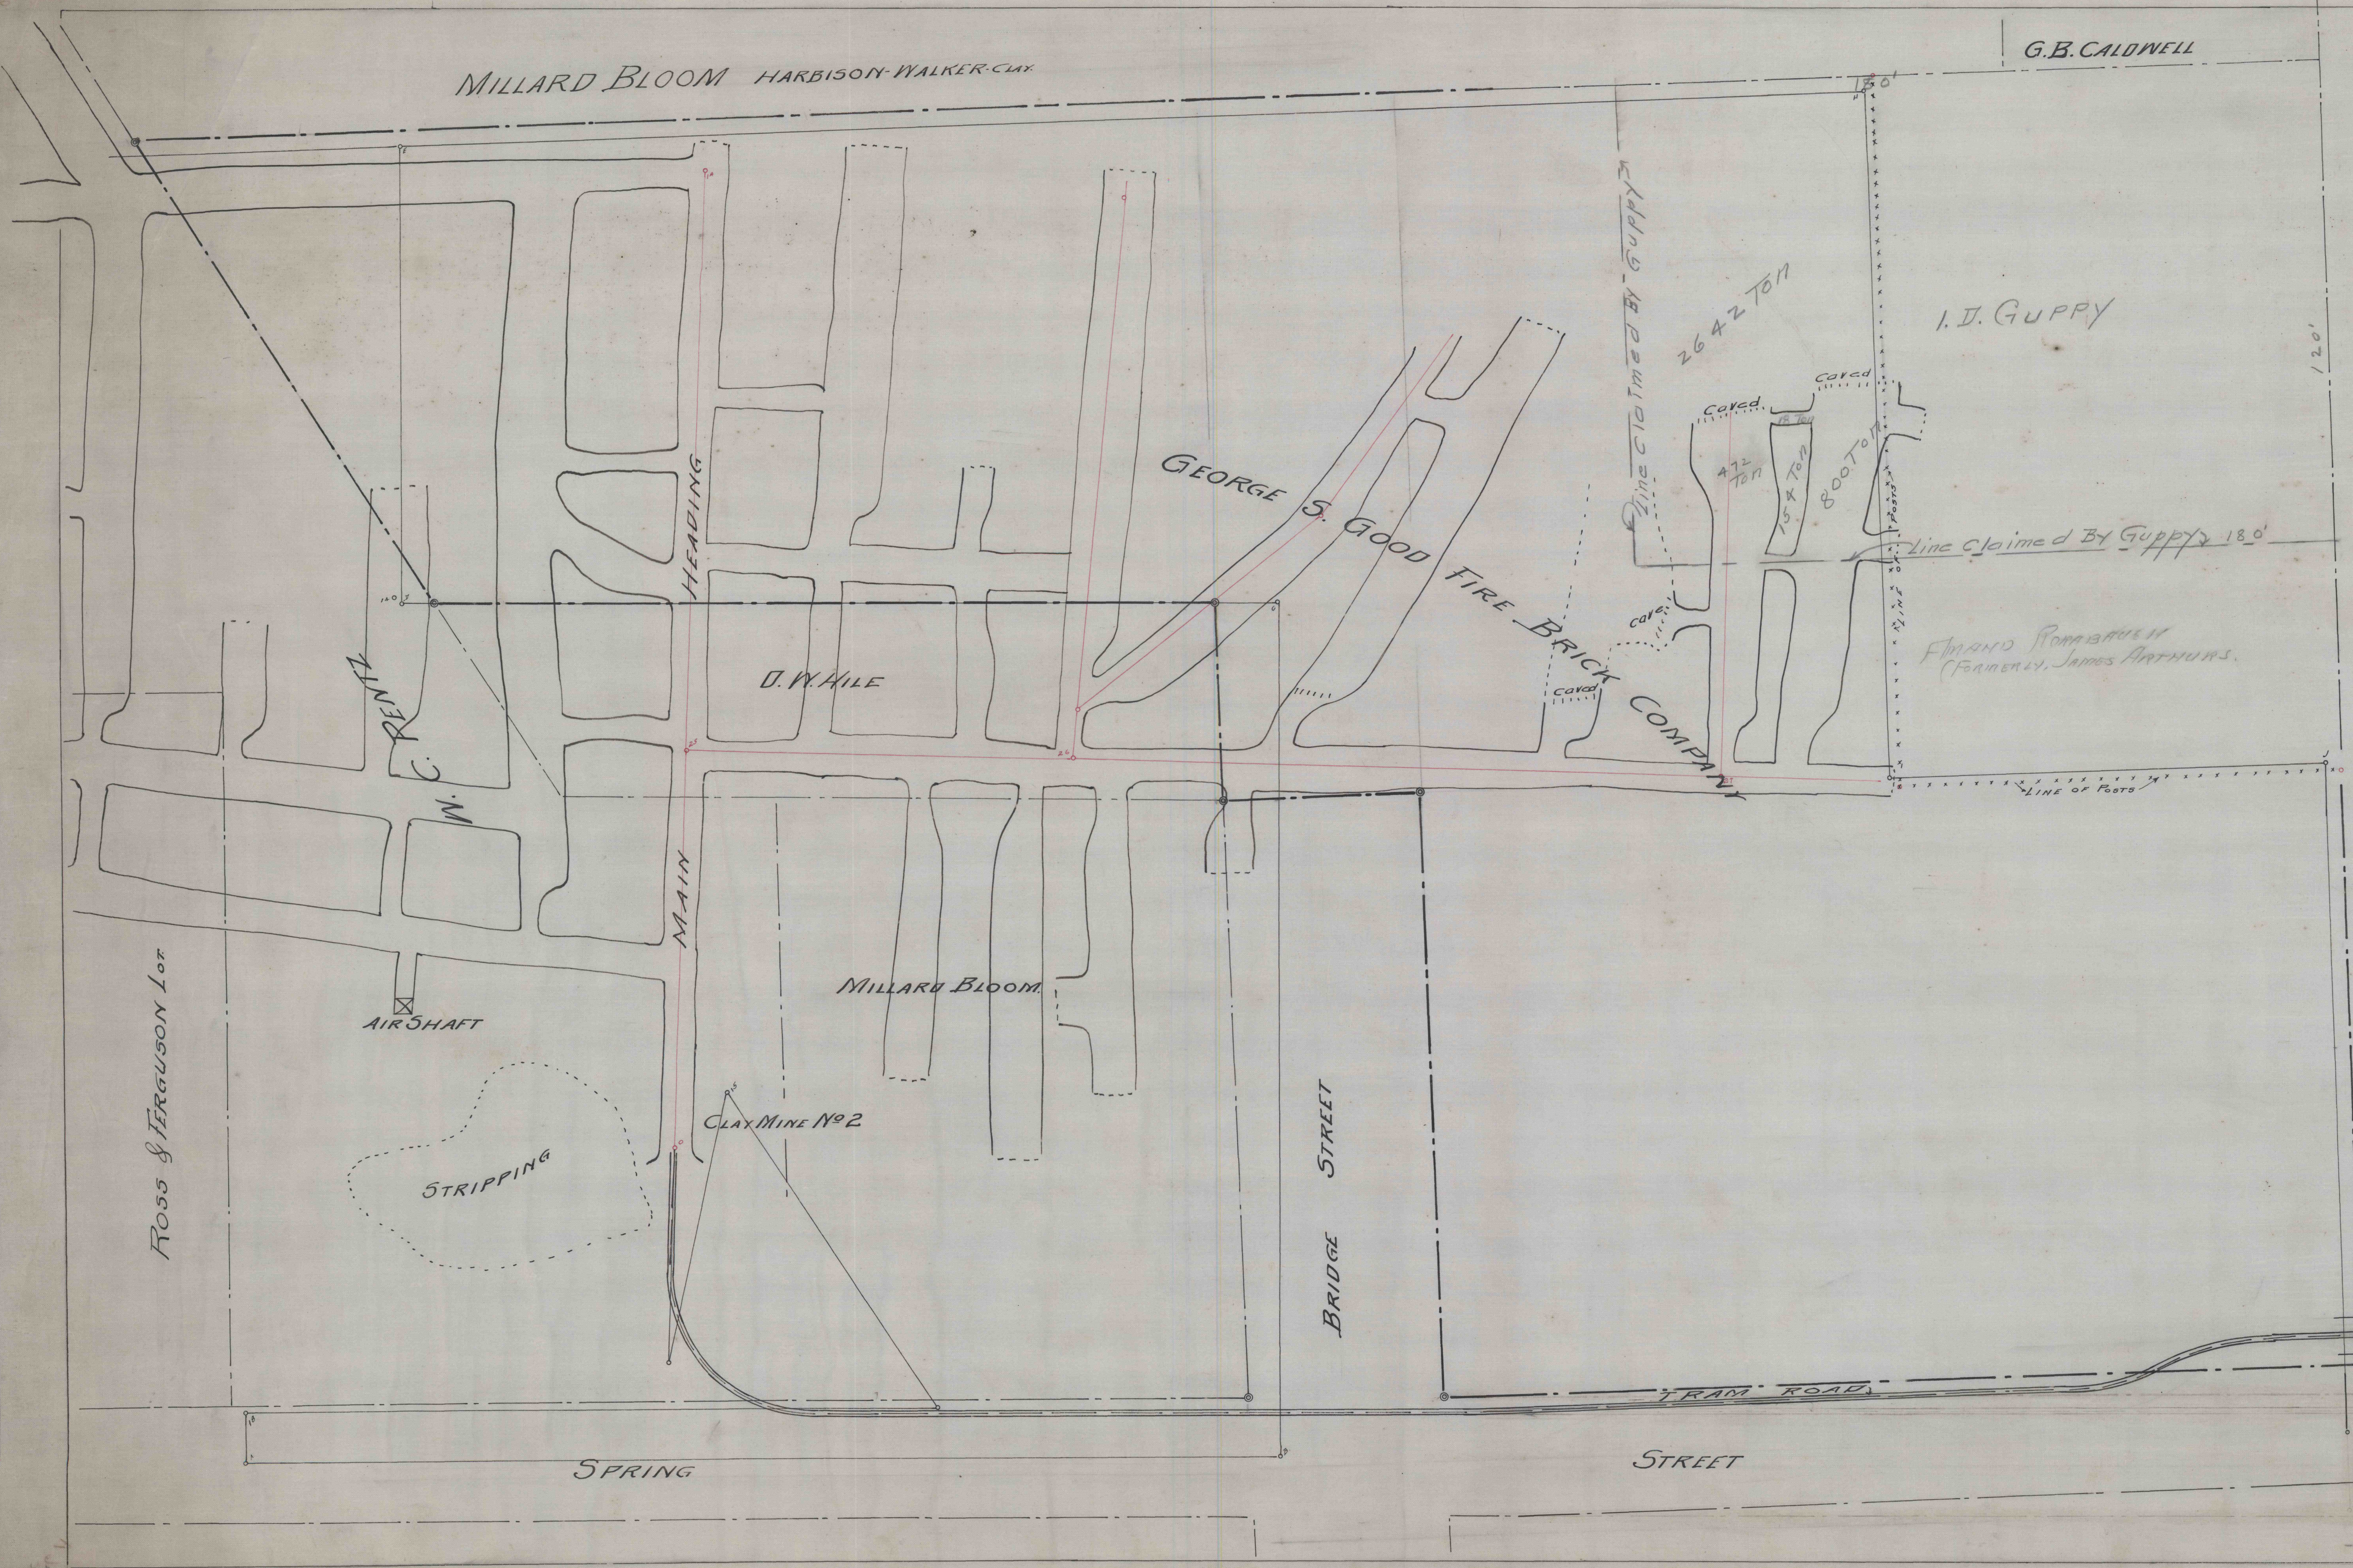

Line claimed by Guppy

2642 TON

I. J. GUPPY

472 TON

Caved

Caved

800 TON

Line claimed by Guppy 180'

FERNAND ROMANUELY
(FORMERLY, JAMES ARTHURS)

LINE OF POSTS

HEADING

D. W. HALE

GEORGE S. GOOD
FIRE BRICK COMPANY

MILLARD BLOOM

ROSS & FERGUSON LOT

AIR SHAFT

STRIPPING

CLAY MINE No 2

BRIDGE STREET

TRAM ROAD

STREET

SPRING

TIPPLE