


HUGH LEAVY ESTATE



"The James Hudson Mine"

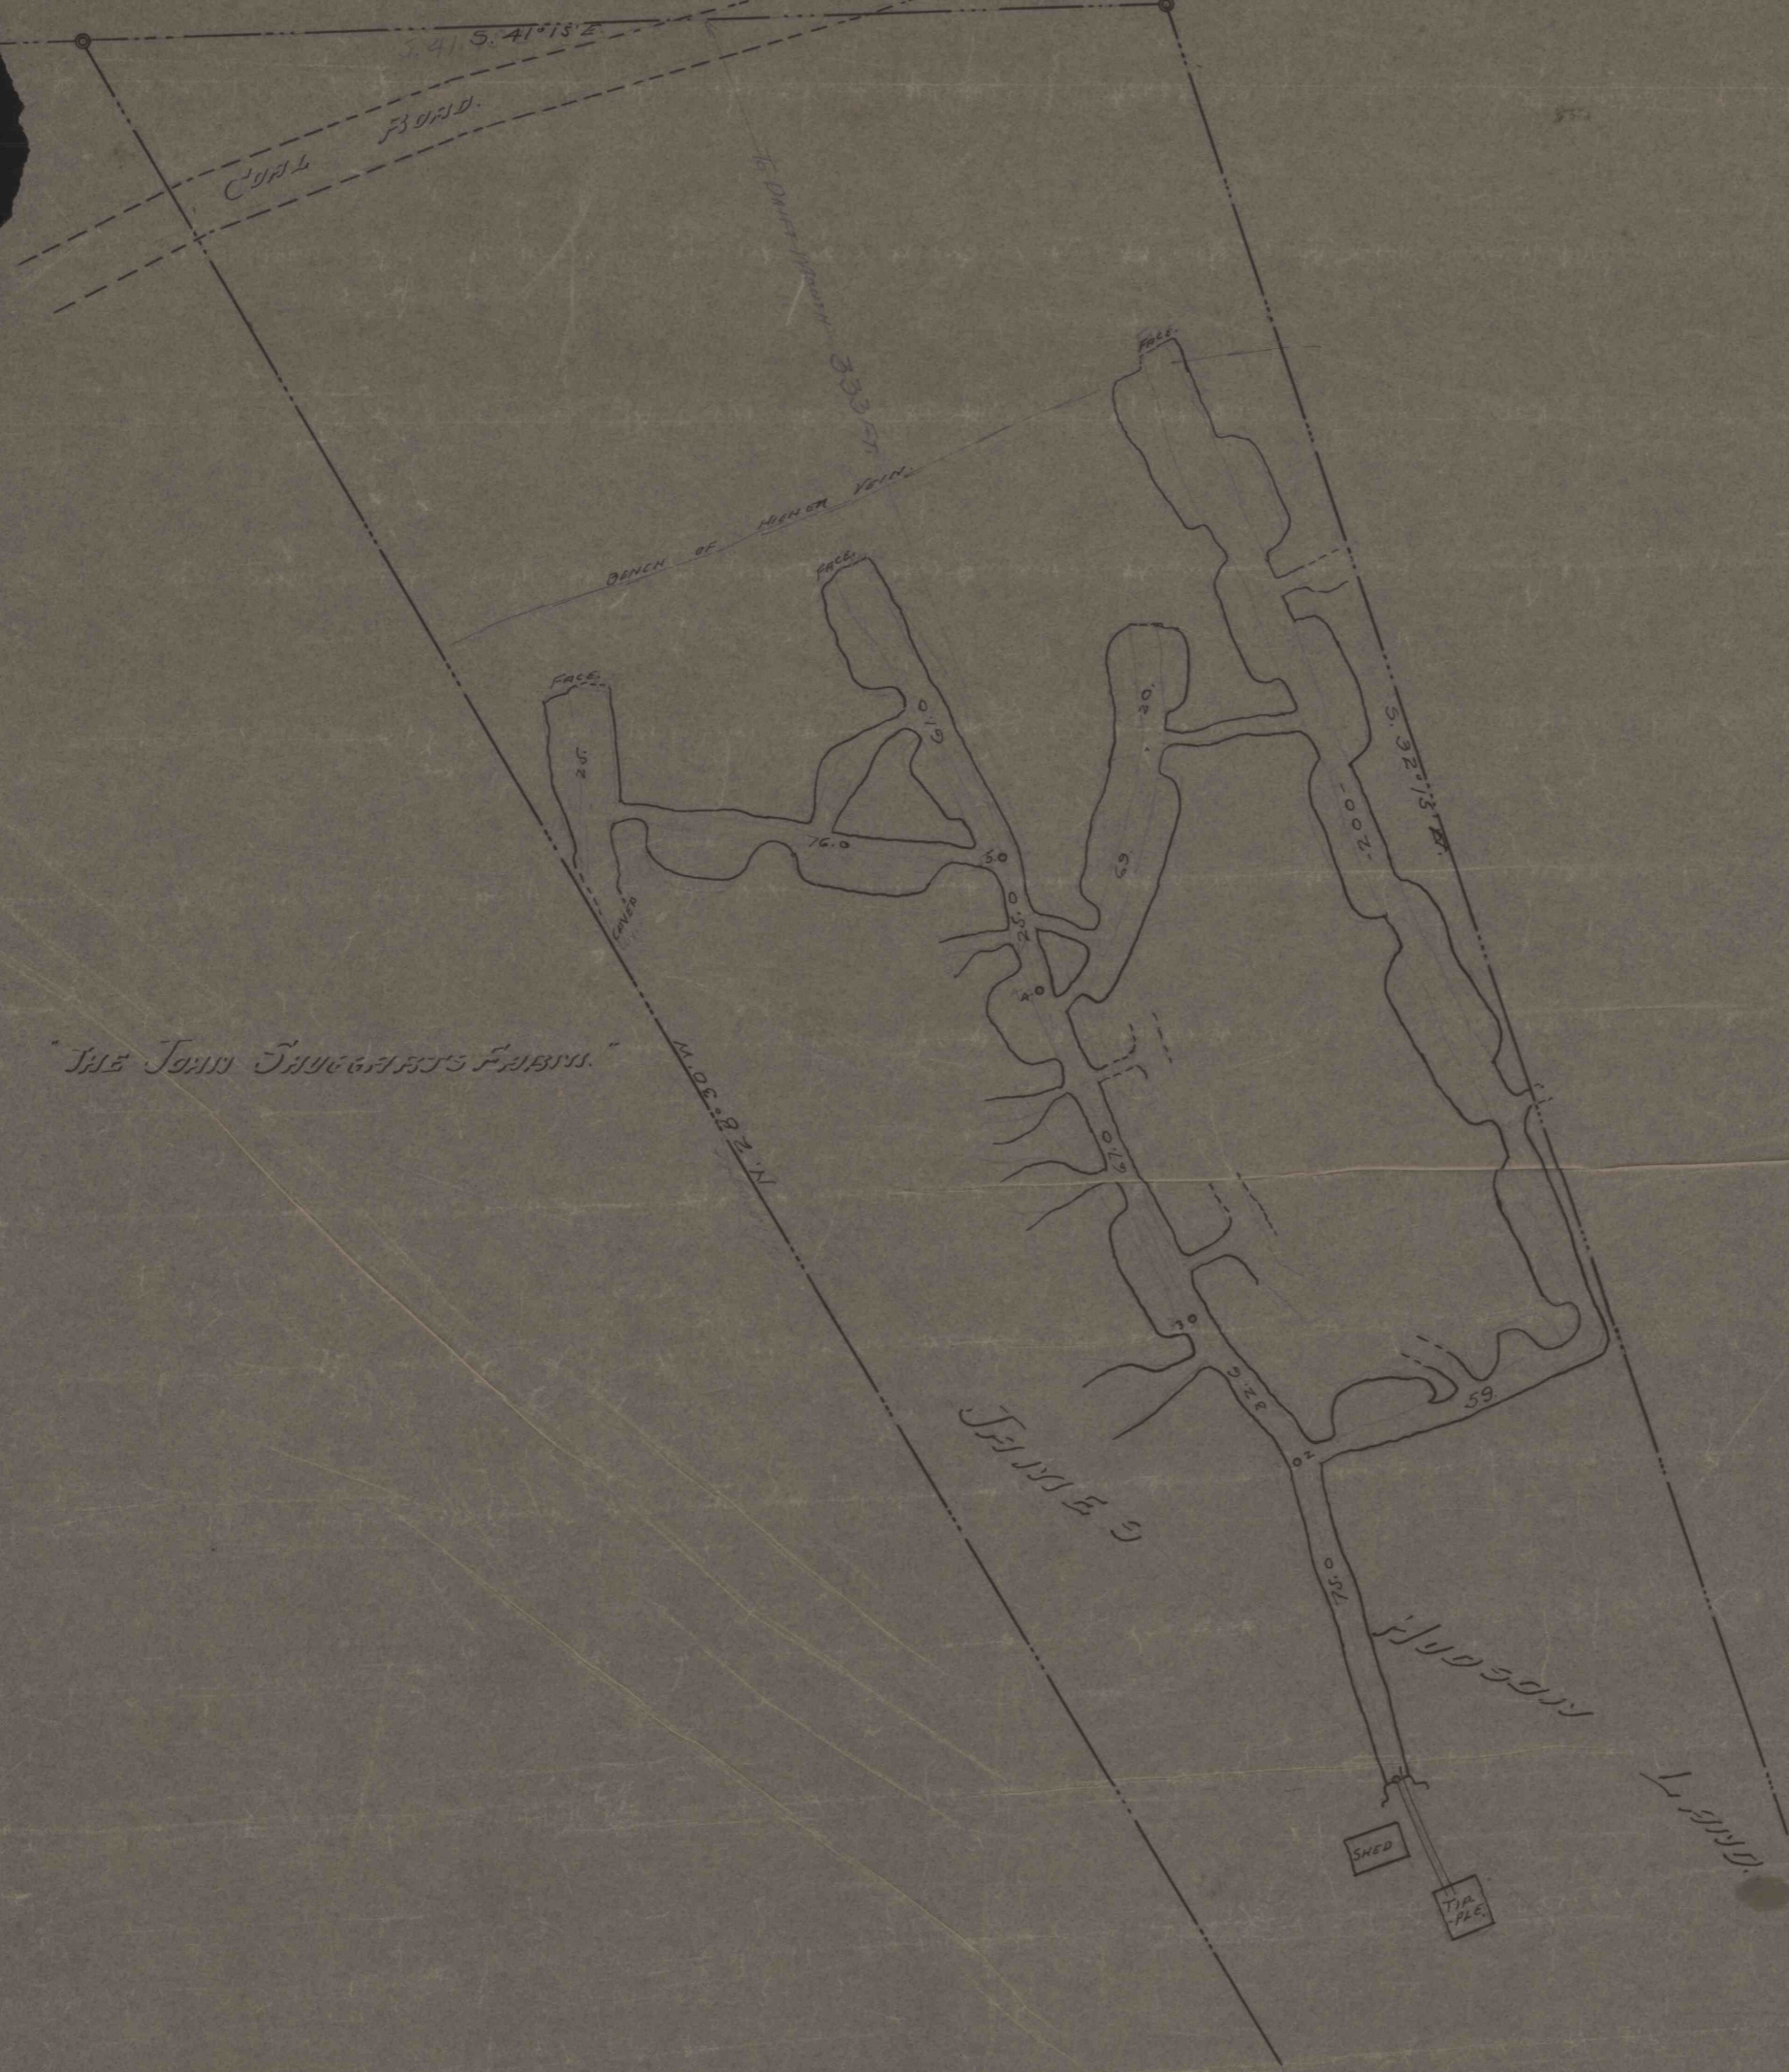

DP

HUGH LEAVY ESTATE
 SURVEY OF THE
 "JAMES HUDSON MINE"
 LAWRENCE TAYLOR CO. PH.
 MADE DEC. 9-1916

SCALE 1"=20'
 CHICAGO, ILL. OFFICE OF E. J. HESS,
 120 N. WABASH ST. ENGINEER

1081-B

838

838