


1422

1455

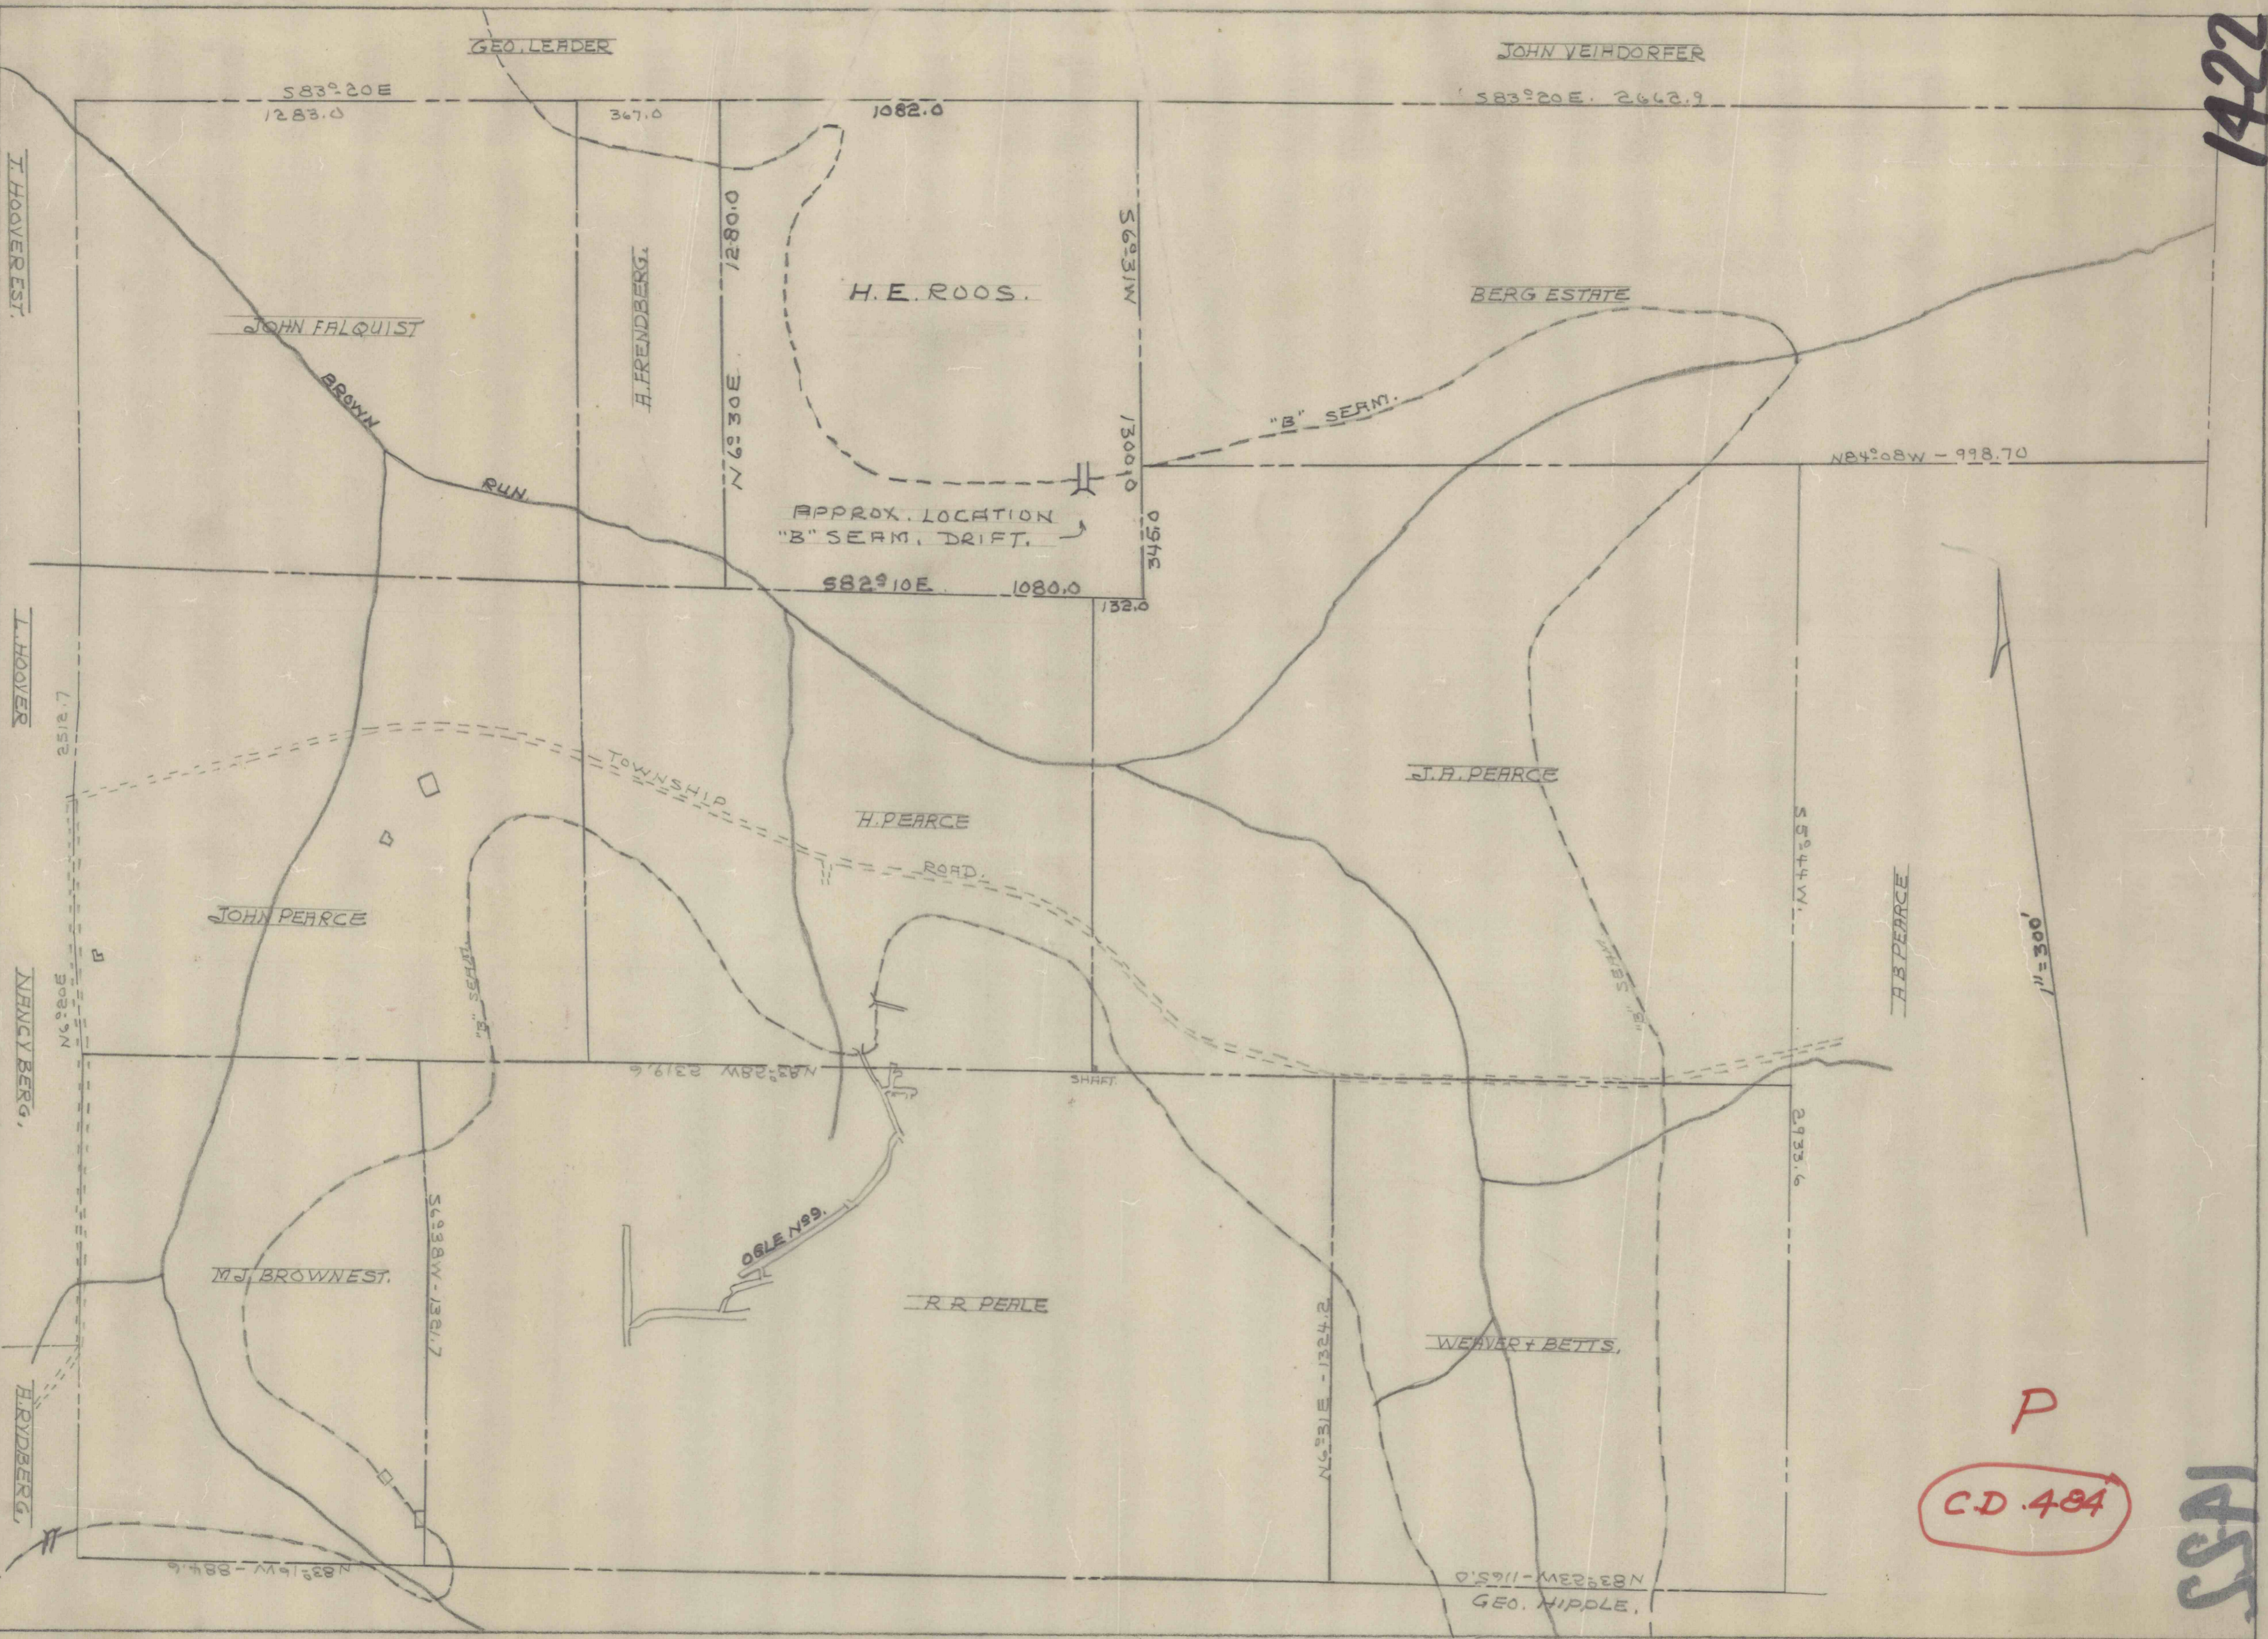

P
 CD. 484