


1" = 300'

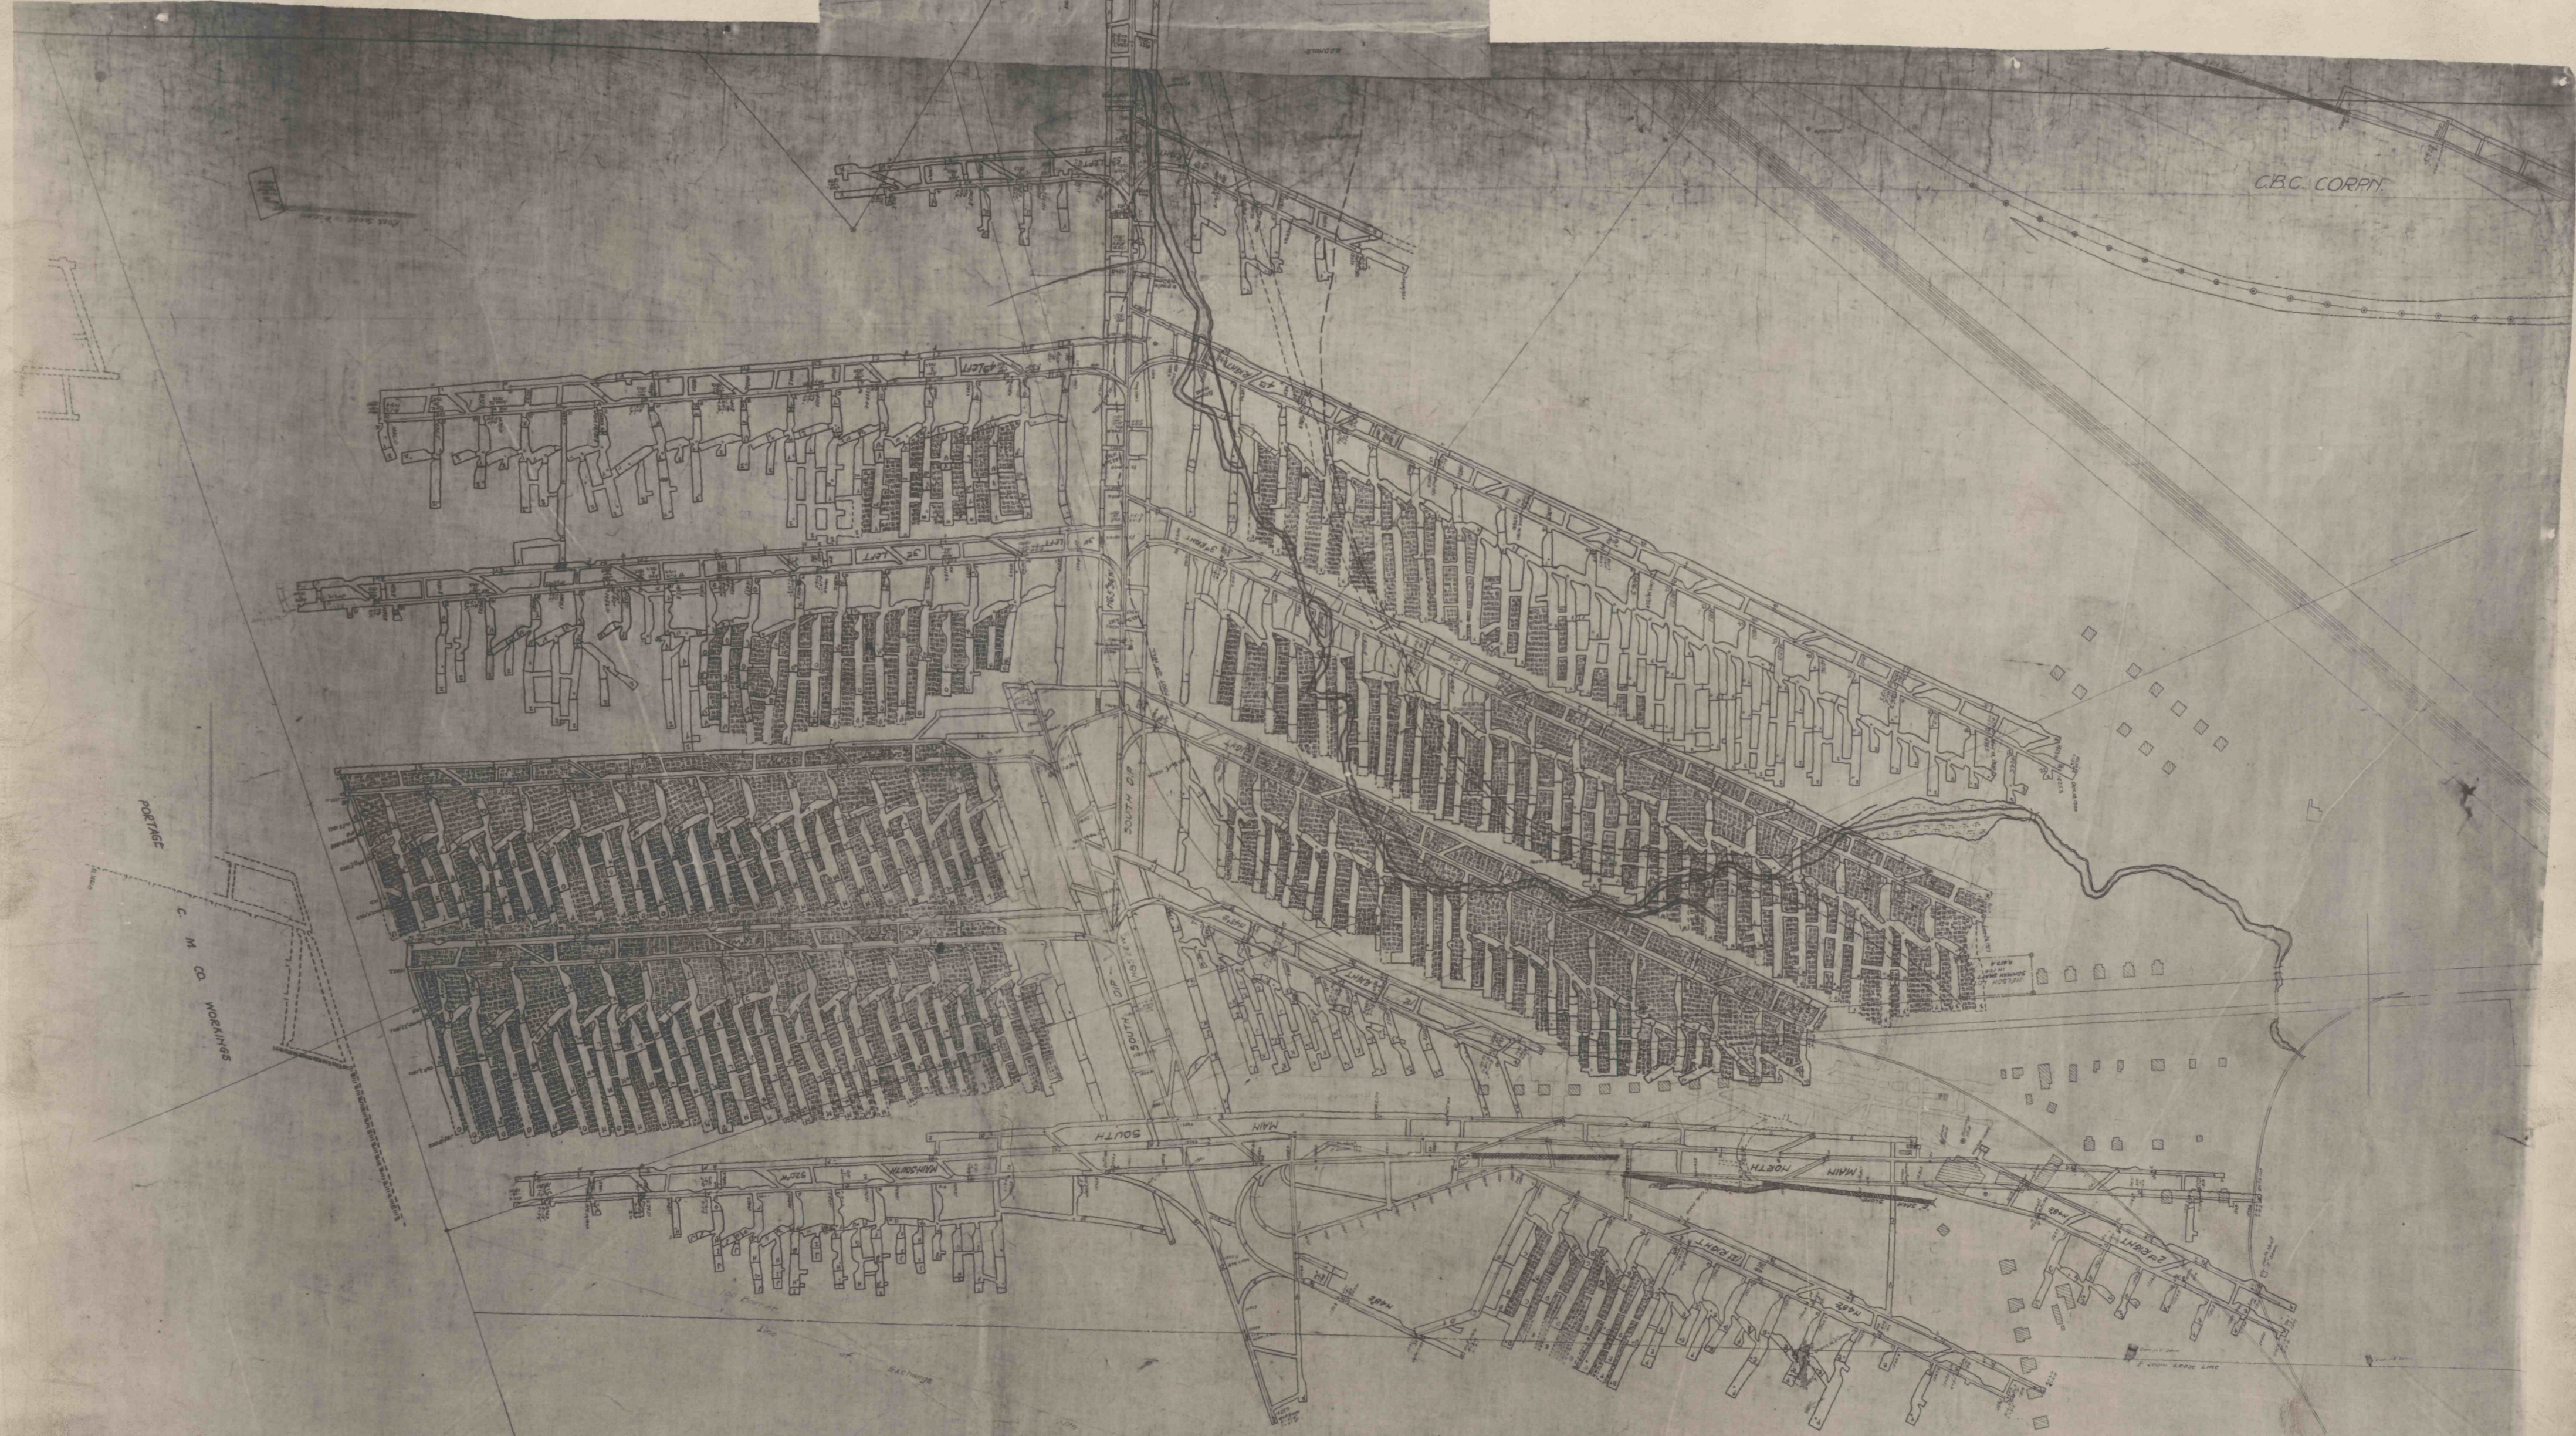

C.B.C. CORP.

C. M. CO. WORKINGS

AFT
BEAM
DAL. CO.
TURNING CO.
CO. PA.

1547.5

