


1" = 300'

2

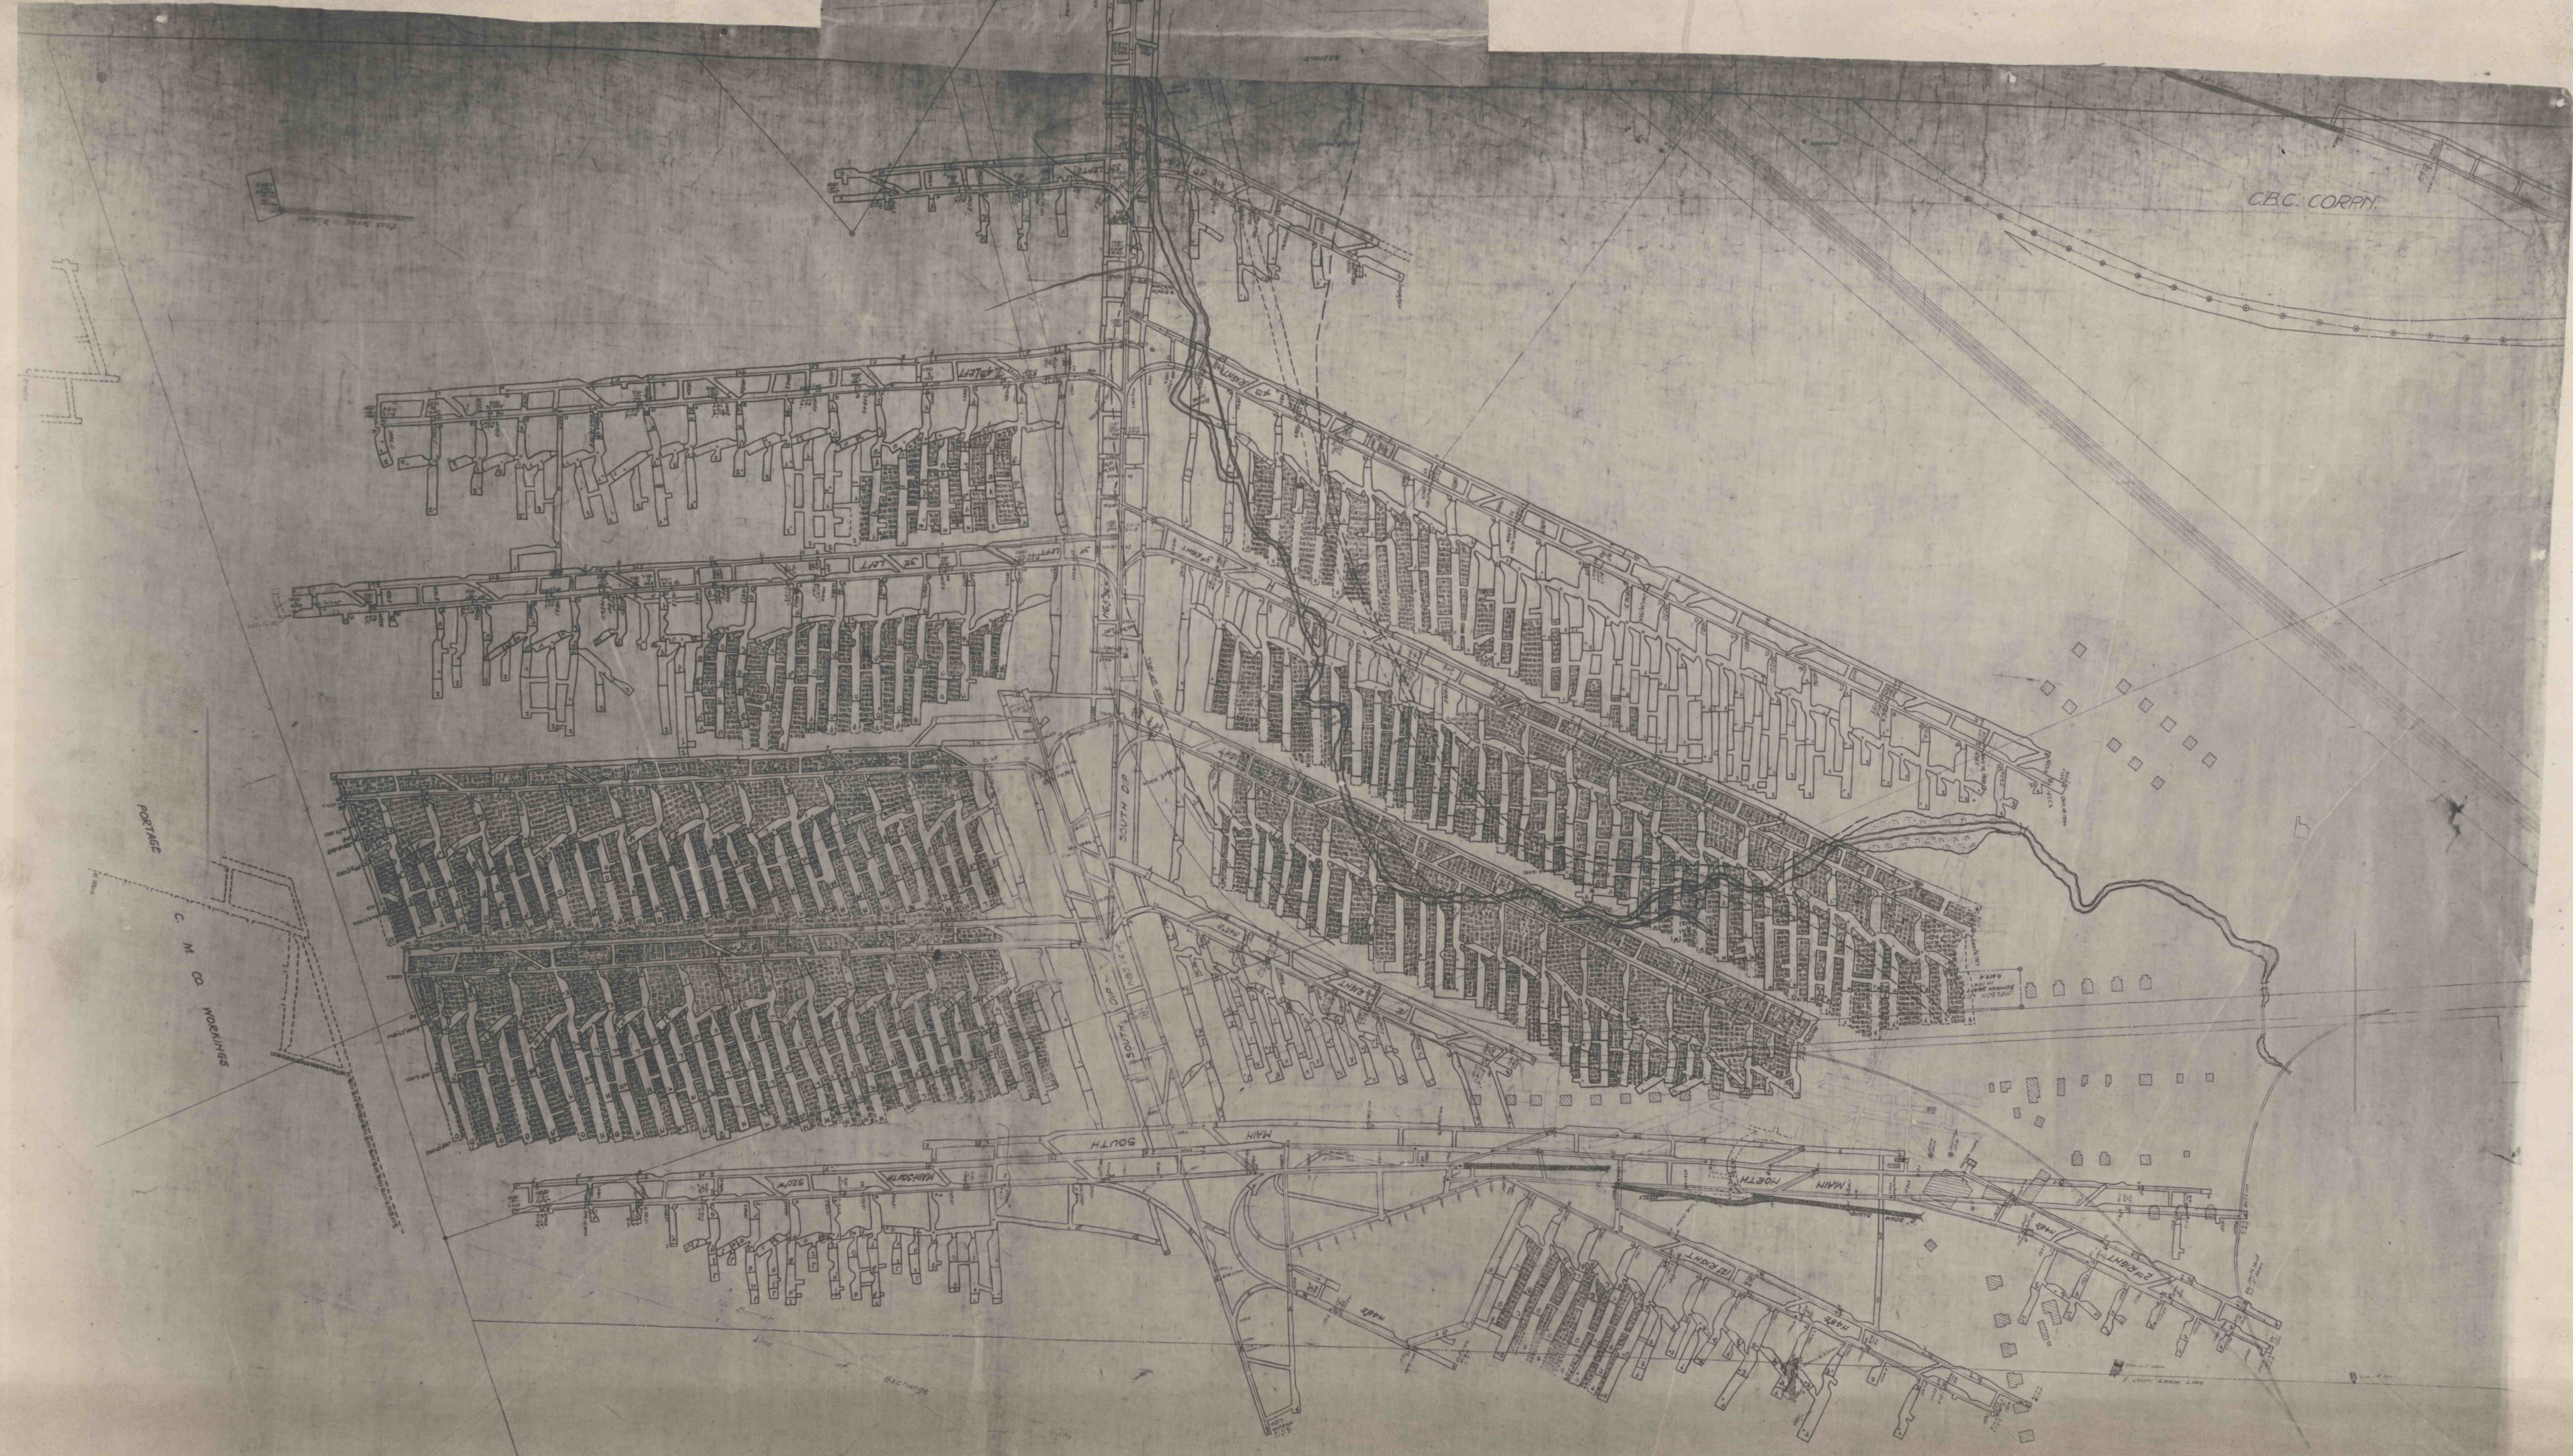

AFT  
BEAM  
DAL CO.  
HARRING CO.  
CO PA