




ENV. No.

SHEET No. 50-3-566

1" = 300 ft.
SCALE

MAP SHOWING RELATION OF
COAL LANDS OF REMBRANDT PEALE TO
COAL LAND OF NORTH AMERICAN REFRACTORIES CO. DATE Feb. 15, 1935.

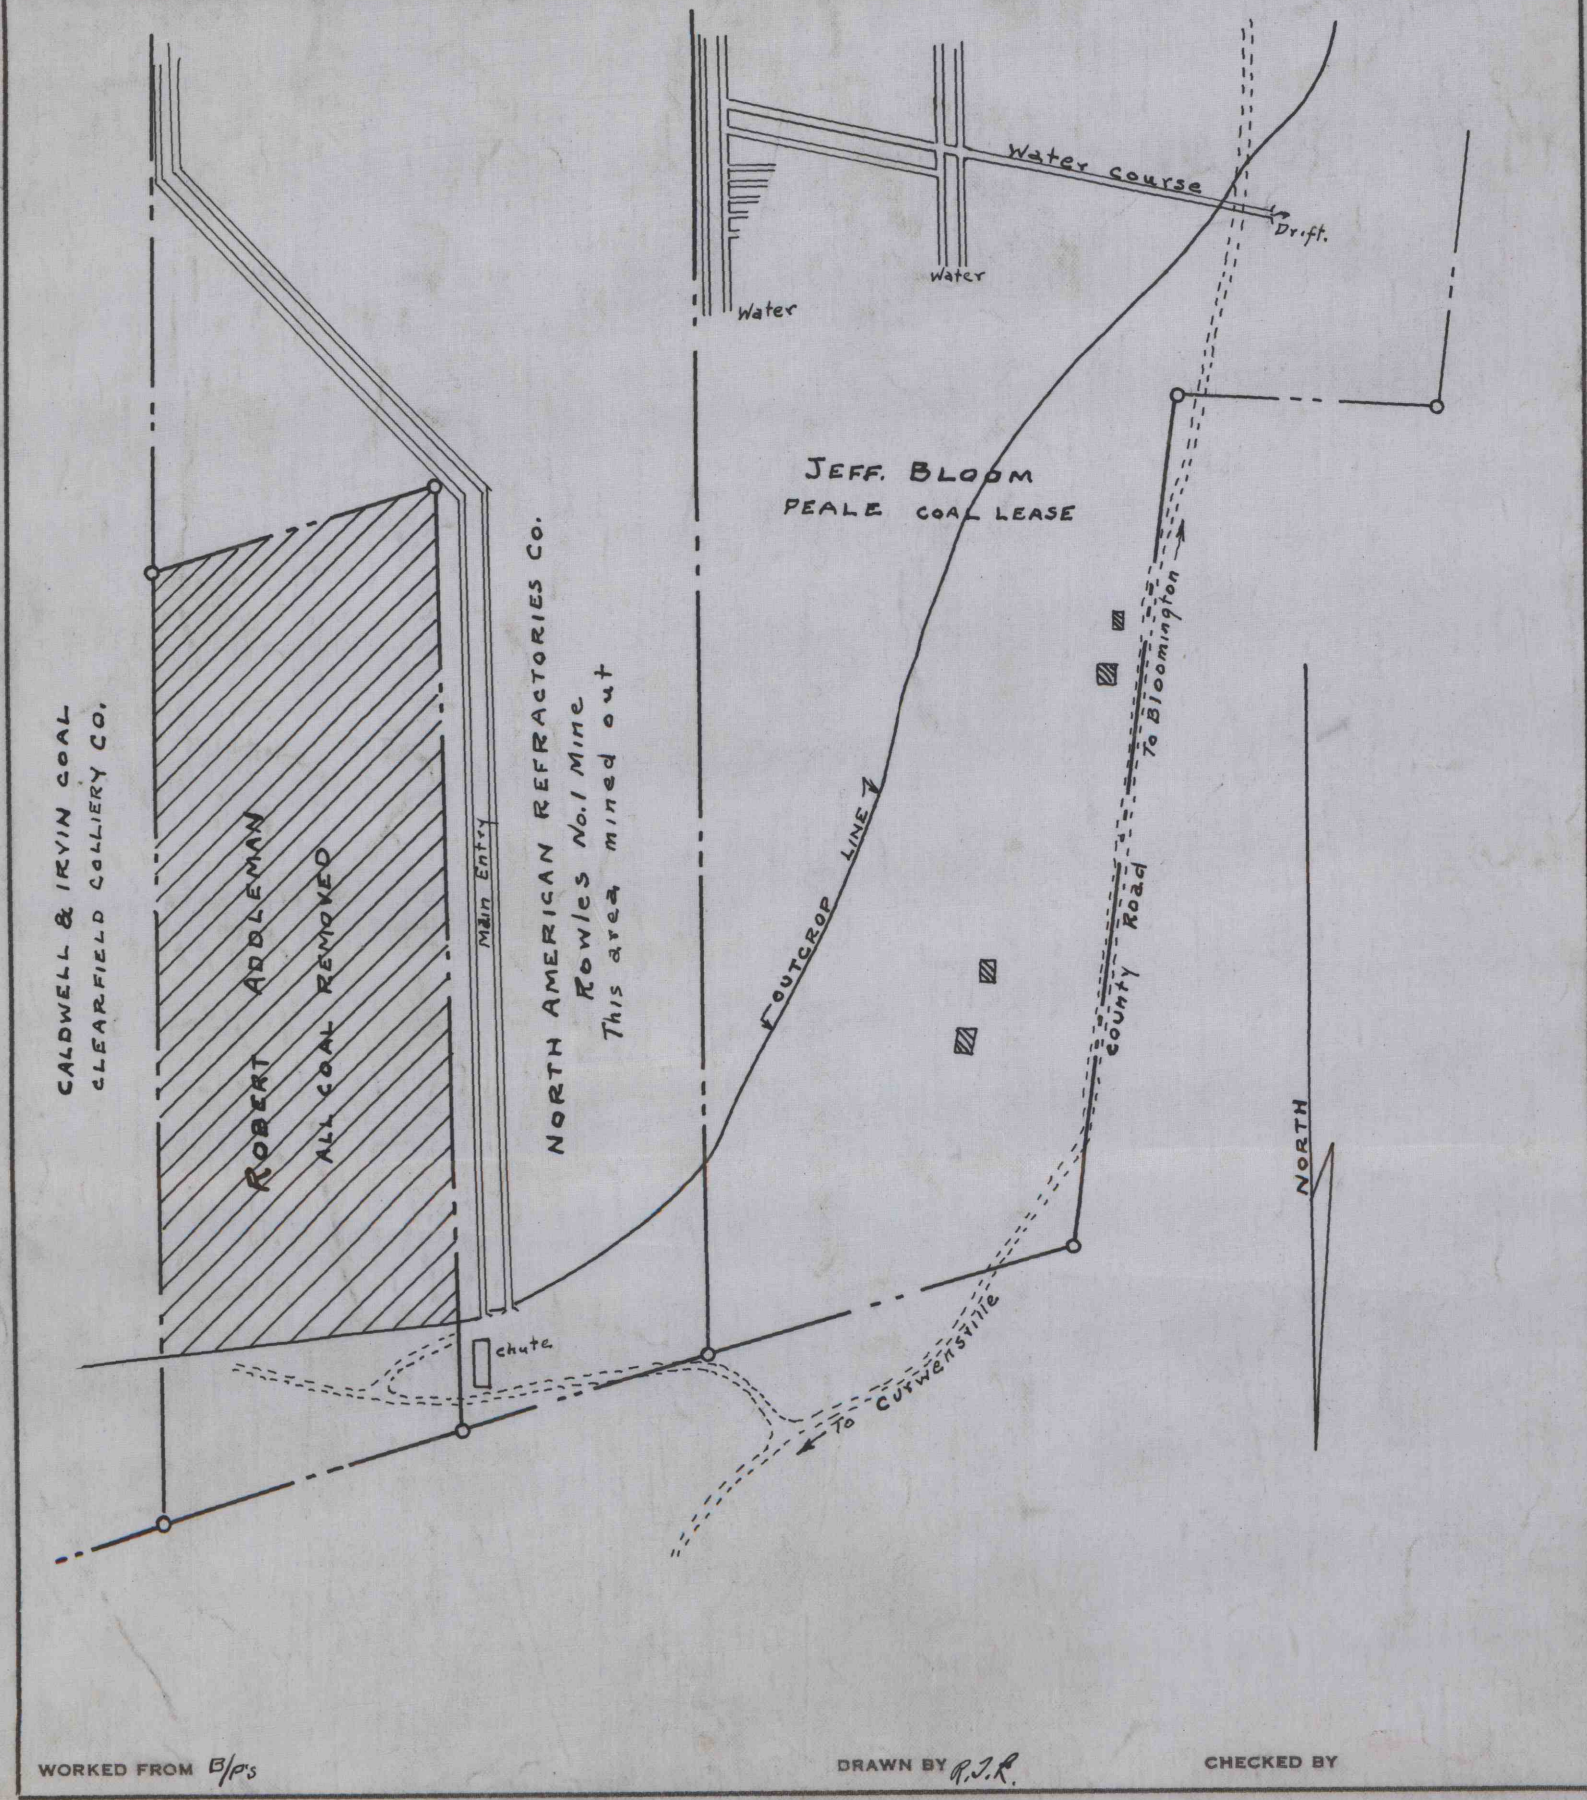

BENN-01321