

REFERENCE DATA

CRESCENT REFRACTORIES CO.

CURWENSVILLE, CLEARFIELD COUNTY, PA.

ENGINEERING DEPARTMENT

DIAMOND DRILL HOLES
MOSES NORRIS - STAGE TRACT


ENV. NO.

SHEET NO.

50-3-752

DATE 12-2-19
12-12-19

SCALE 1" = 300'

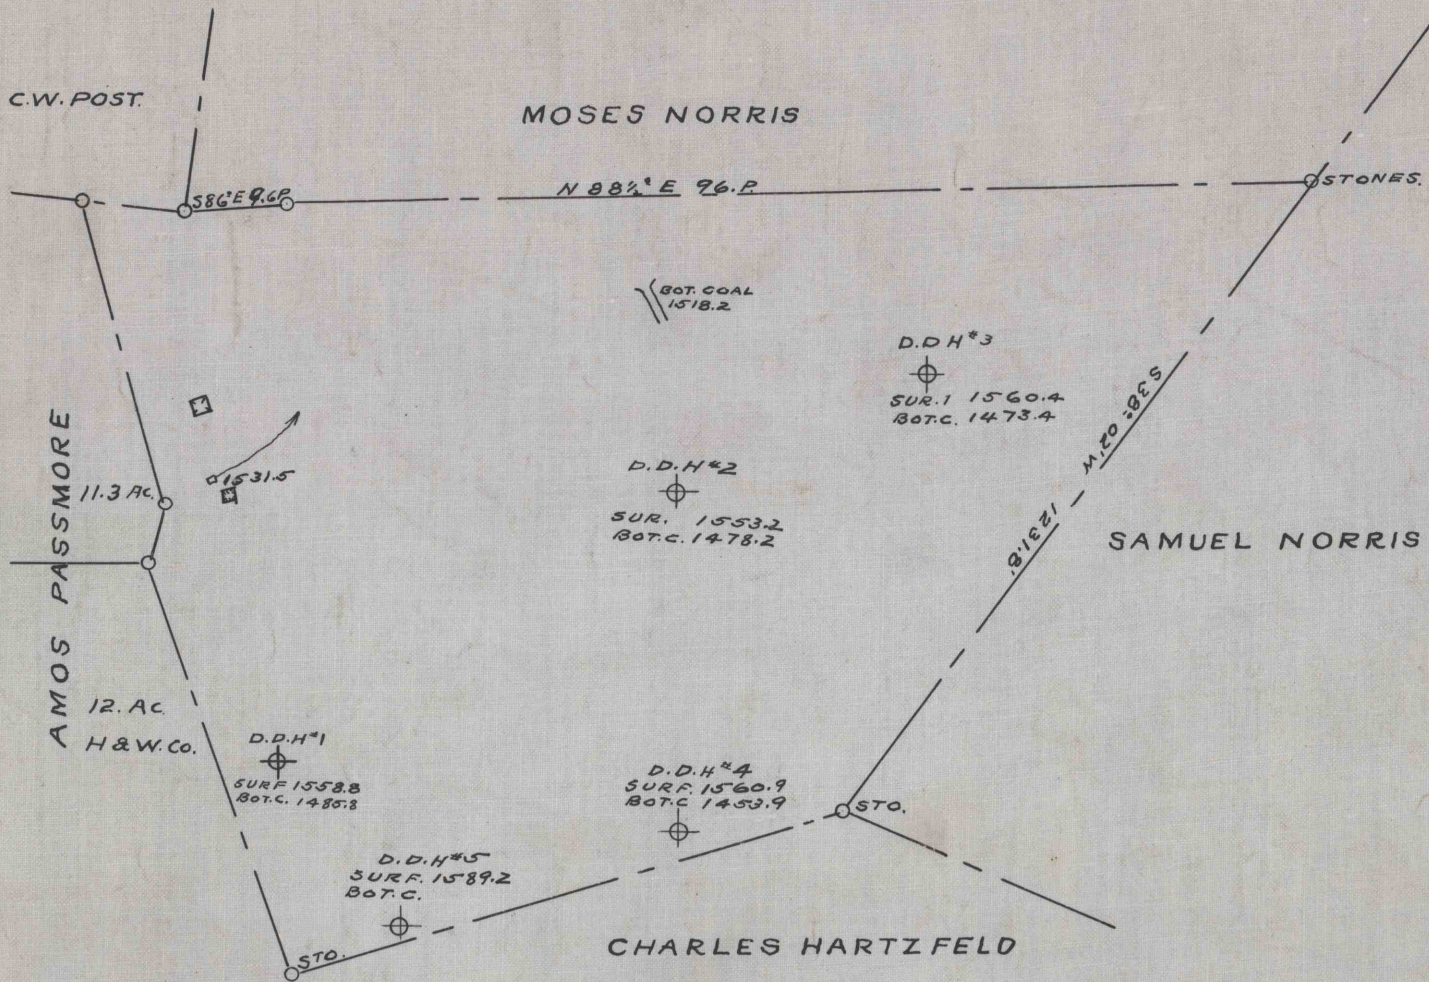

WORKED FROM 1051. I

DRAWN BY C.F.S

CHECKED BY