


20-2-5

20-2-5

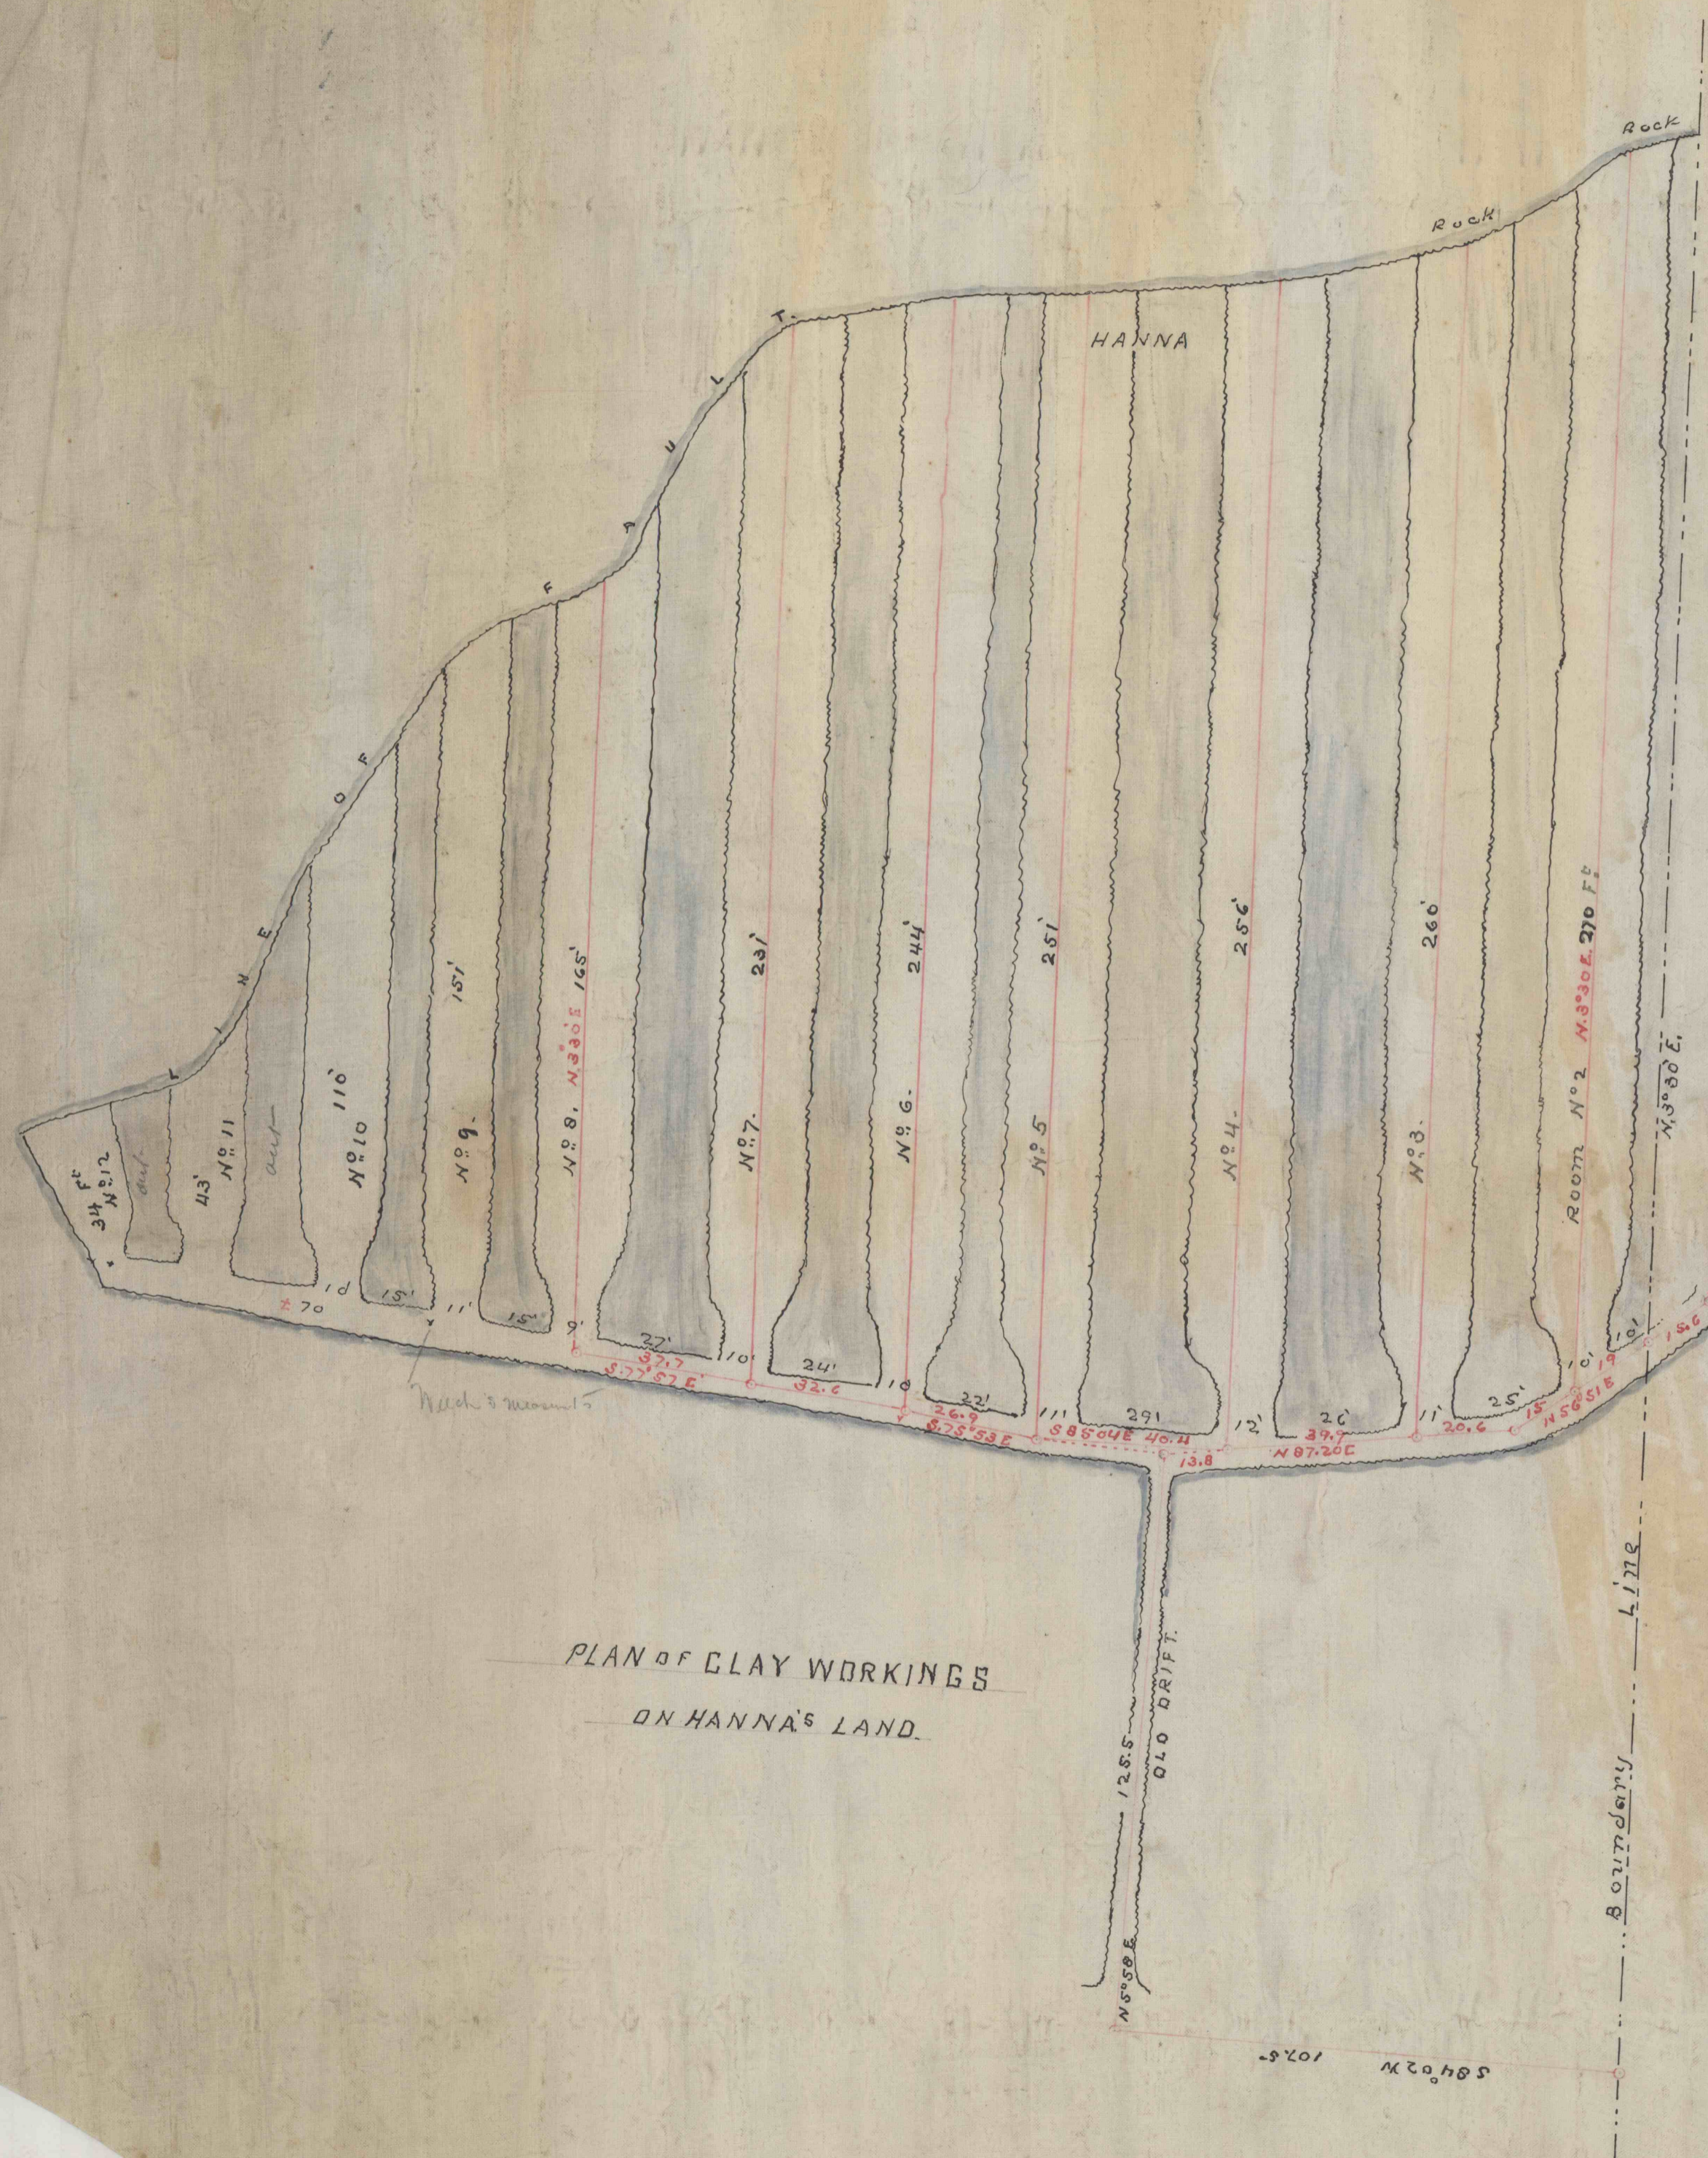

PLAN OF CLAY WORKINGS
ON HANNA'S LAND.

CLINTON MINING CO.

scale 1 inch = 30 feet.

E.H.V.
QR-3005

HANNA
WELLS

Room No. 16

Room No. 17

20-2-5

20-2-5