


North Beach  
2-25-19

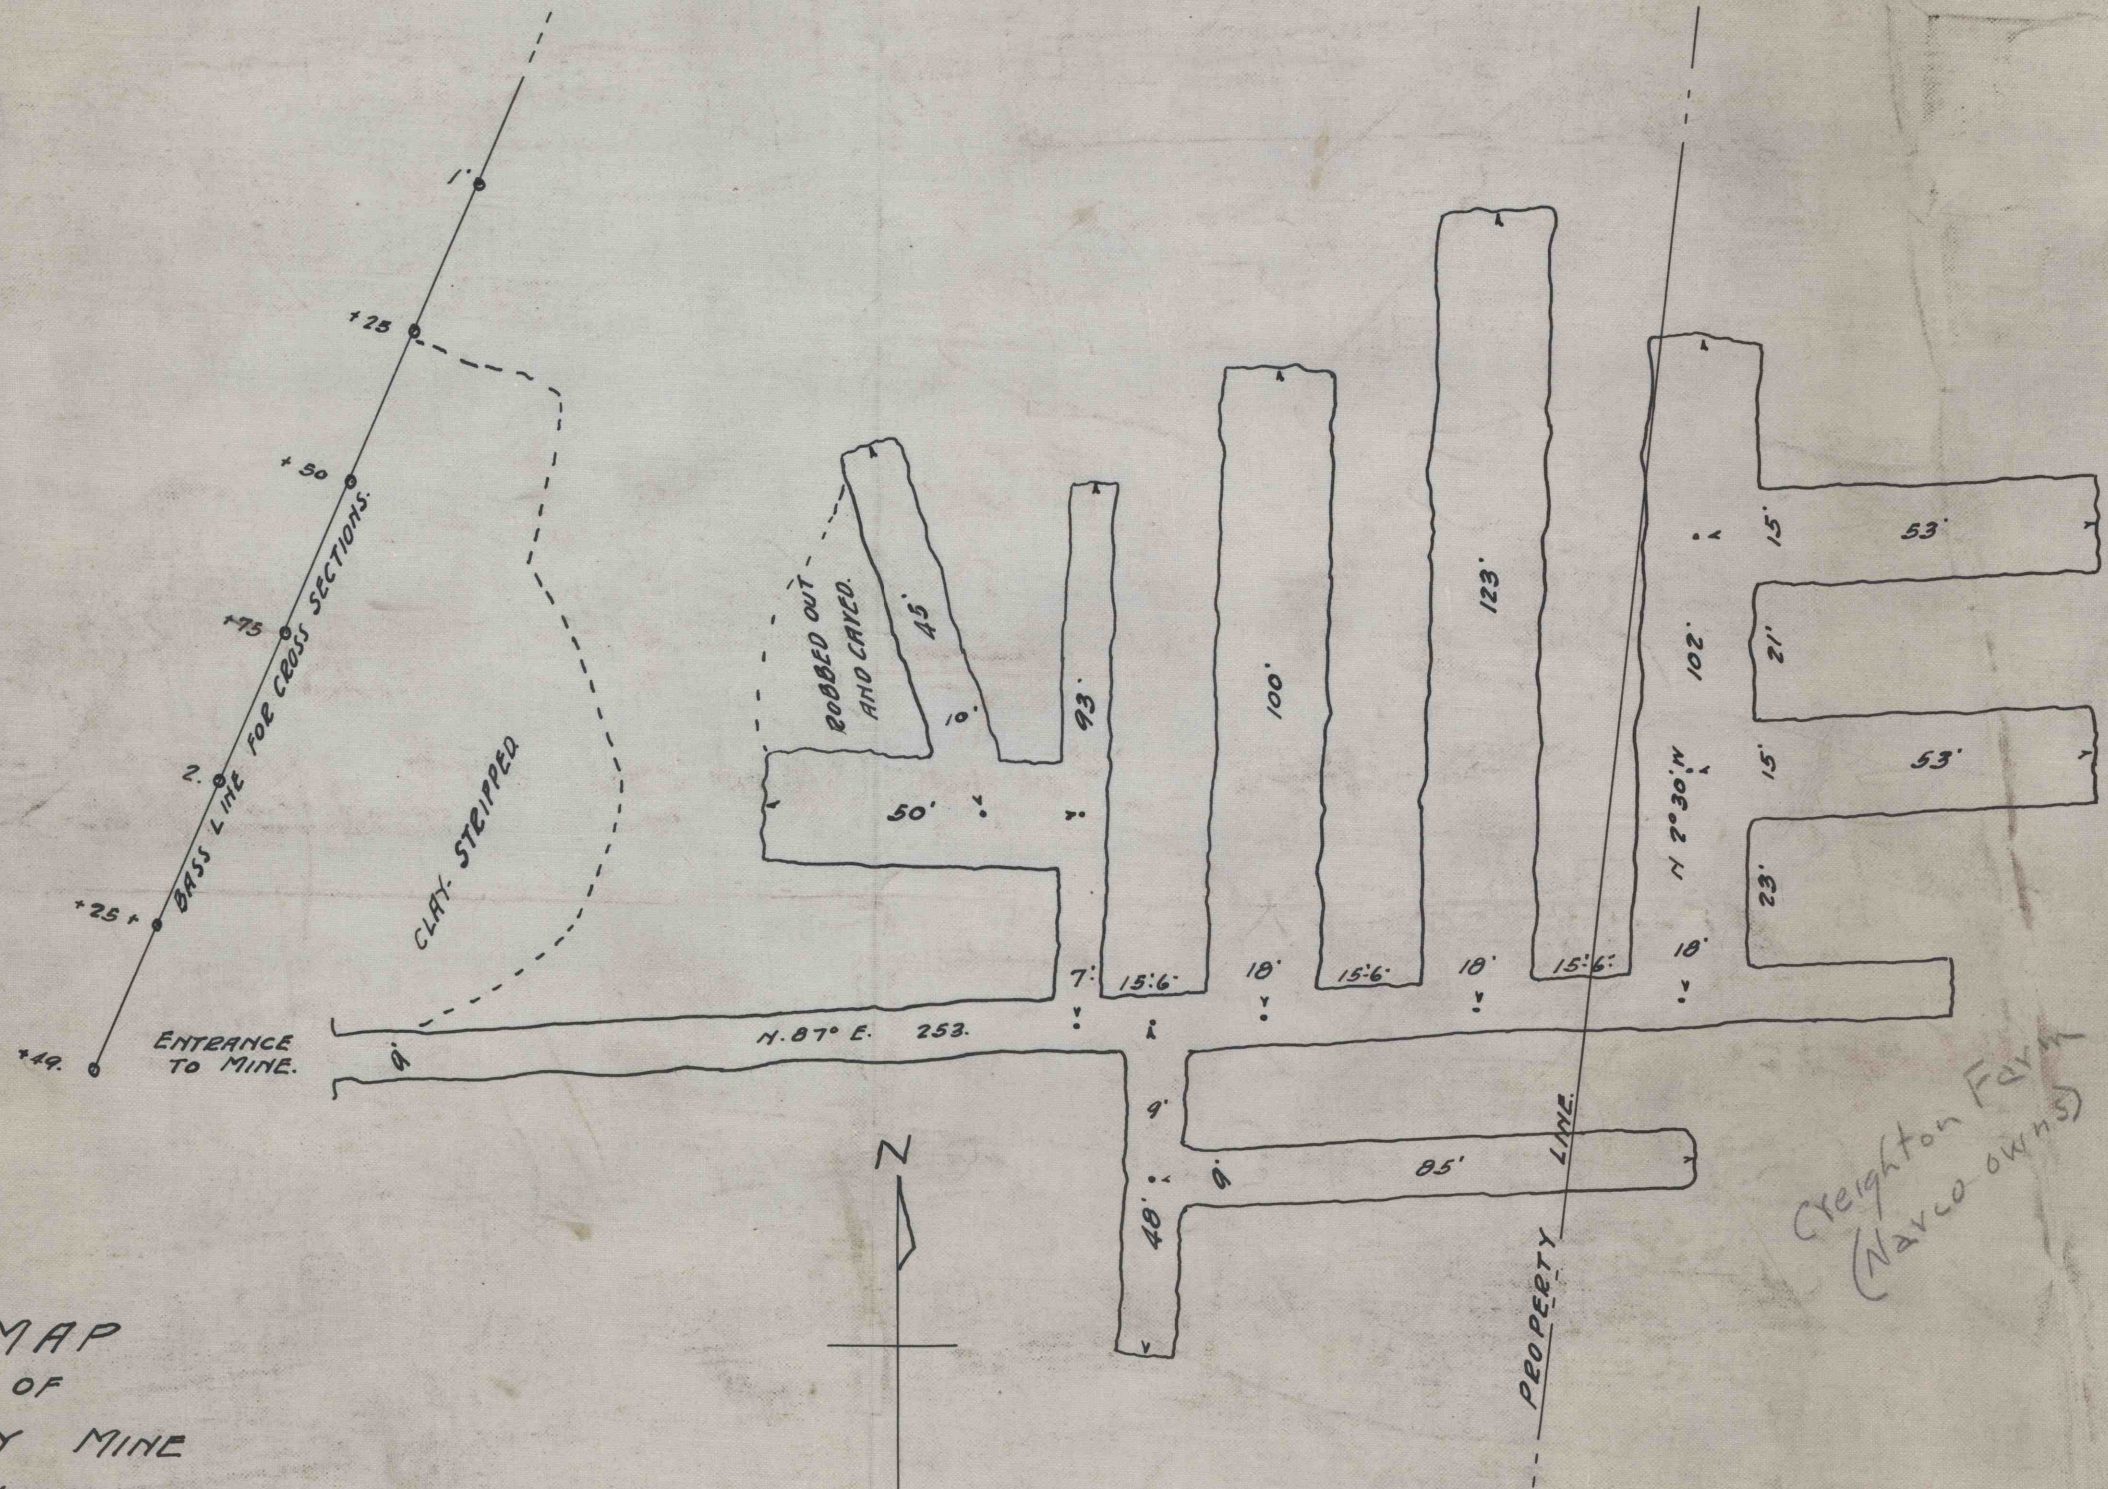

MAP  
OF  
CLAY MINE  
SUSQUEHANNA TRACT.  
SURVEYED FEBRUARY 10<sup>TH</sup> 1919.  
SCALE 30 FEET TO 1 INCH  
CHAS. E. BALL.

Creighton Farm  
(Narco owns)