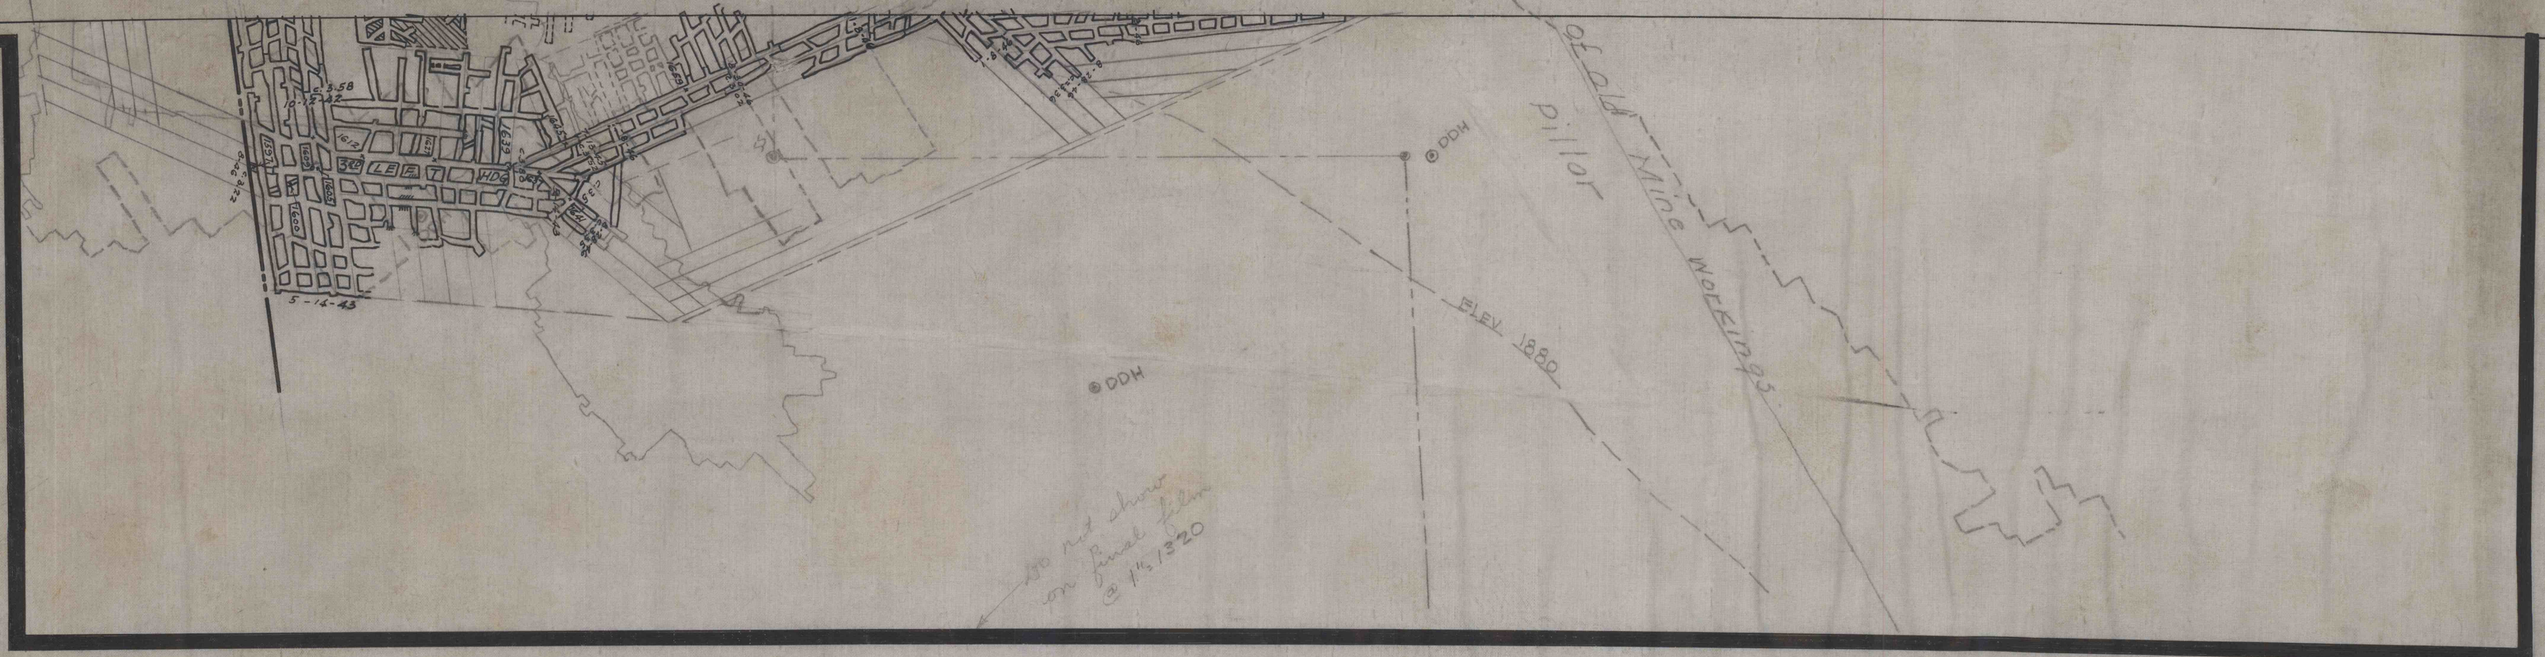

Pillar
of old Mine Workings
ELEV 1880
DDH
DDH
3rd LEFT HDG
5-14-43
Do not show on final film @ 1"=1320