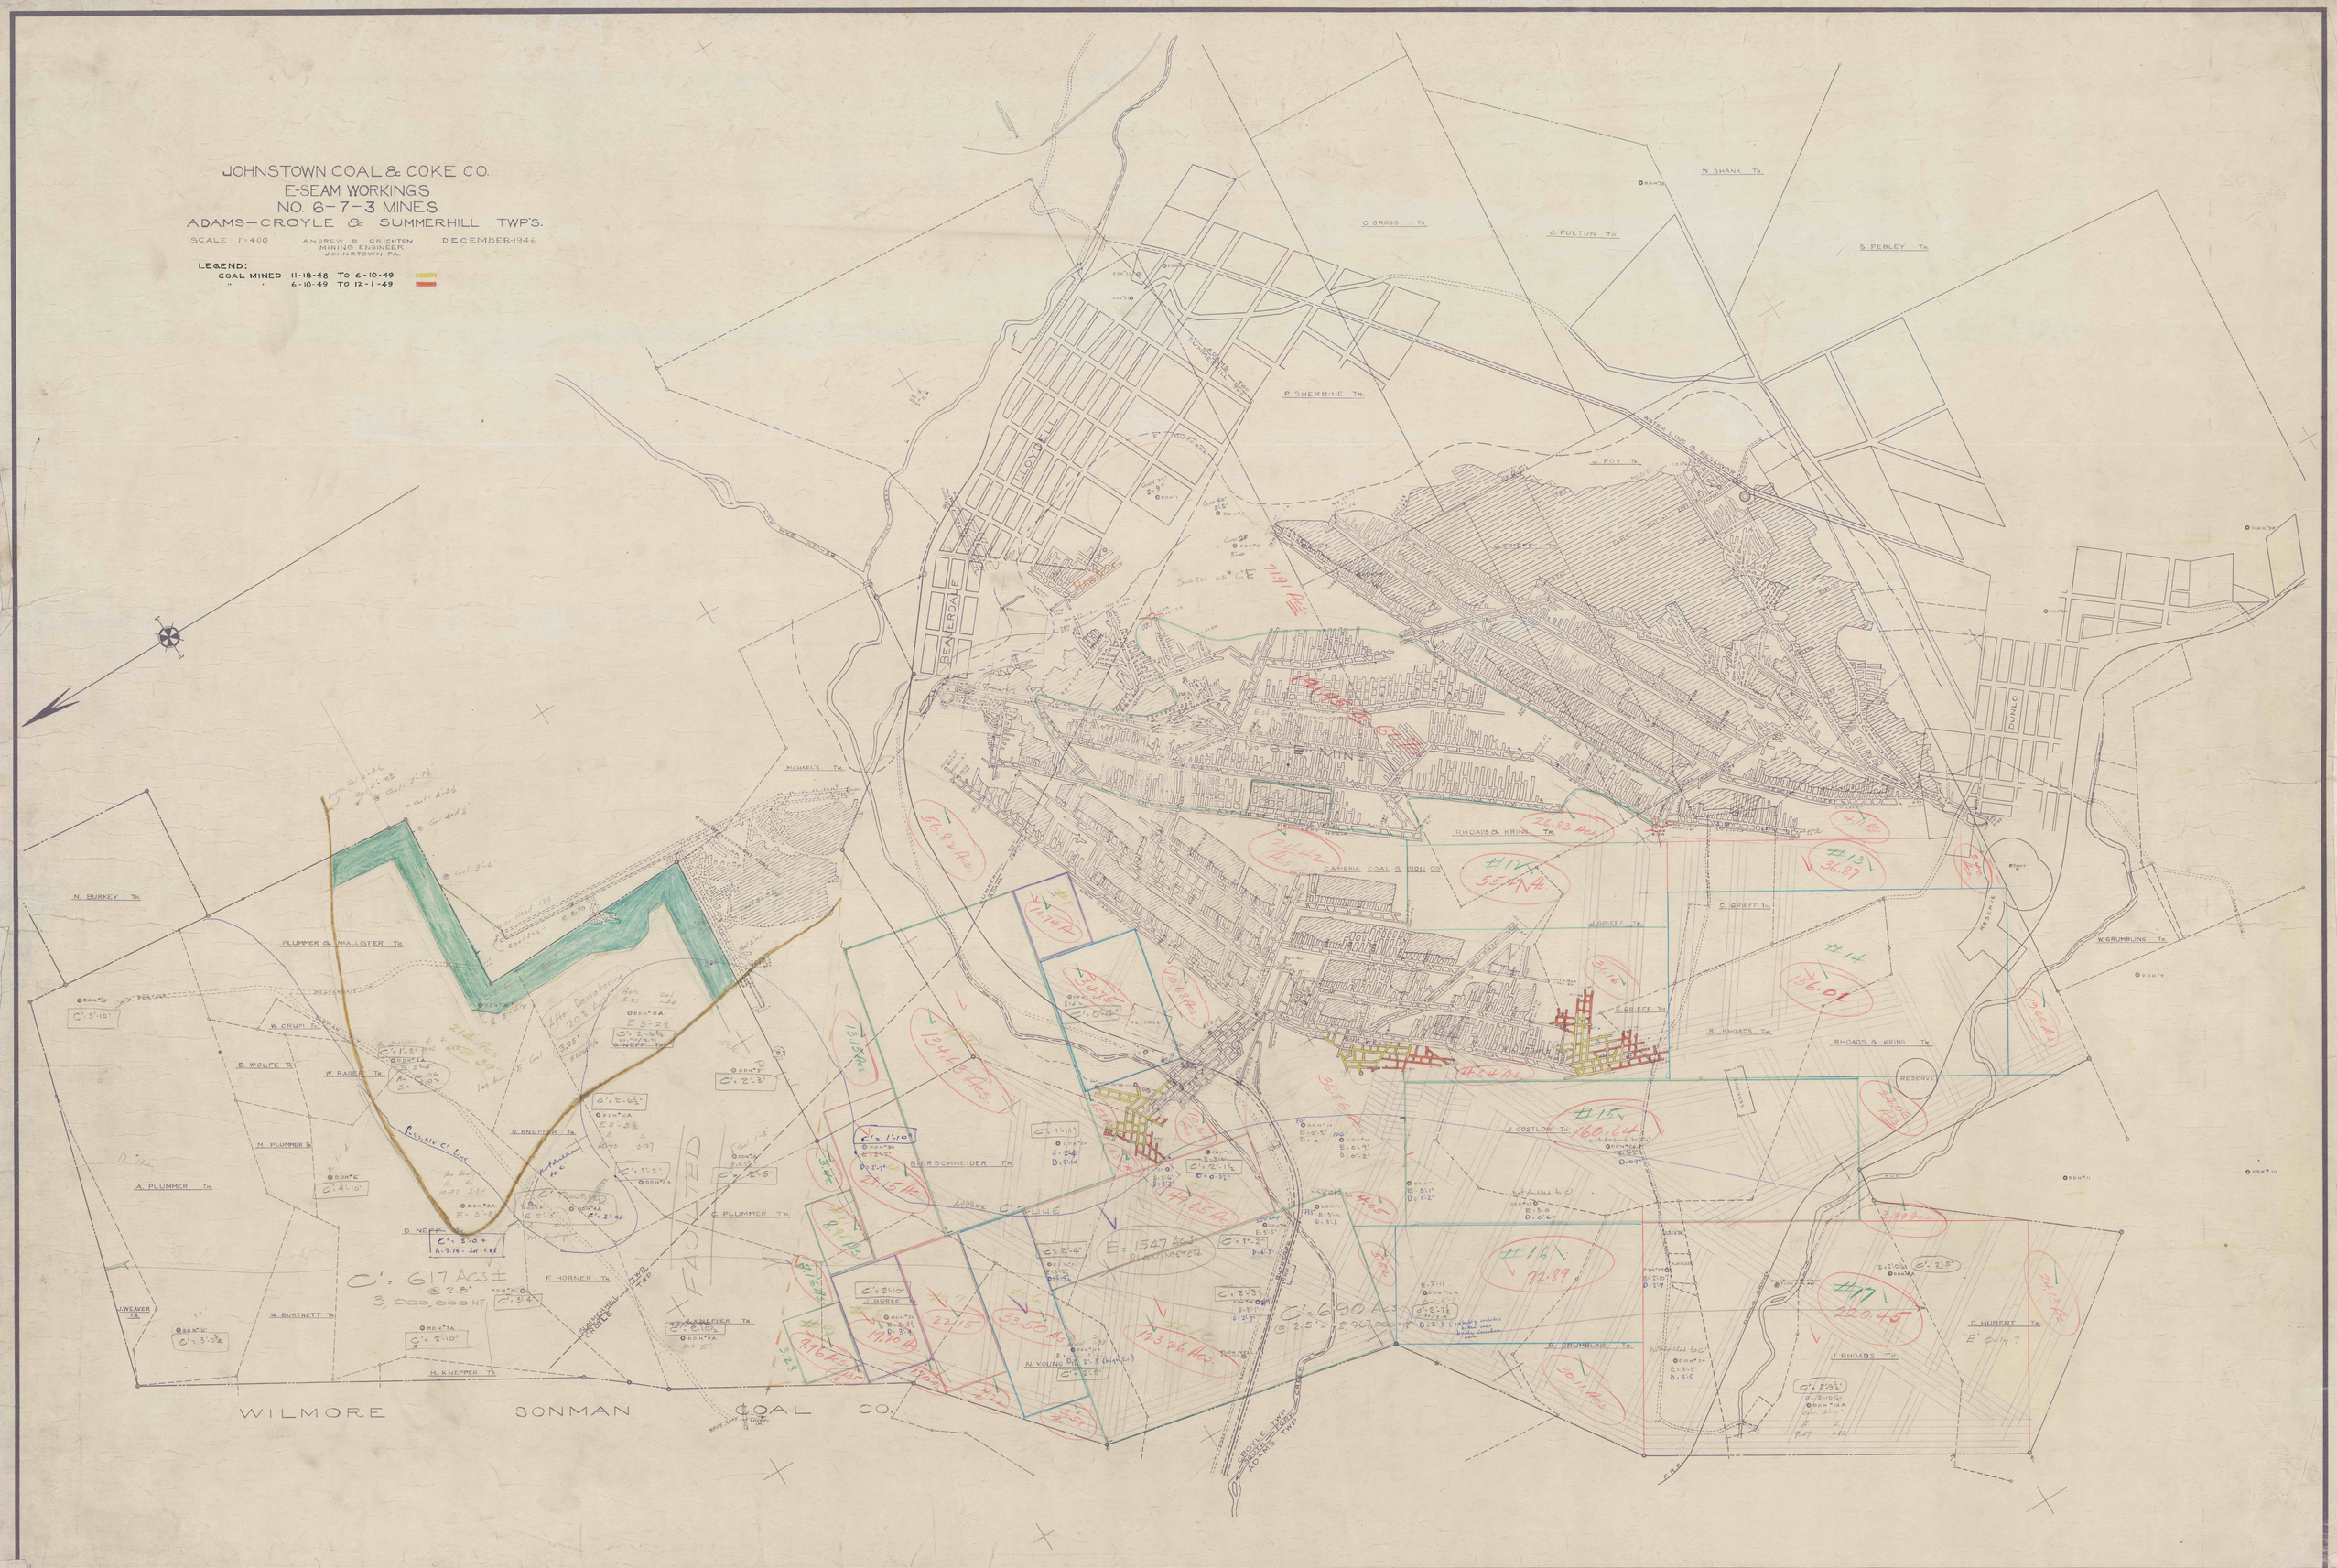
JOHNSTOWN COAL & COKE CO.
E-SEAM WORKINGS
NO. 6-7-3 MINES
ADAMS-CROYLE & SUMMERHILL TWP'S.
SCALE 1"=400
ANDREW B. CRICHTON
MINING ENGINEER
JOHNSTOWN PA.
DECEMBER-1946
LEGEND:
COAL MINED 11-18-48 TO 6-10-49
" " 6-10-49 TO 12-1-49
LLOYDELL
BEAVERDALE
DUNLO
WILMORE SONMAN COAL CO.
FAULTED
C' = 617 ACS ±
3,000,000 NT
E = 1547 ACS
PLANIMETER
C' = 690 ACS
@ 2.5' = 2,967,000 NT
#12
#13
#14
#15
#16
#17
W. SHANK Tr.
C. GROSS Tr.
J. FULTON Tr.
S. PEBLEY Tr.
P. SHERBINE Tr.
J. FOY Tr.
MICHAEL'S Tr.
N. BURKEY Tr.
PLUMMER & McALLISTER Tr.
W. CRUM Tr.
E. WOLFE Tr.
W. RAGER Tr.
H. PLUMMER Tr.
A. PLUMMER Tr.
D. KNEPPER Tr.
D. NEFF Tr.
C. PLUMMER Tr.
F. HORNER Tr.
J. WEAVER Tr.
W. BURTNETT Tr.
H. KNEPPER Tr.
BIERSCHNEIDER Tr.
J. BURKE Tr.
N. YOUNG Tr.
RHOADS & KRING Tr.
CAMBRIA COAL & IRON CO.
J. GRIEFF Tr.
C. GRIEFF Tr.
R. RHOADS Tr.
J. COSTLOW Tr.
B. GRUMBLING Tr.
W. GRUMBLING Tr.
D. HUBERT Tr.
J. RHOADS Tr.
RESERVE
SUMMERHILL TWP
CROYLE TWP
ADAMS TWP