


BEAVER RUN COAL Co.
 PROPERTY MAP
 -Showing-
 DEVELOPMENT OF BEAVER NO.1 MINE

-Located at-
 BEAVERDALE
 SUMMERHILL TWP. CAMBRIA Co., PA.
 -Scale- 1"=400'-
 November 27th 1917
 -Gardner & Stoker-
 Mining Engs. - Johnstown, Penna.

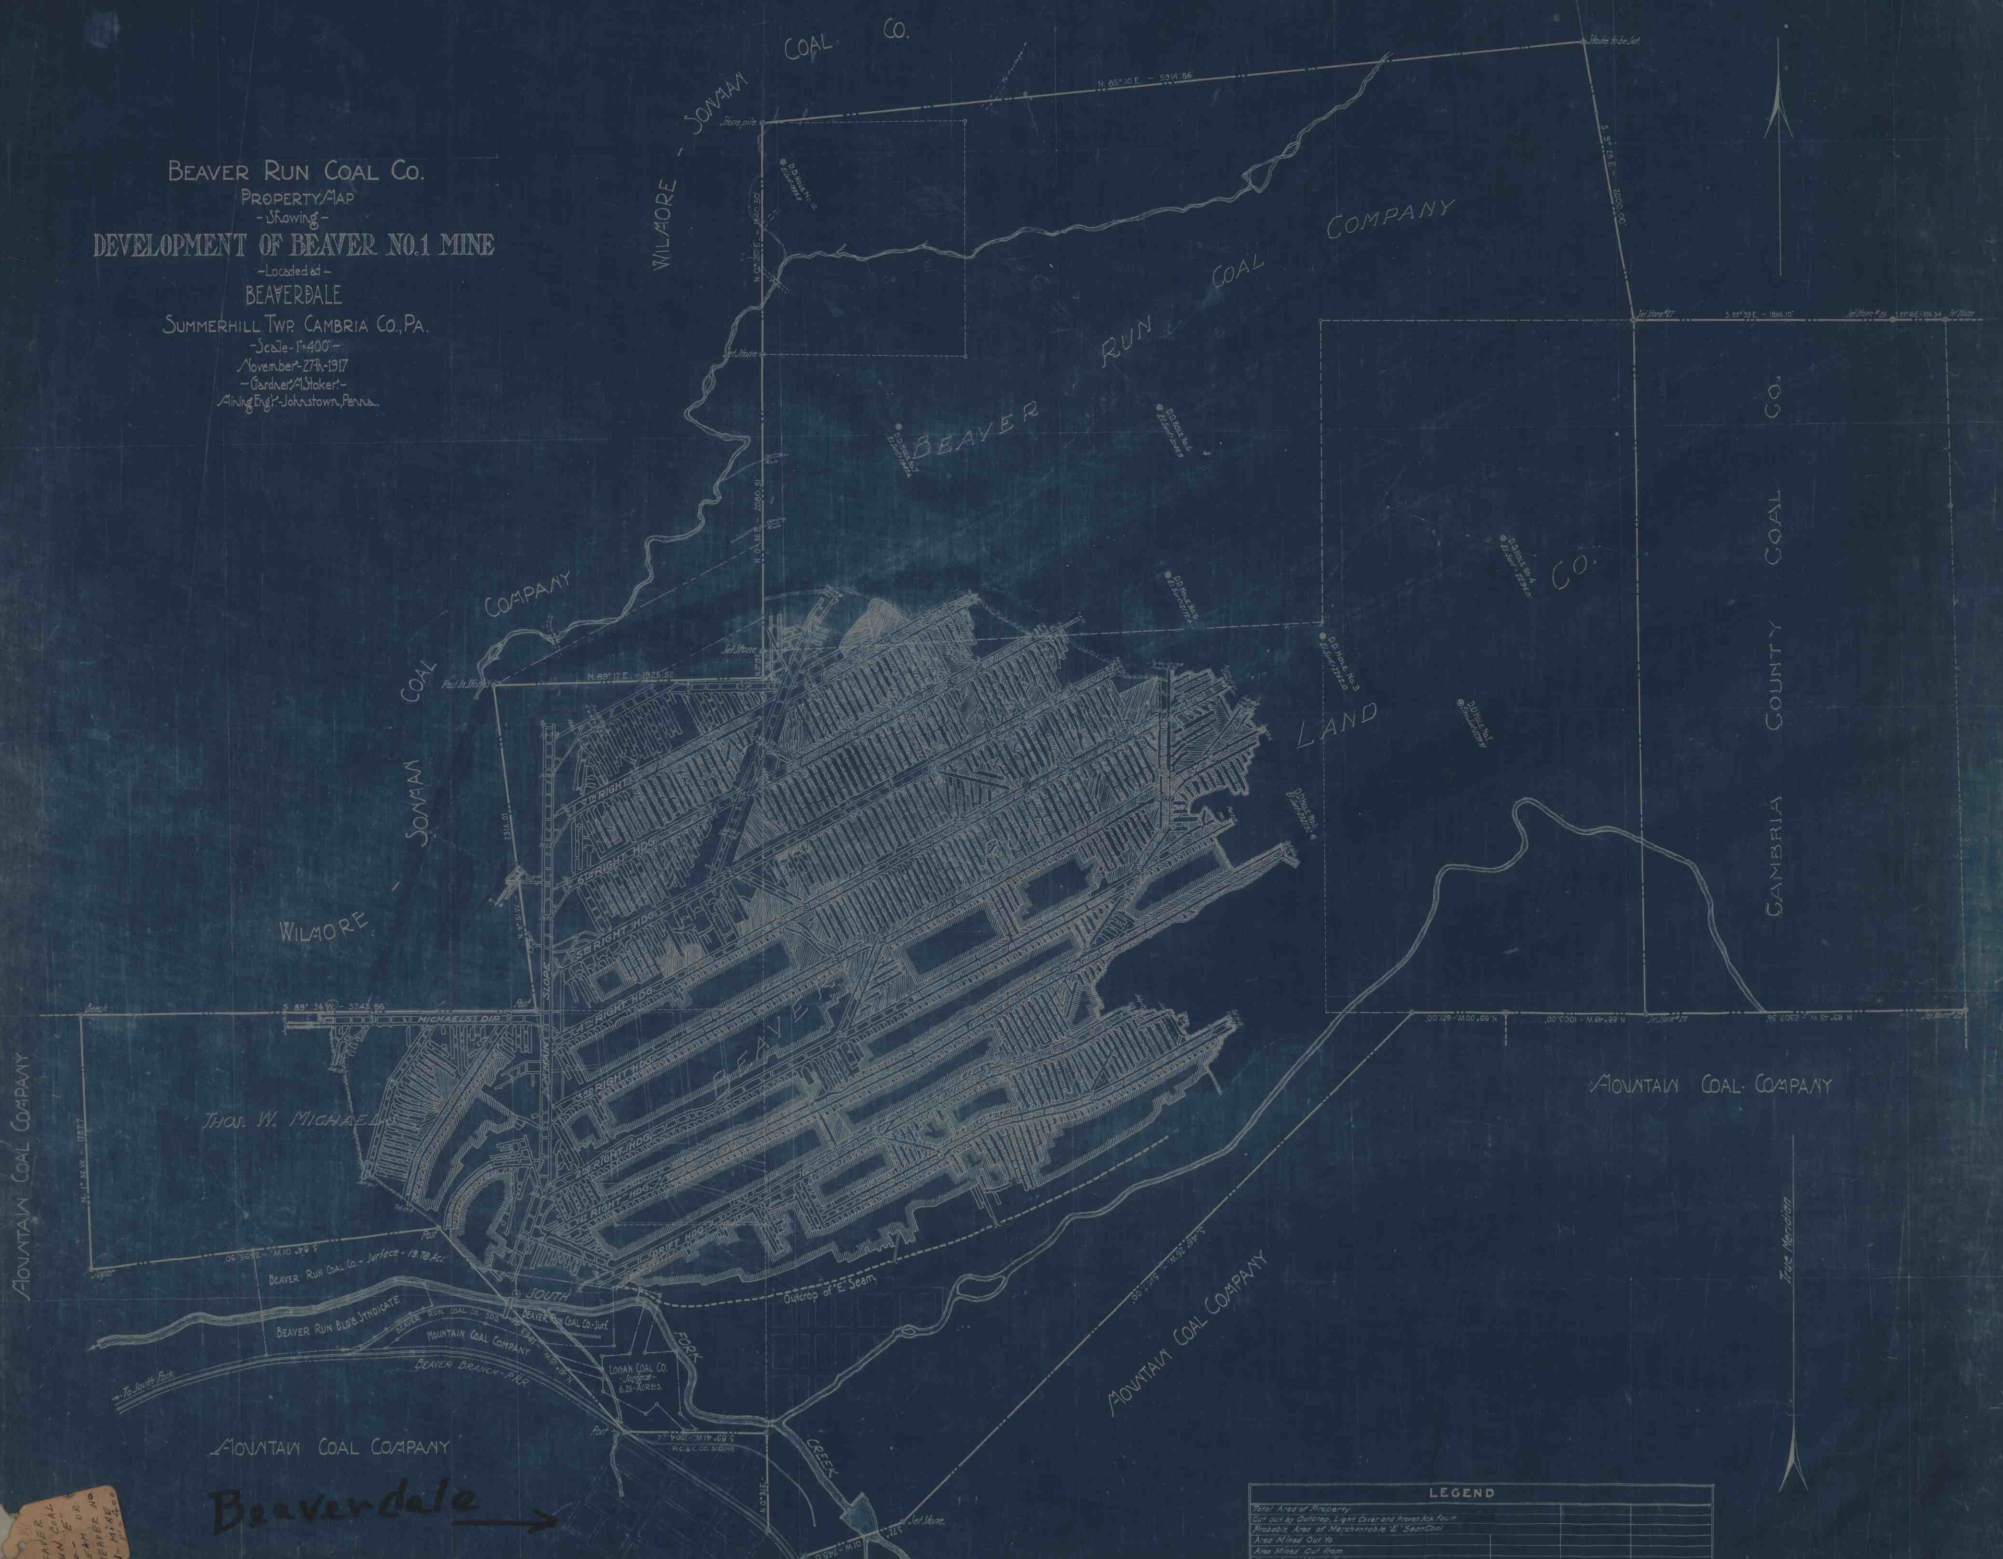

MOUNTAIN COAL COMPANY

Beaverdale →

LEGEND



BEAVER RUN COAL Co.
 -Showing-
 DEVELOPMENT OF BEAVER NO.1 MINE