

1231

GLEN WHITE COAL & LUMBER

Cavalier Coal Co.
Coupon

D
1343A

Samuel Black Warrant

Thomas Black Warrant

315' Coal
11' Bank
1015.4
73
0.D.H.N.S.
SURF 2208.0
BOT COAL 1138.8

1050'
1015.4
0.D.H.N.S.
SURF 2143.8
BOT COAL 2089.7
Cleared
4-38'

11350
0.D.H.N.S.
SURF 2197.5
BOT COAL 2042.8


559° 33'E

1635

1634.6

Post In Stones

2293.0

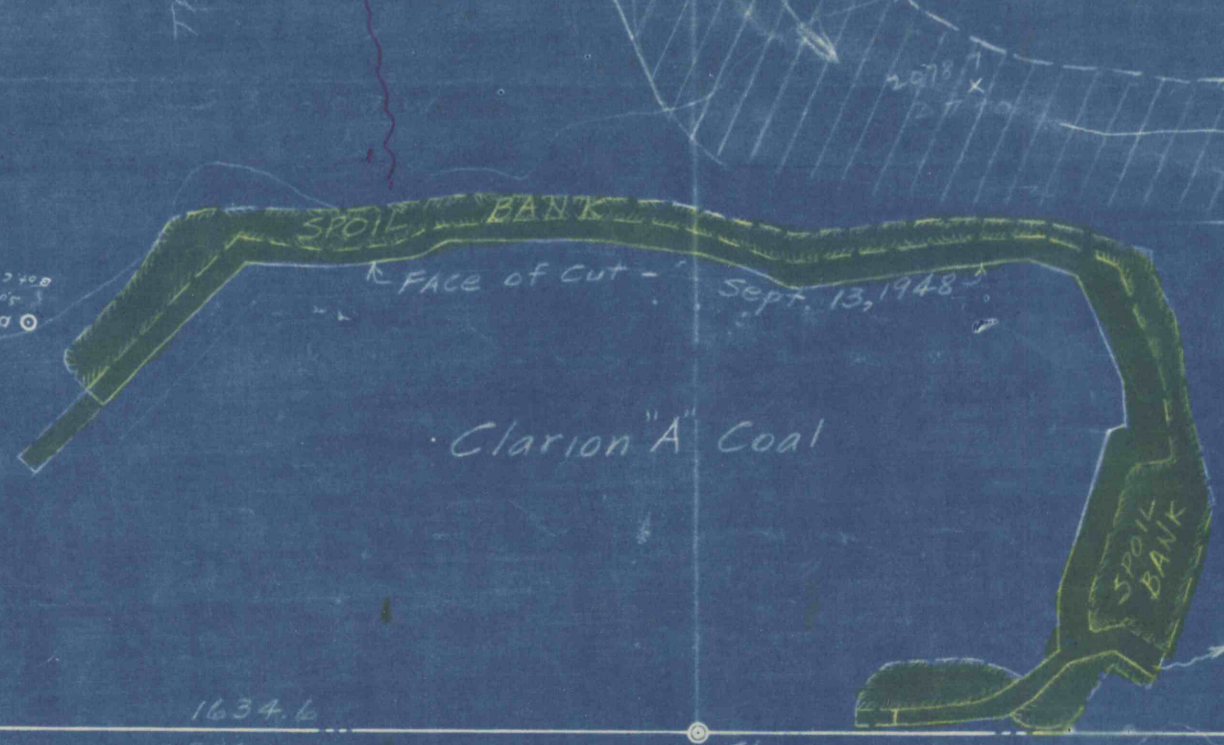


Provisions of law
Carried out in this area.

Mined
After Jan 18, 1948
Mined Previous
to Jan 18, 1948

OUTCROP

LOWER

124.851 Acres
DRAINAGE

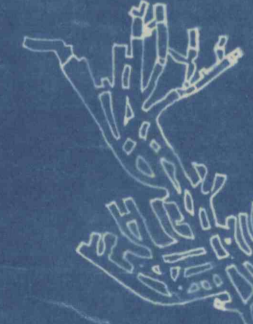

8" PIPE
PRESENT
CATCH
BASIN

10" PIPE LINES
BY-PASSES ALTOONA RESERVOIR

~~XXXXXXXXXX~~
~~XXXXXXXXXX~~
~~XXXXXXXXXX~~

BT