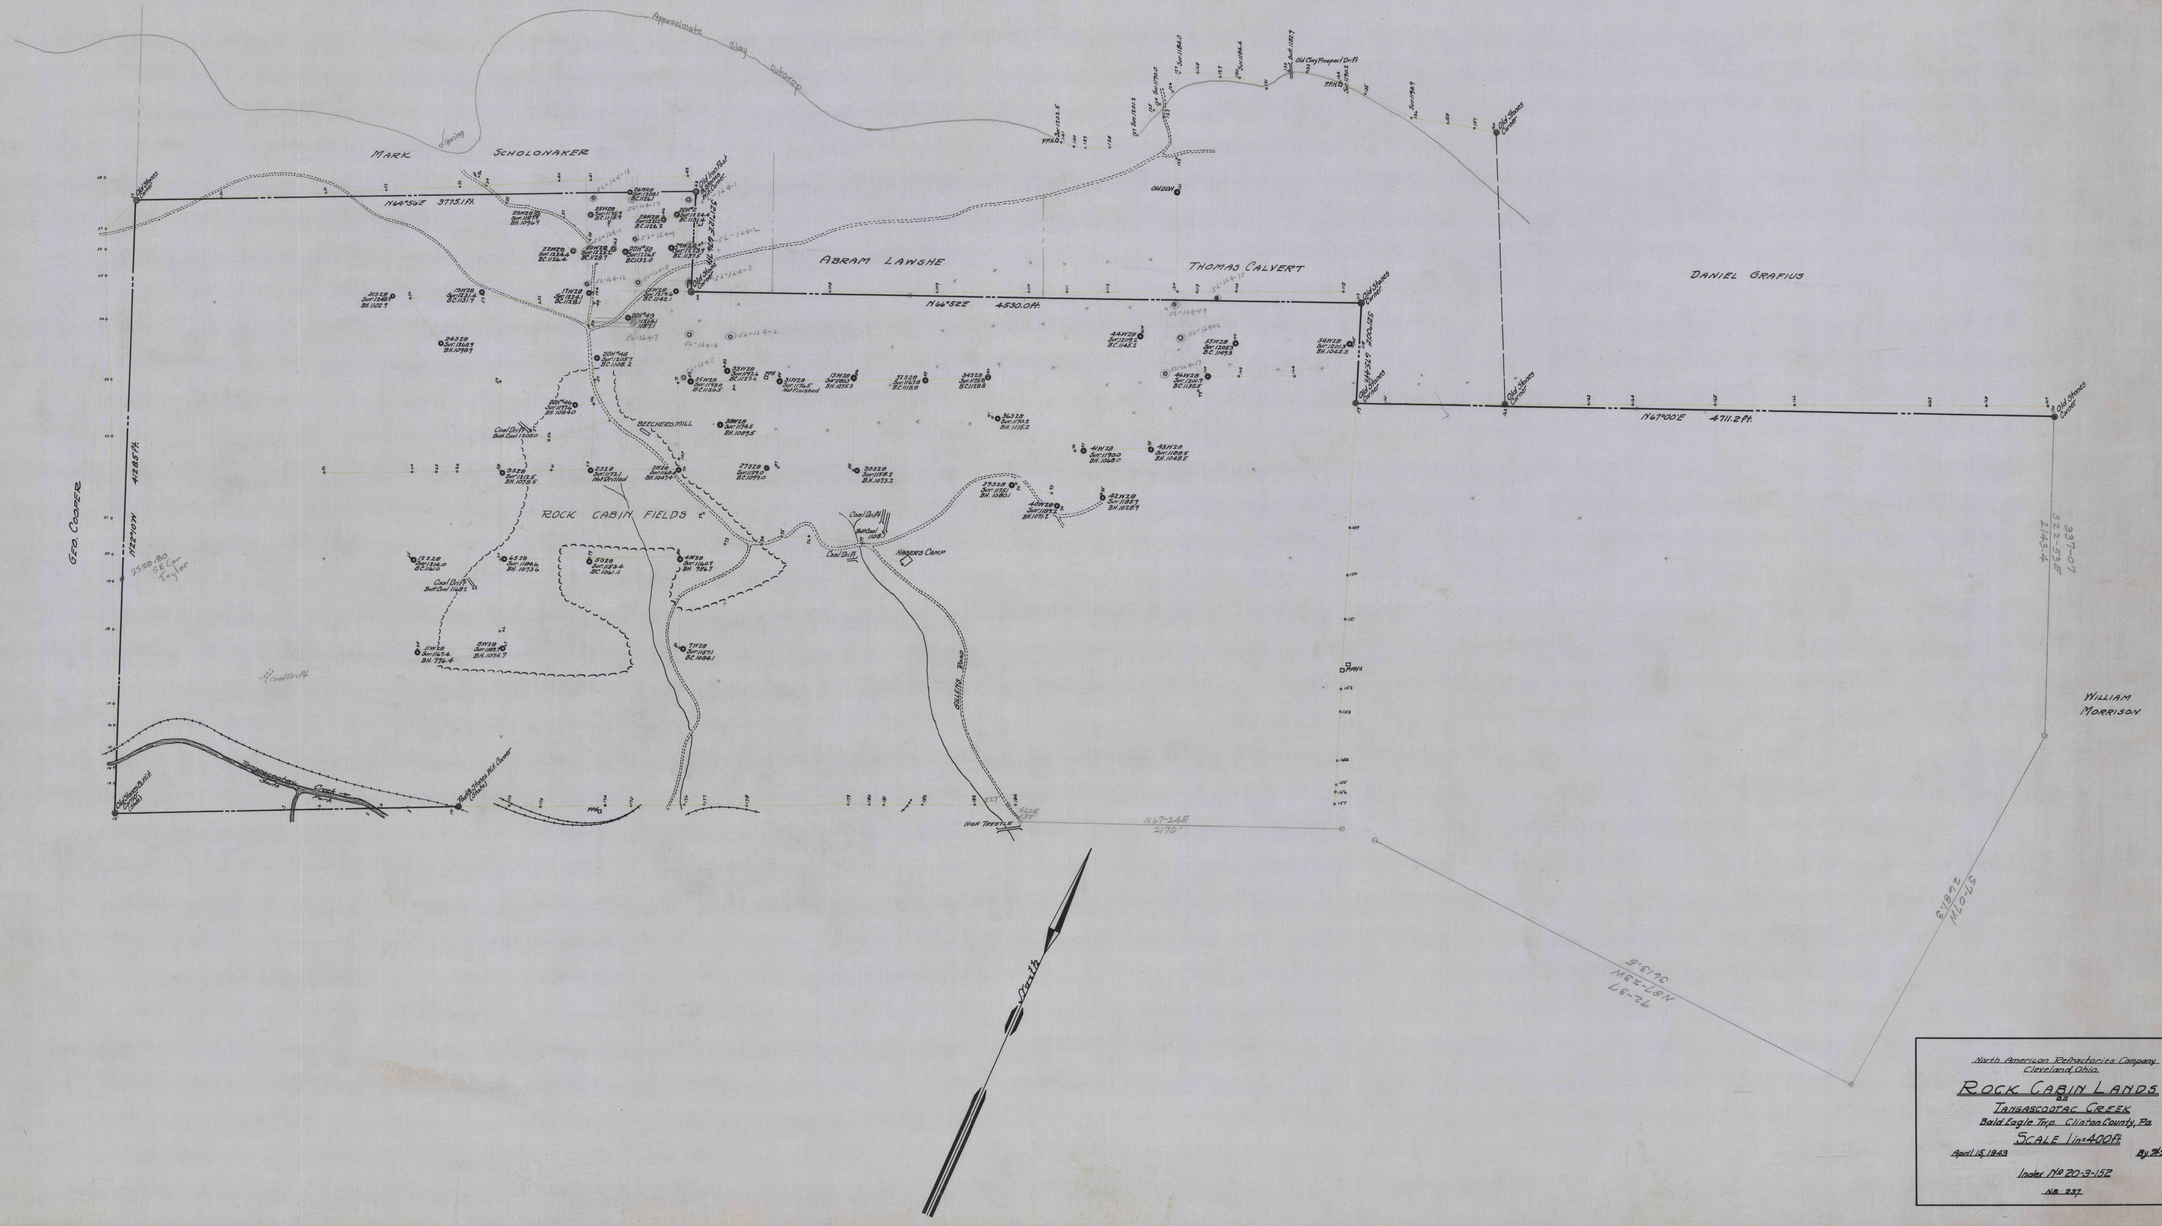

North American Refractories Company
Cleveland, Ohio.

ROCK CABIN LANDS
near
TANASBOOTAC CREEK
Bald Eagle Twp. Clinton County, Pa.

SCALE 1 in. = 400 ft.

April 15, 1943 By J.H.J.

Index No. 20-3-152

No. 237