


MAP OF THE WORKINGS
- OF THE -
SYLVANIA MINE,
- IN RELATION -
- TO THE -
"SHOFF'S MINE PROPERTY."

MADISON, CLEARFIELD CO. PA.
SCALE 1:400
CLEARFIELD PA. OFFICE OF E.V. HISS,
JUNE 24, 1914. ENGINEER.

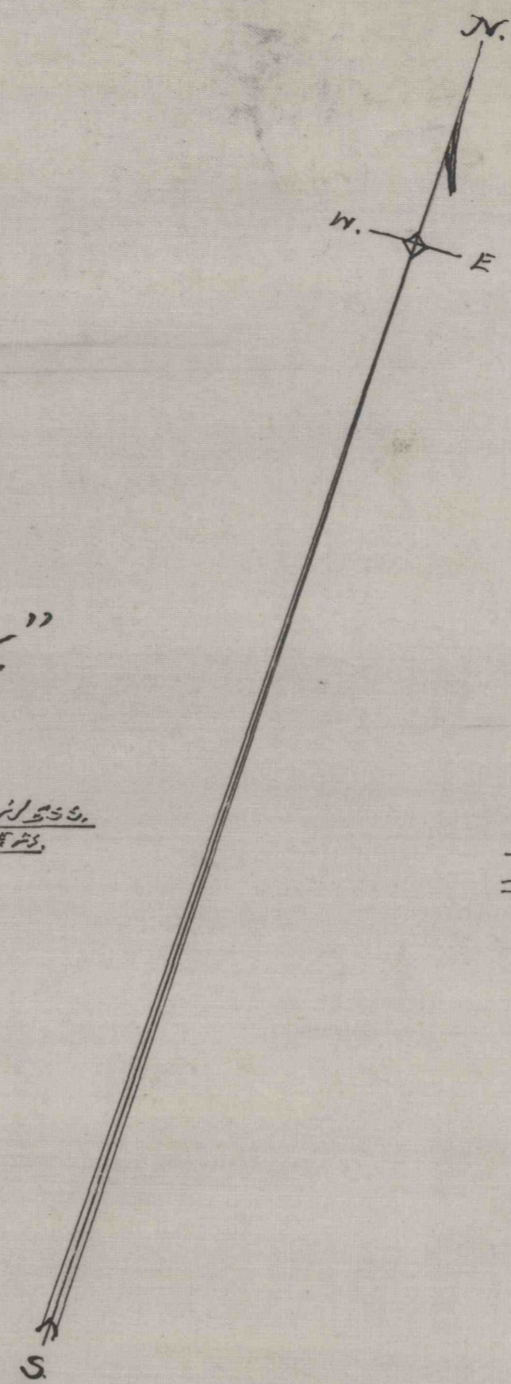

110219