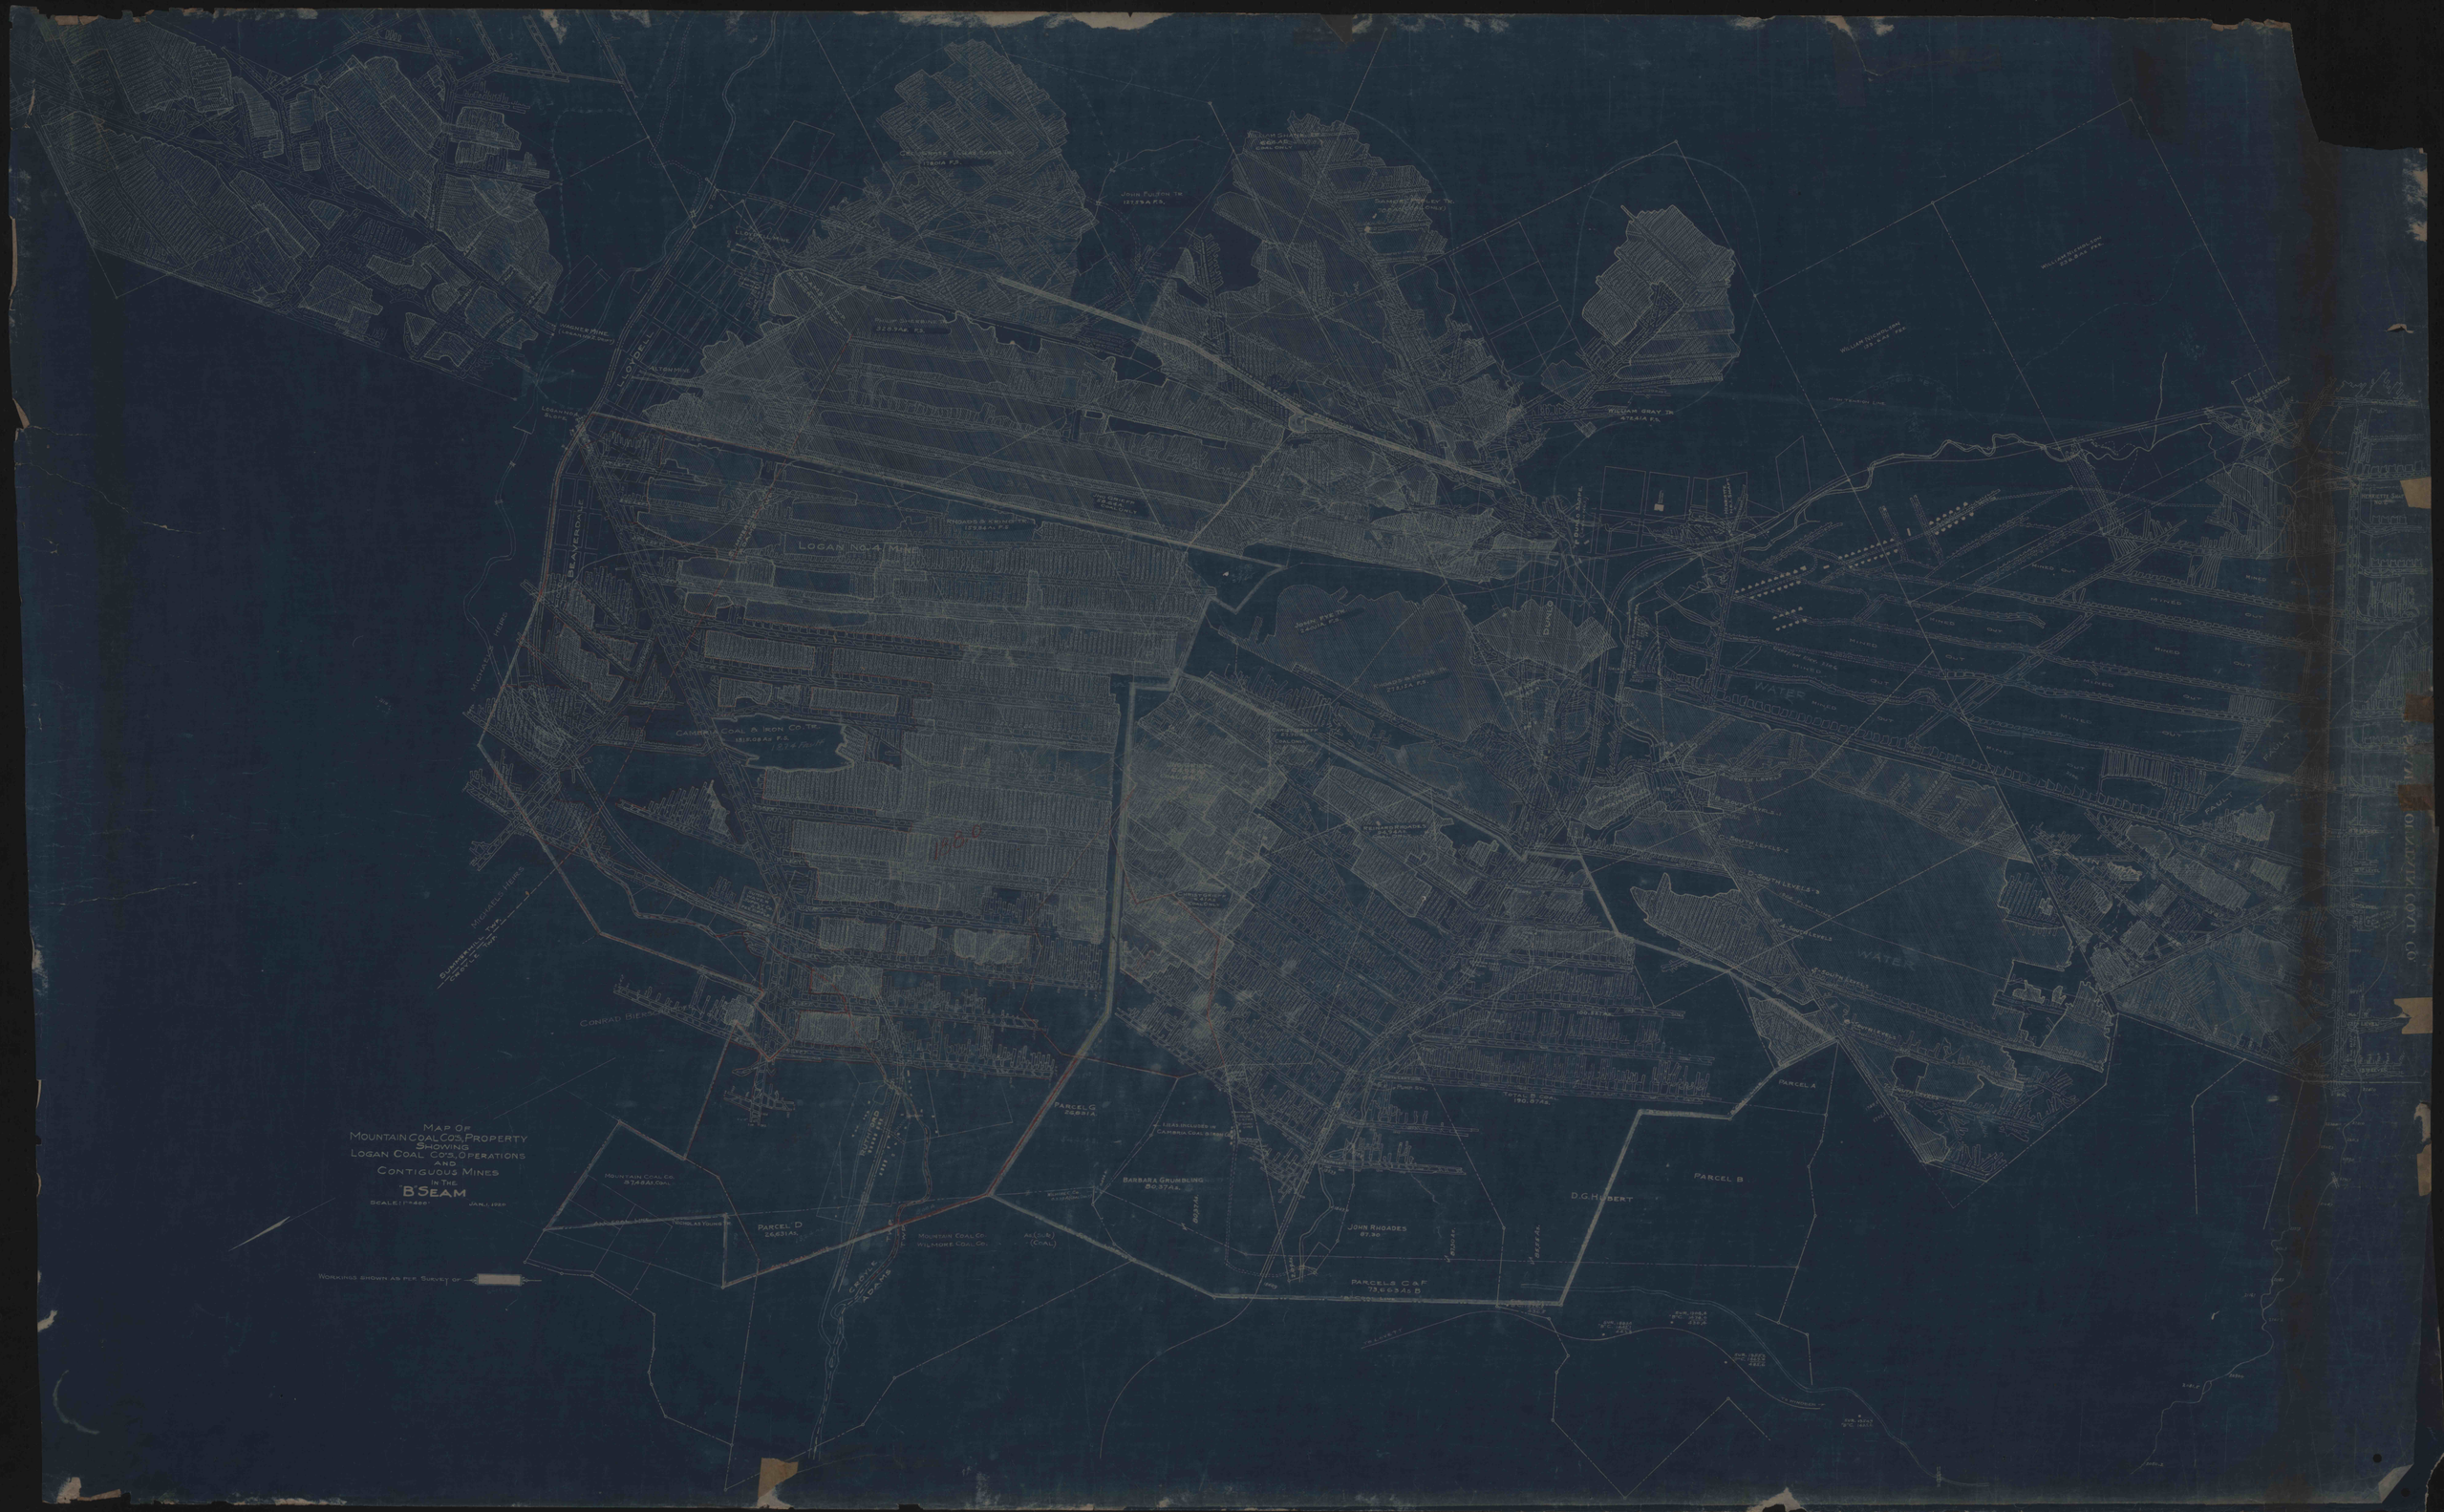
MAP OF
MOUNTAIN COAL CO'S, PROPERTY
SHOWING
LOGAN COAL CO'S, OPERATIONS
AND
CONTIGUOUS MINES
IN THE
"B" SEAM
SCALE: 1" = 400'
JAN. 1, 1920
WORKINGS SHOWN AS PER SURVEY OF
LOGAN NO. 4 MINE
CAMBRIA COAL & IRON CO. TR.
BEAVERDALE
LLOYDELL
WATER
PARCEL A
PARCEL B
PARCEL C
PARCEL D
D.G. HUBERT
JOHN RHOADES
BARBARA GRUMBLING
MOUNTAIN COAL CO.
WILMORE COAL CO.
CONRAD BIERSCH
MICHAEL'S HEIRS
SUMMERHILL TWP.
CROYLE TWP.
ADAMS TWP.
MINED OUT