

CAMBRIA COUNTY COAL CO.


MAP SHOWING

"D SEAM LEASES ON PROPERTY

IN

SIMMERHILL & PORTAGE TOWNSHIPS

CAMBRIA COUNTY  
PENNSYLVANIA  
Scale: 1/32 of an Inch = 100 Feet  
Map by  
J. S. G. Co.

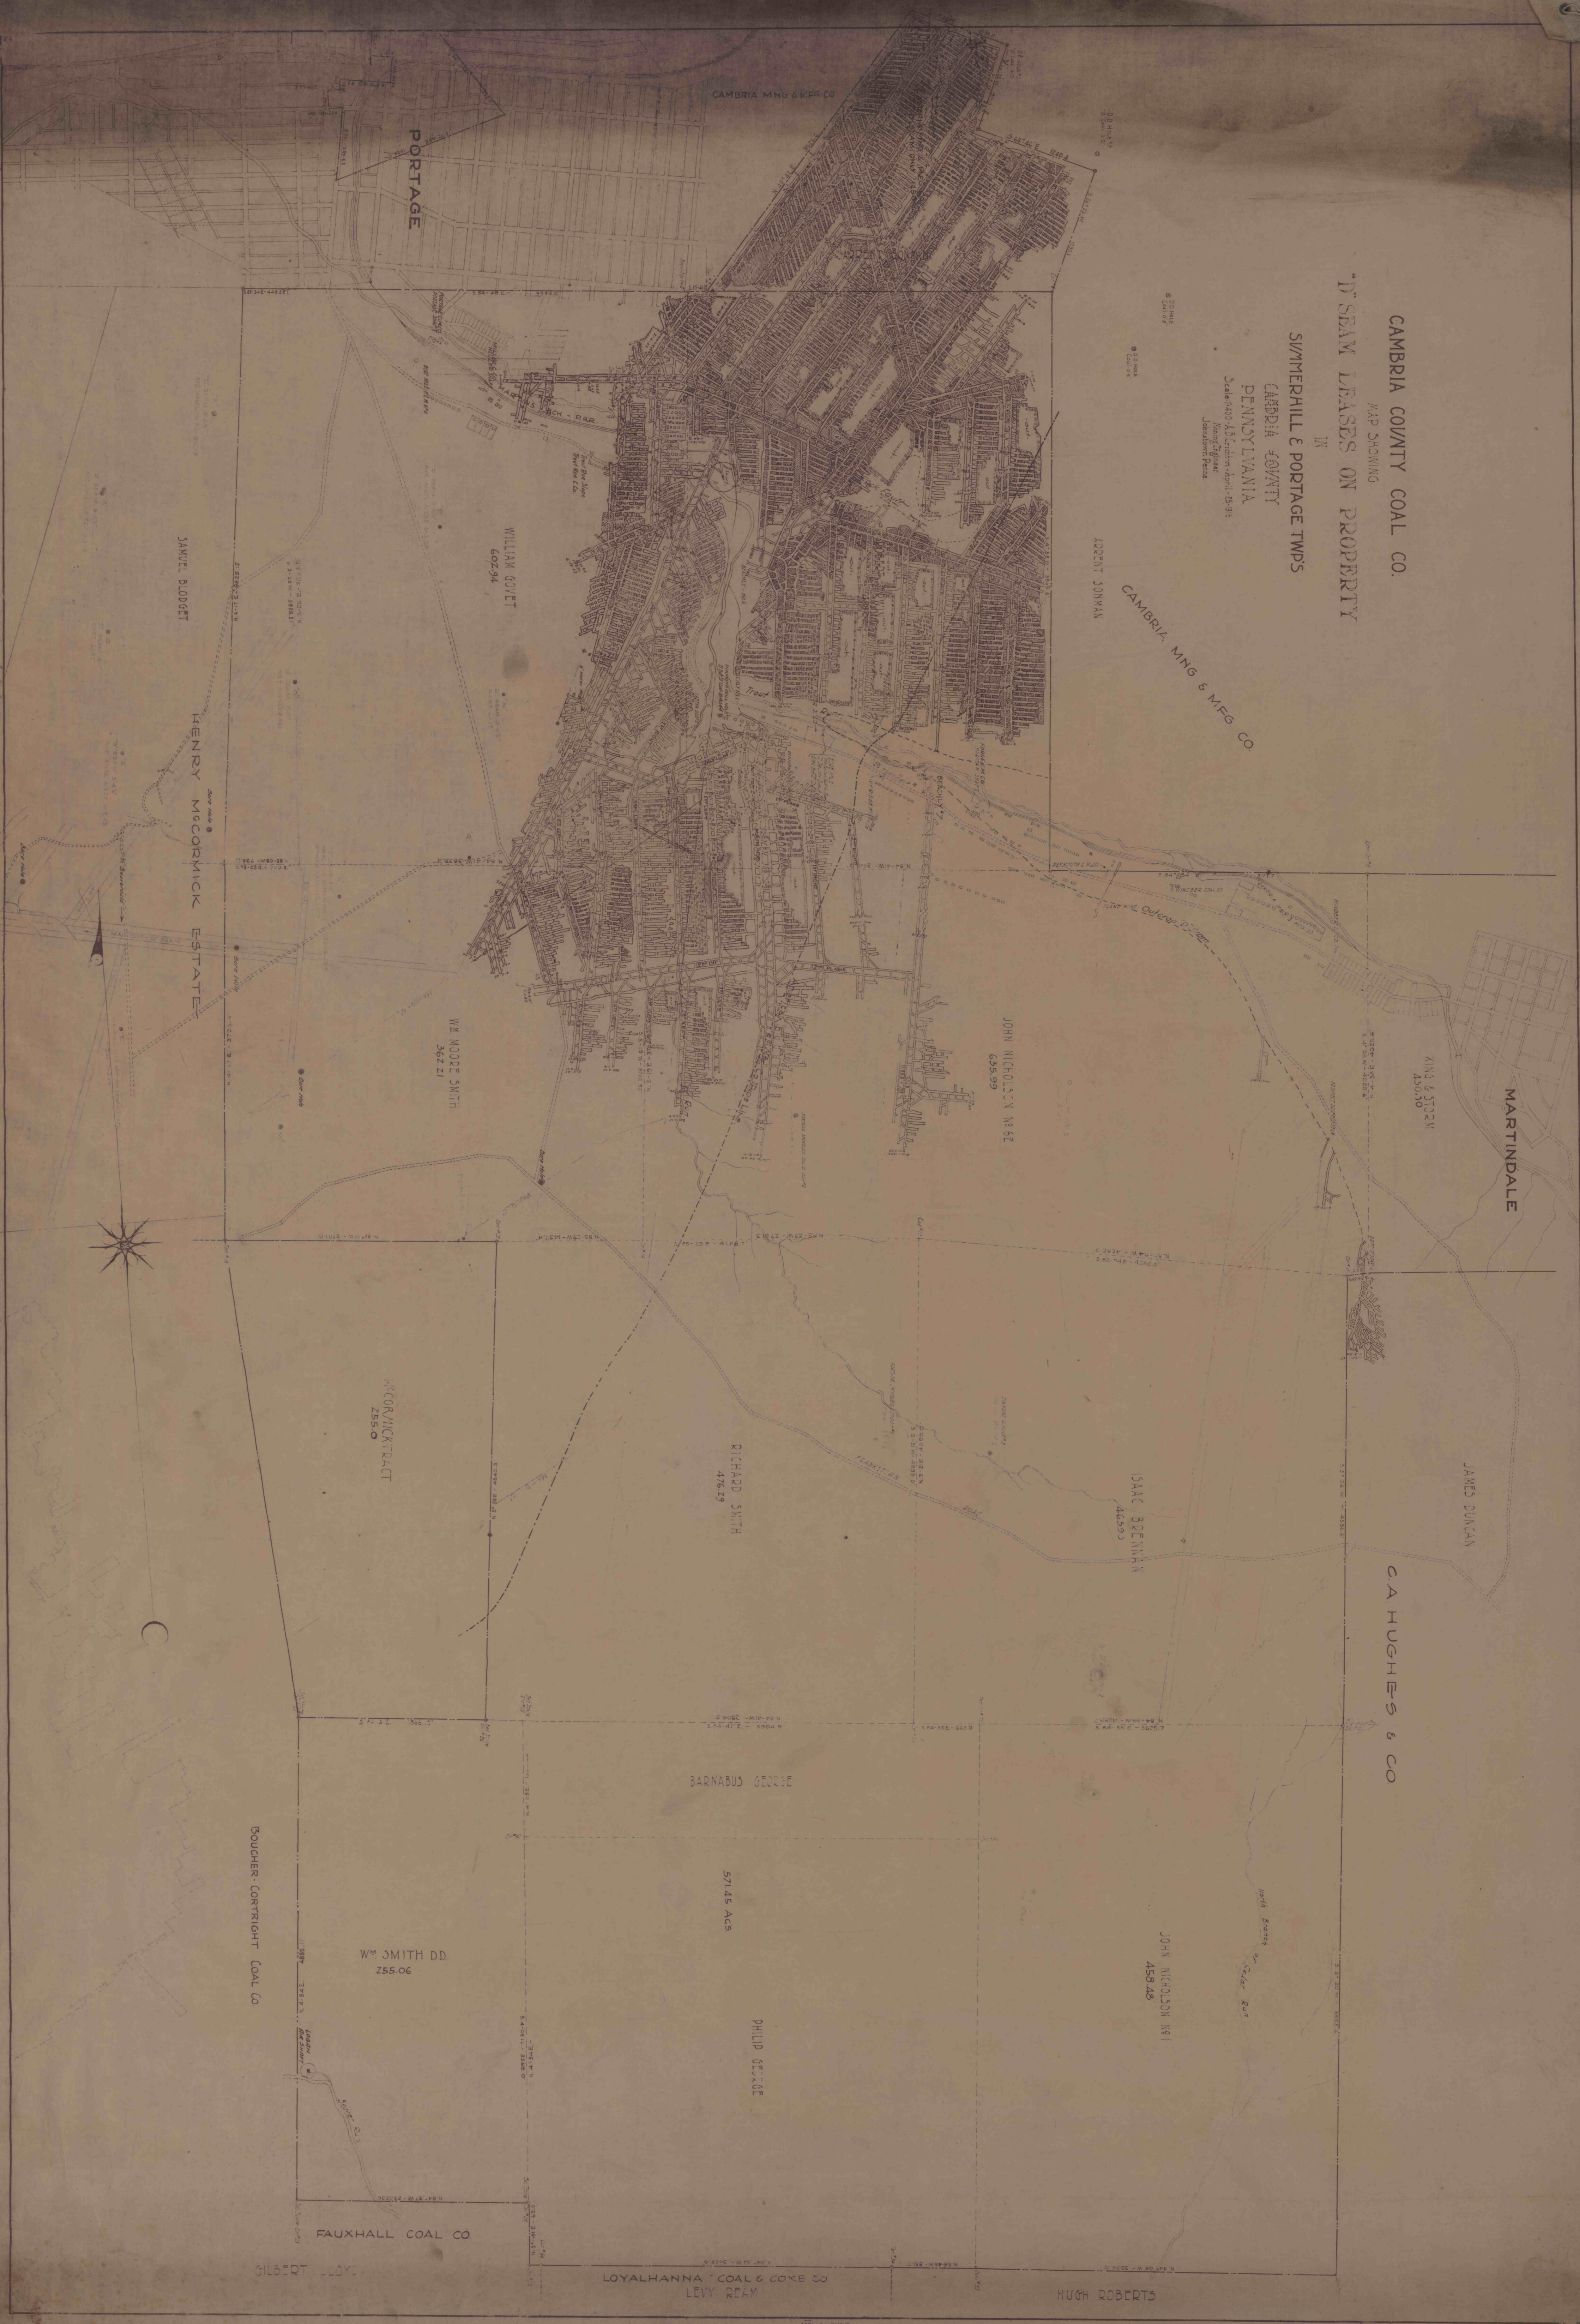

MARTINDALE

MING & STORM  
450.10

JAMES DUNCAN

C. A. HUGHES & CO

ISAAC BERNARD  
465.99

JOHN NICHOLSON NE 1  
459.48

JOHN NICHOLSON N 8 E 2  
695.99

RICHARD SMITH  
476.29

BARNABUS GEORGE

571.45 Acs

PHILIP GEORGE

WM SMITH DD  
255.06

MCCORMICK TRACT  
255.0

MR MOORE SMITH  
362.21

WILLIAM GOVET  
602.94

HENRY MCCORMICK ESTATE

JAMES BLODGETT

BOUCHER CONTRIGHT COAL CO

FAUXHALL COAL CO

GILBERT LLOYD

LOYALHANNA COAL & COKE CO  
LEVY REAM

HUGH ROBERTS

PORTAGE

CAMBRIA MFG & COKE CO

CAMBRIA MFG & MFG CO  
ADRIAN SONNMAN