


2525

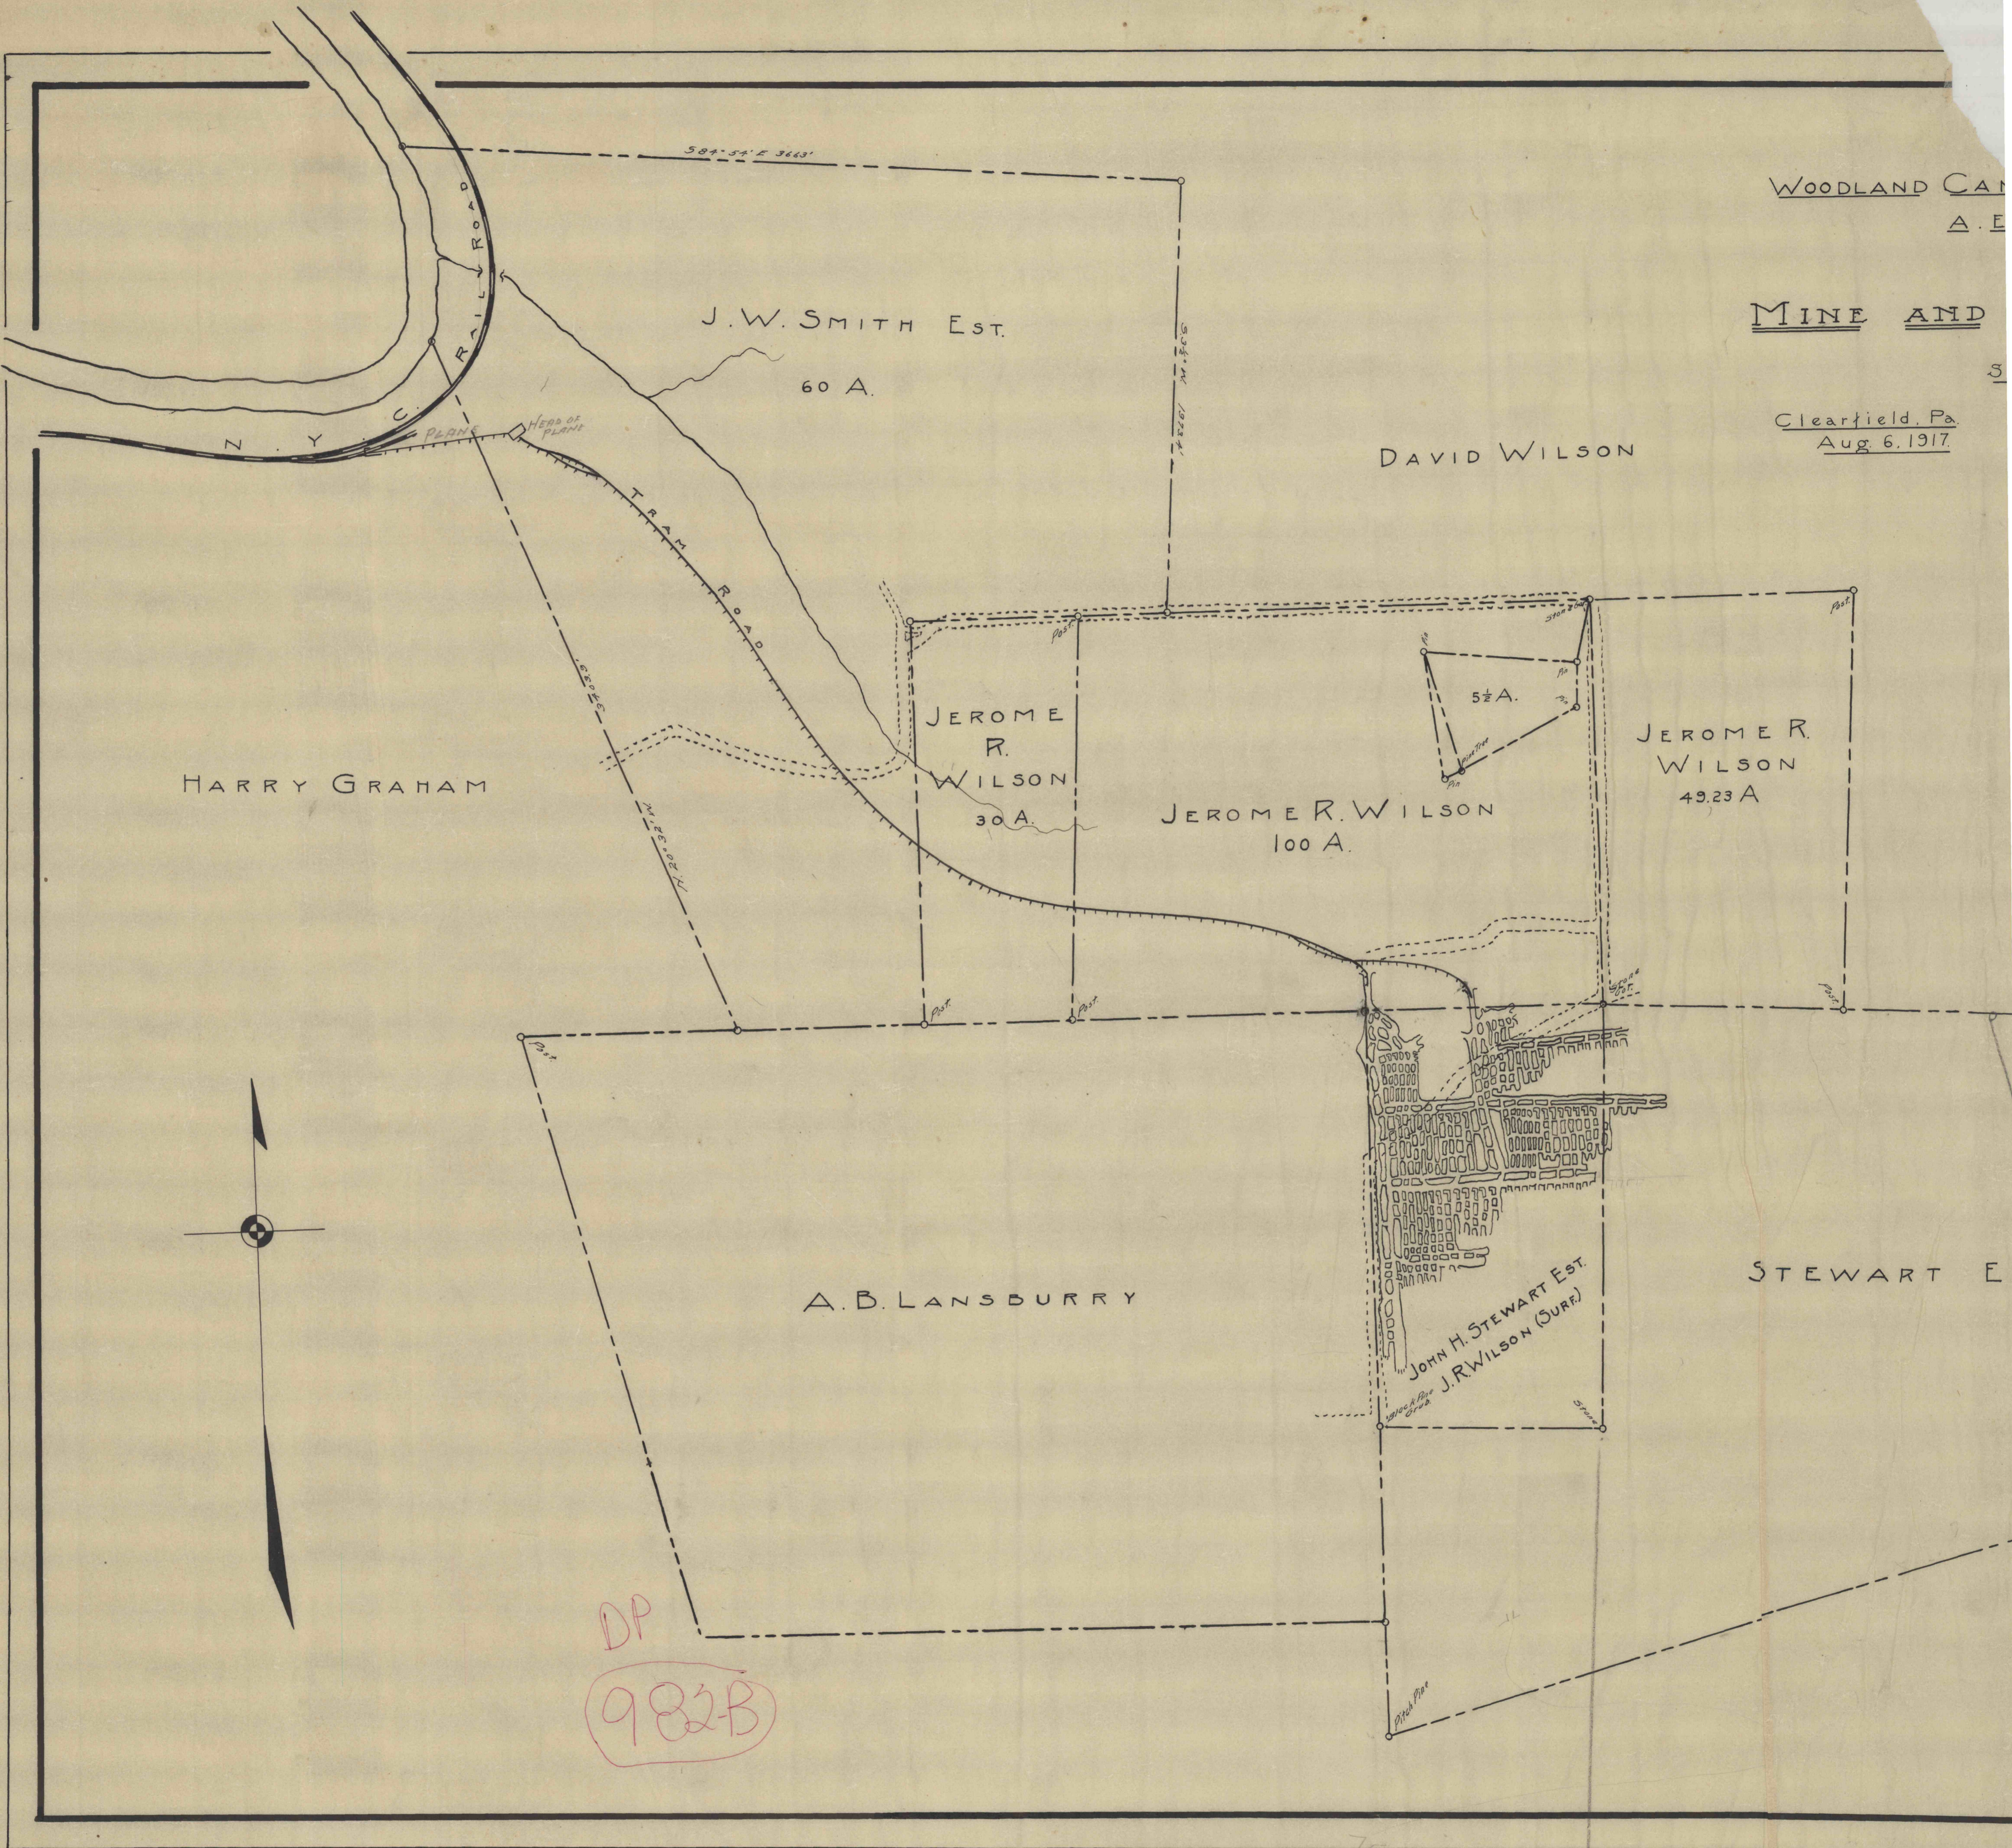

2513