


8229

8128

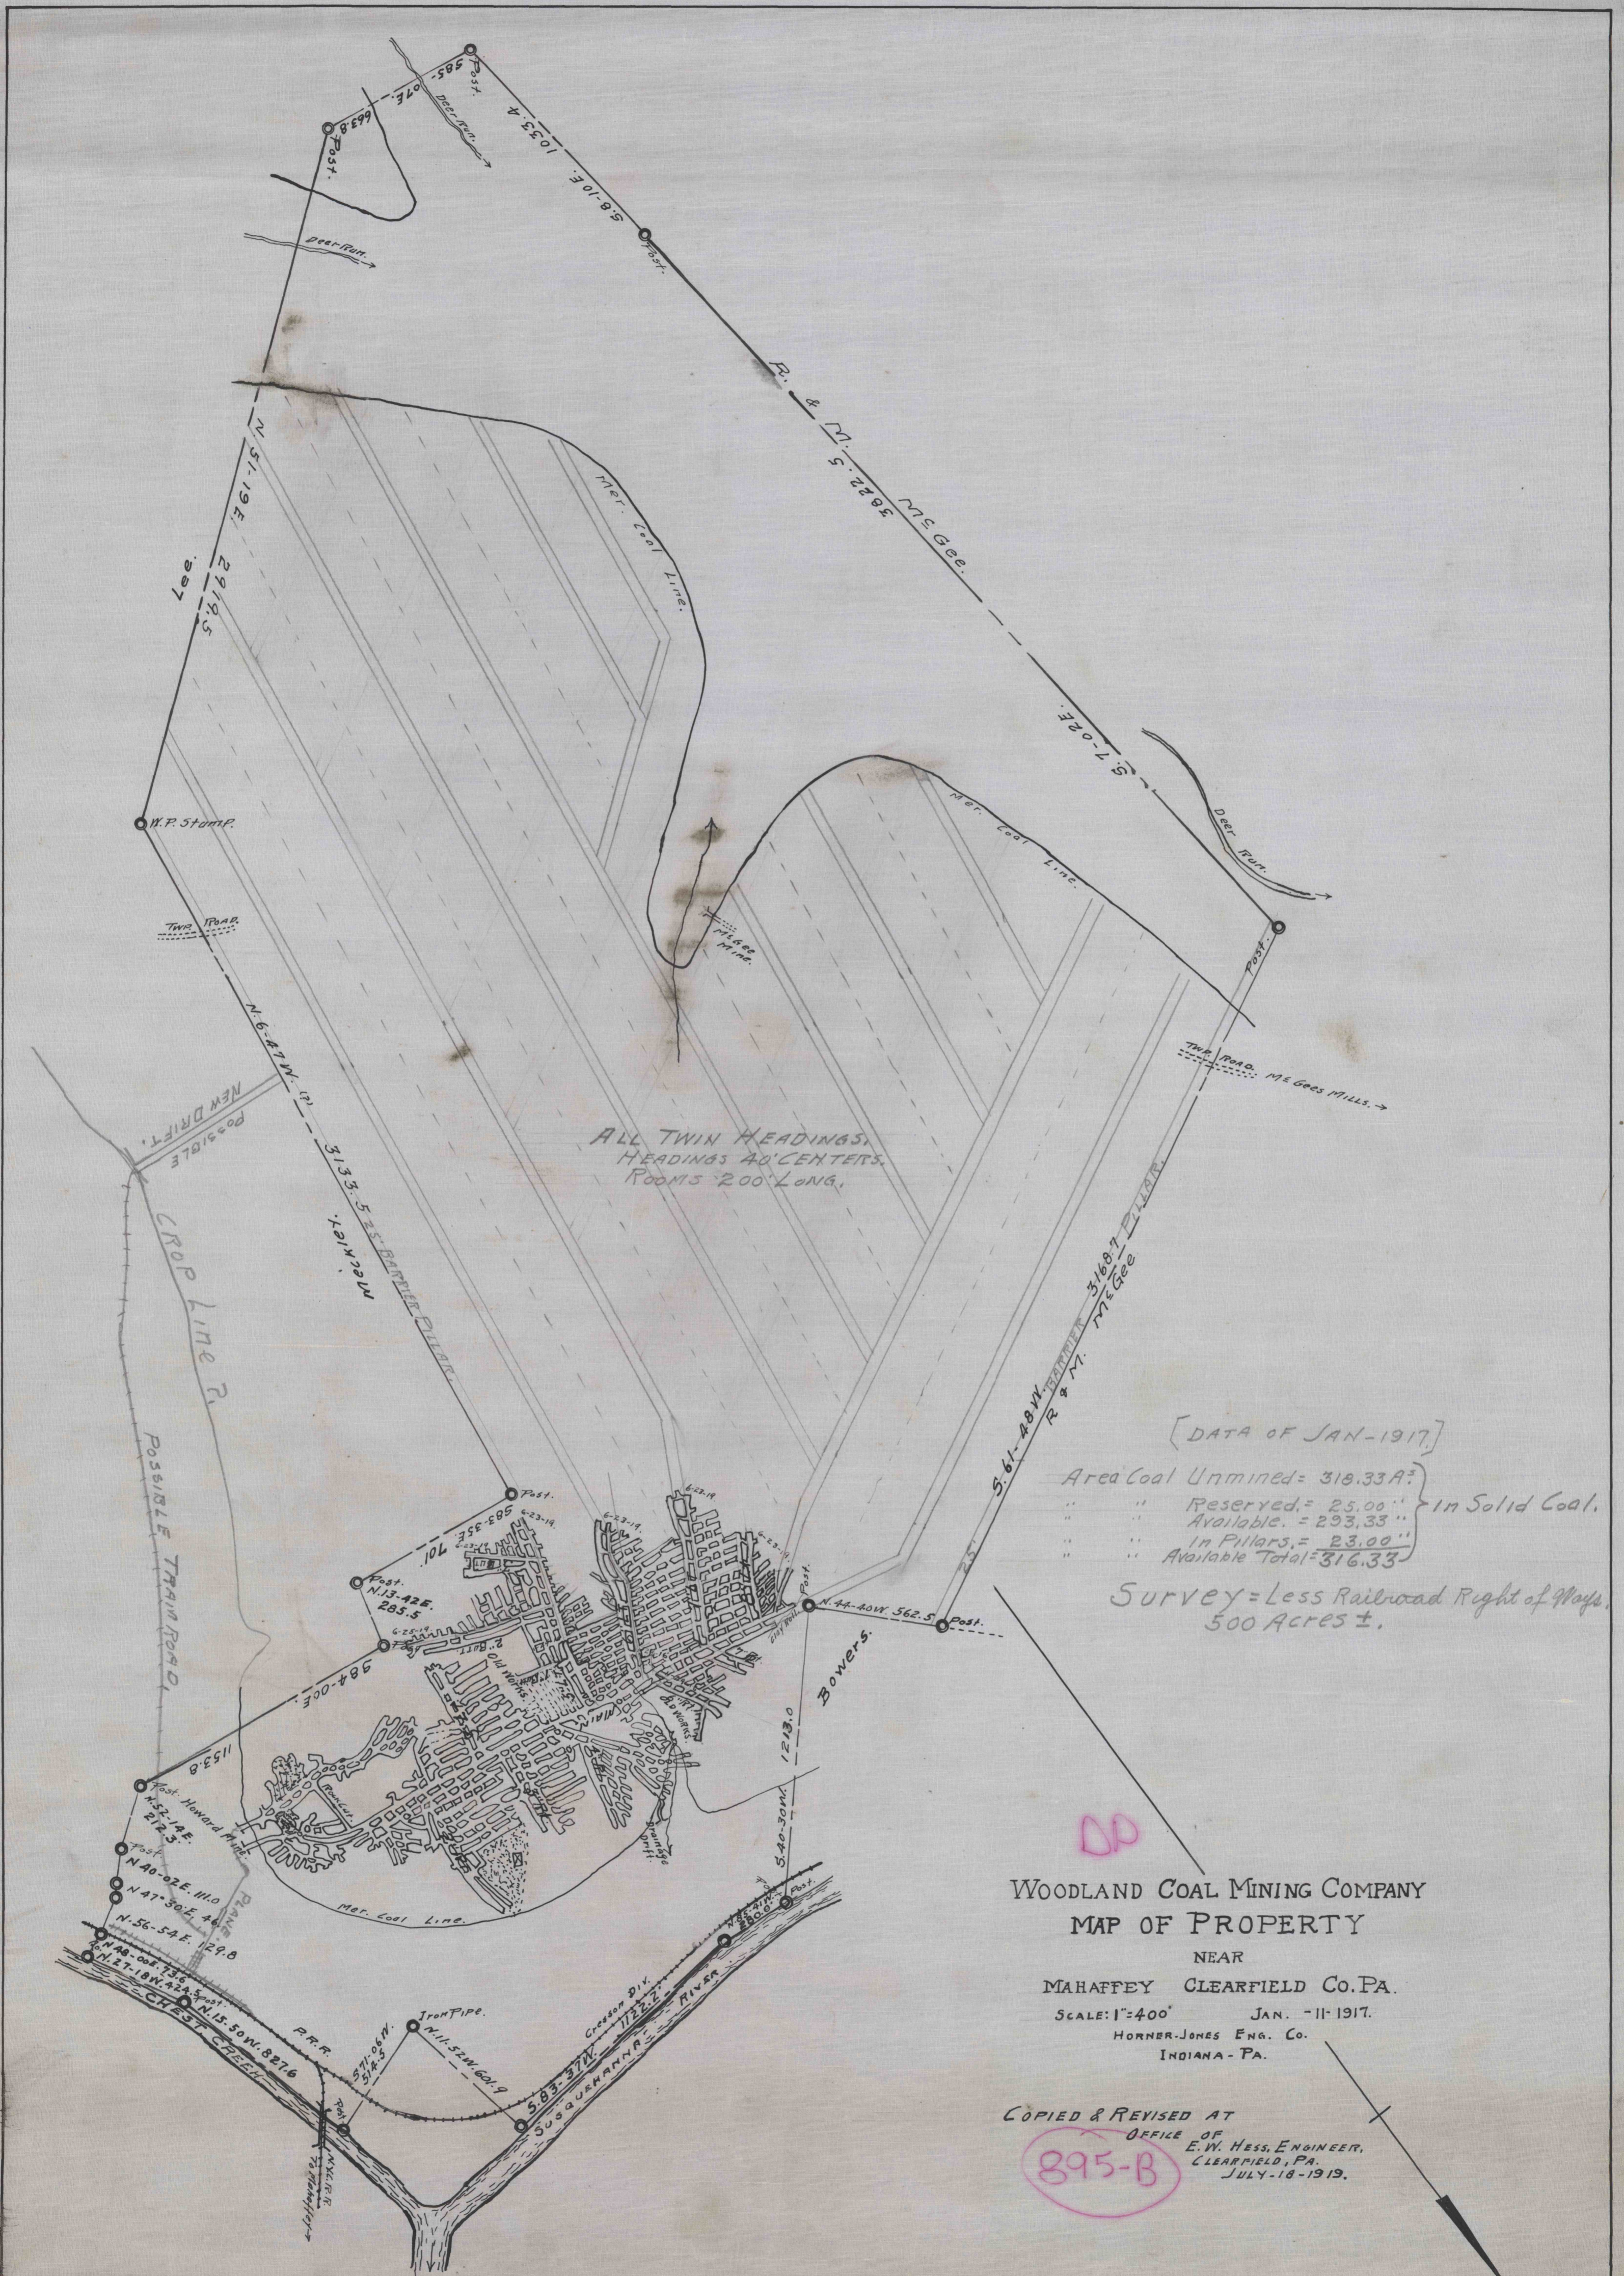

ALL TWIN HEADINGS,  
HEADINGS 40' CENTERS,  
ROOMS 200' LONG.

[DATA OF JAN-1917]

Area Coal Unmined =	318.33 A <sup>2</sup>	} in Solid Coal.
" " Reserved =	25.00 "	
" " Available =	293.33 "	
" " In Pillars =	23.00 "	
Available Total =	316.33	

Survey = Less Railroad Right of Way,  
500 Acres ±.

DD

WOODLAND COAL MINING COMPANY  
MAP OF PROPERTY  
NEAR  
MAHAFFEY CLEARFIELD CO. PA.  
SCALE: 1"=400' JAN. -11-1917.  
HORNER-JONES ENG. CO.  
INDIANA - PA.

COPIED & REVISED AT  
OFFICE OF  
E. W. HESS, ENGINEER,  
CLEARFIELD, PA.  
JULY-18-1919.

895-B

5201

2589