


PROPERTY LINE



TRACT LINE

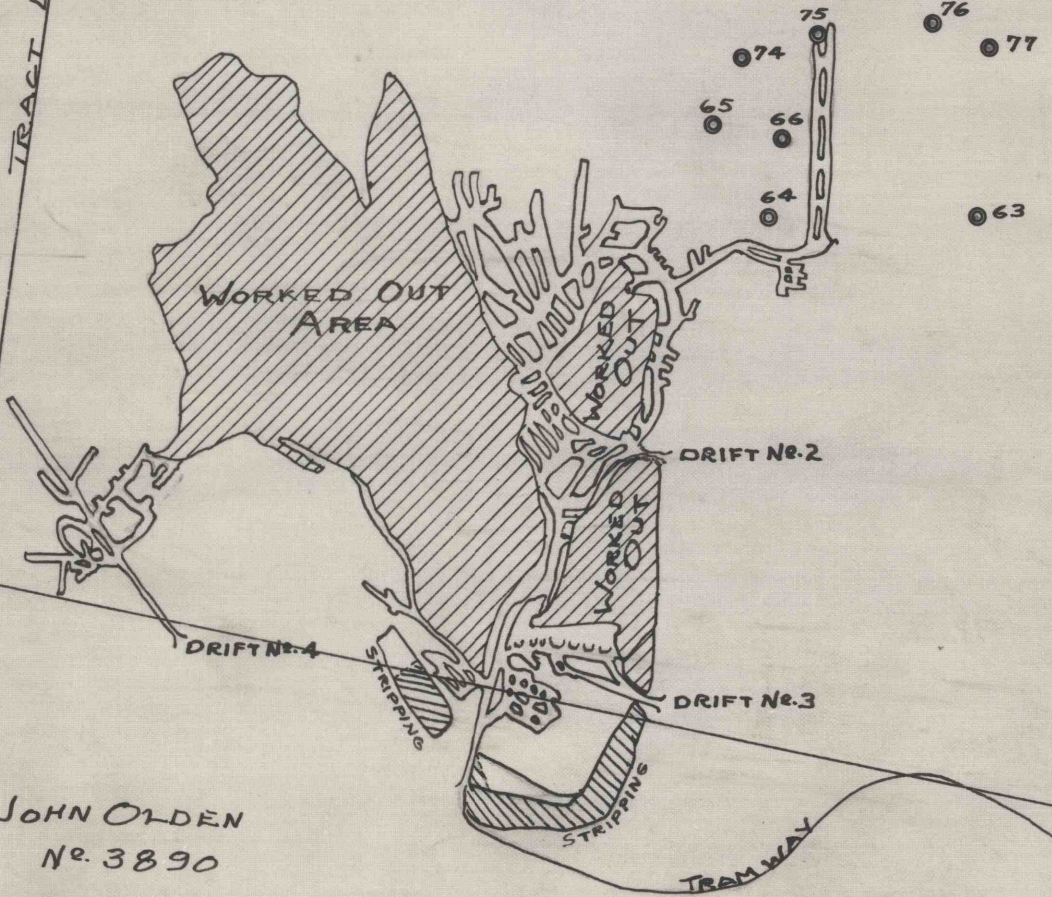

JOHN OLDEN
No 3889

JOHN OLDEN
No. 3890

NORTH AMERICAN REFRACTORIES COMPANY

MAP OF CLAY MINE
AT
WEST BRANCH

SCALE - 1" = 400 FT. DATE - 1-15-31

INDEX - ~~4002 G R~~
26-2-4