

2699

Mc COY HEIRS

ISAAC C. McCLOSKEY


WHARTON COLE

J.W. POTTER TRACT

LAURA PRICE TRACT

FIELDING & SMITH TRACT

outcrop

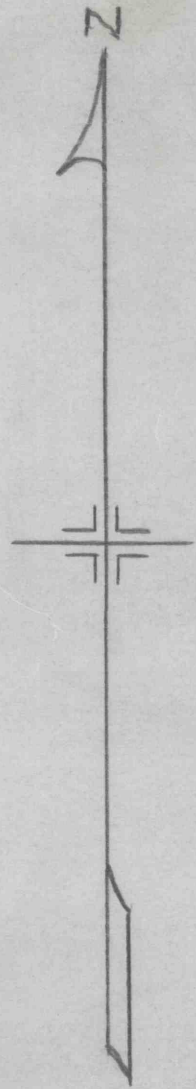

D

— MAP OF J.W. POTTER TRACT —  
KARTHANS TWP. CLEARFIELD CO. PA.  
— scale 1" = 400' — — NOV. 5, 1945. —

NOTE

MINED AREAS SHOWN THUS



C.D. 234

Bernard Lucas  
Thos. F. Morgan Engrs.

1945