


JOHN OLDEN, N<sup>o</sup> 3890.

JOHN OLDEN, N<sup>o</sup> 3890.

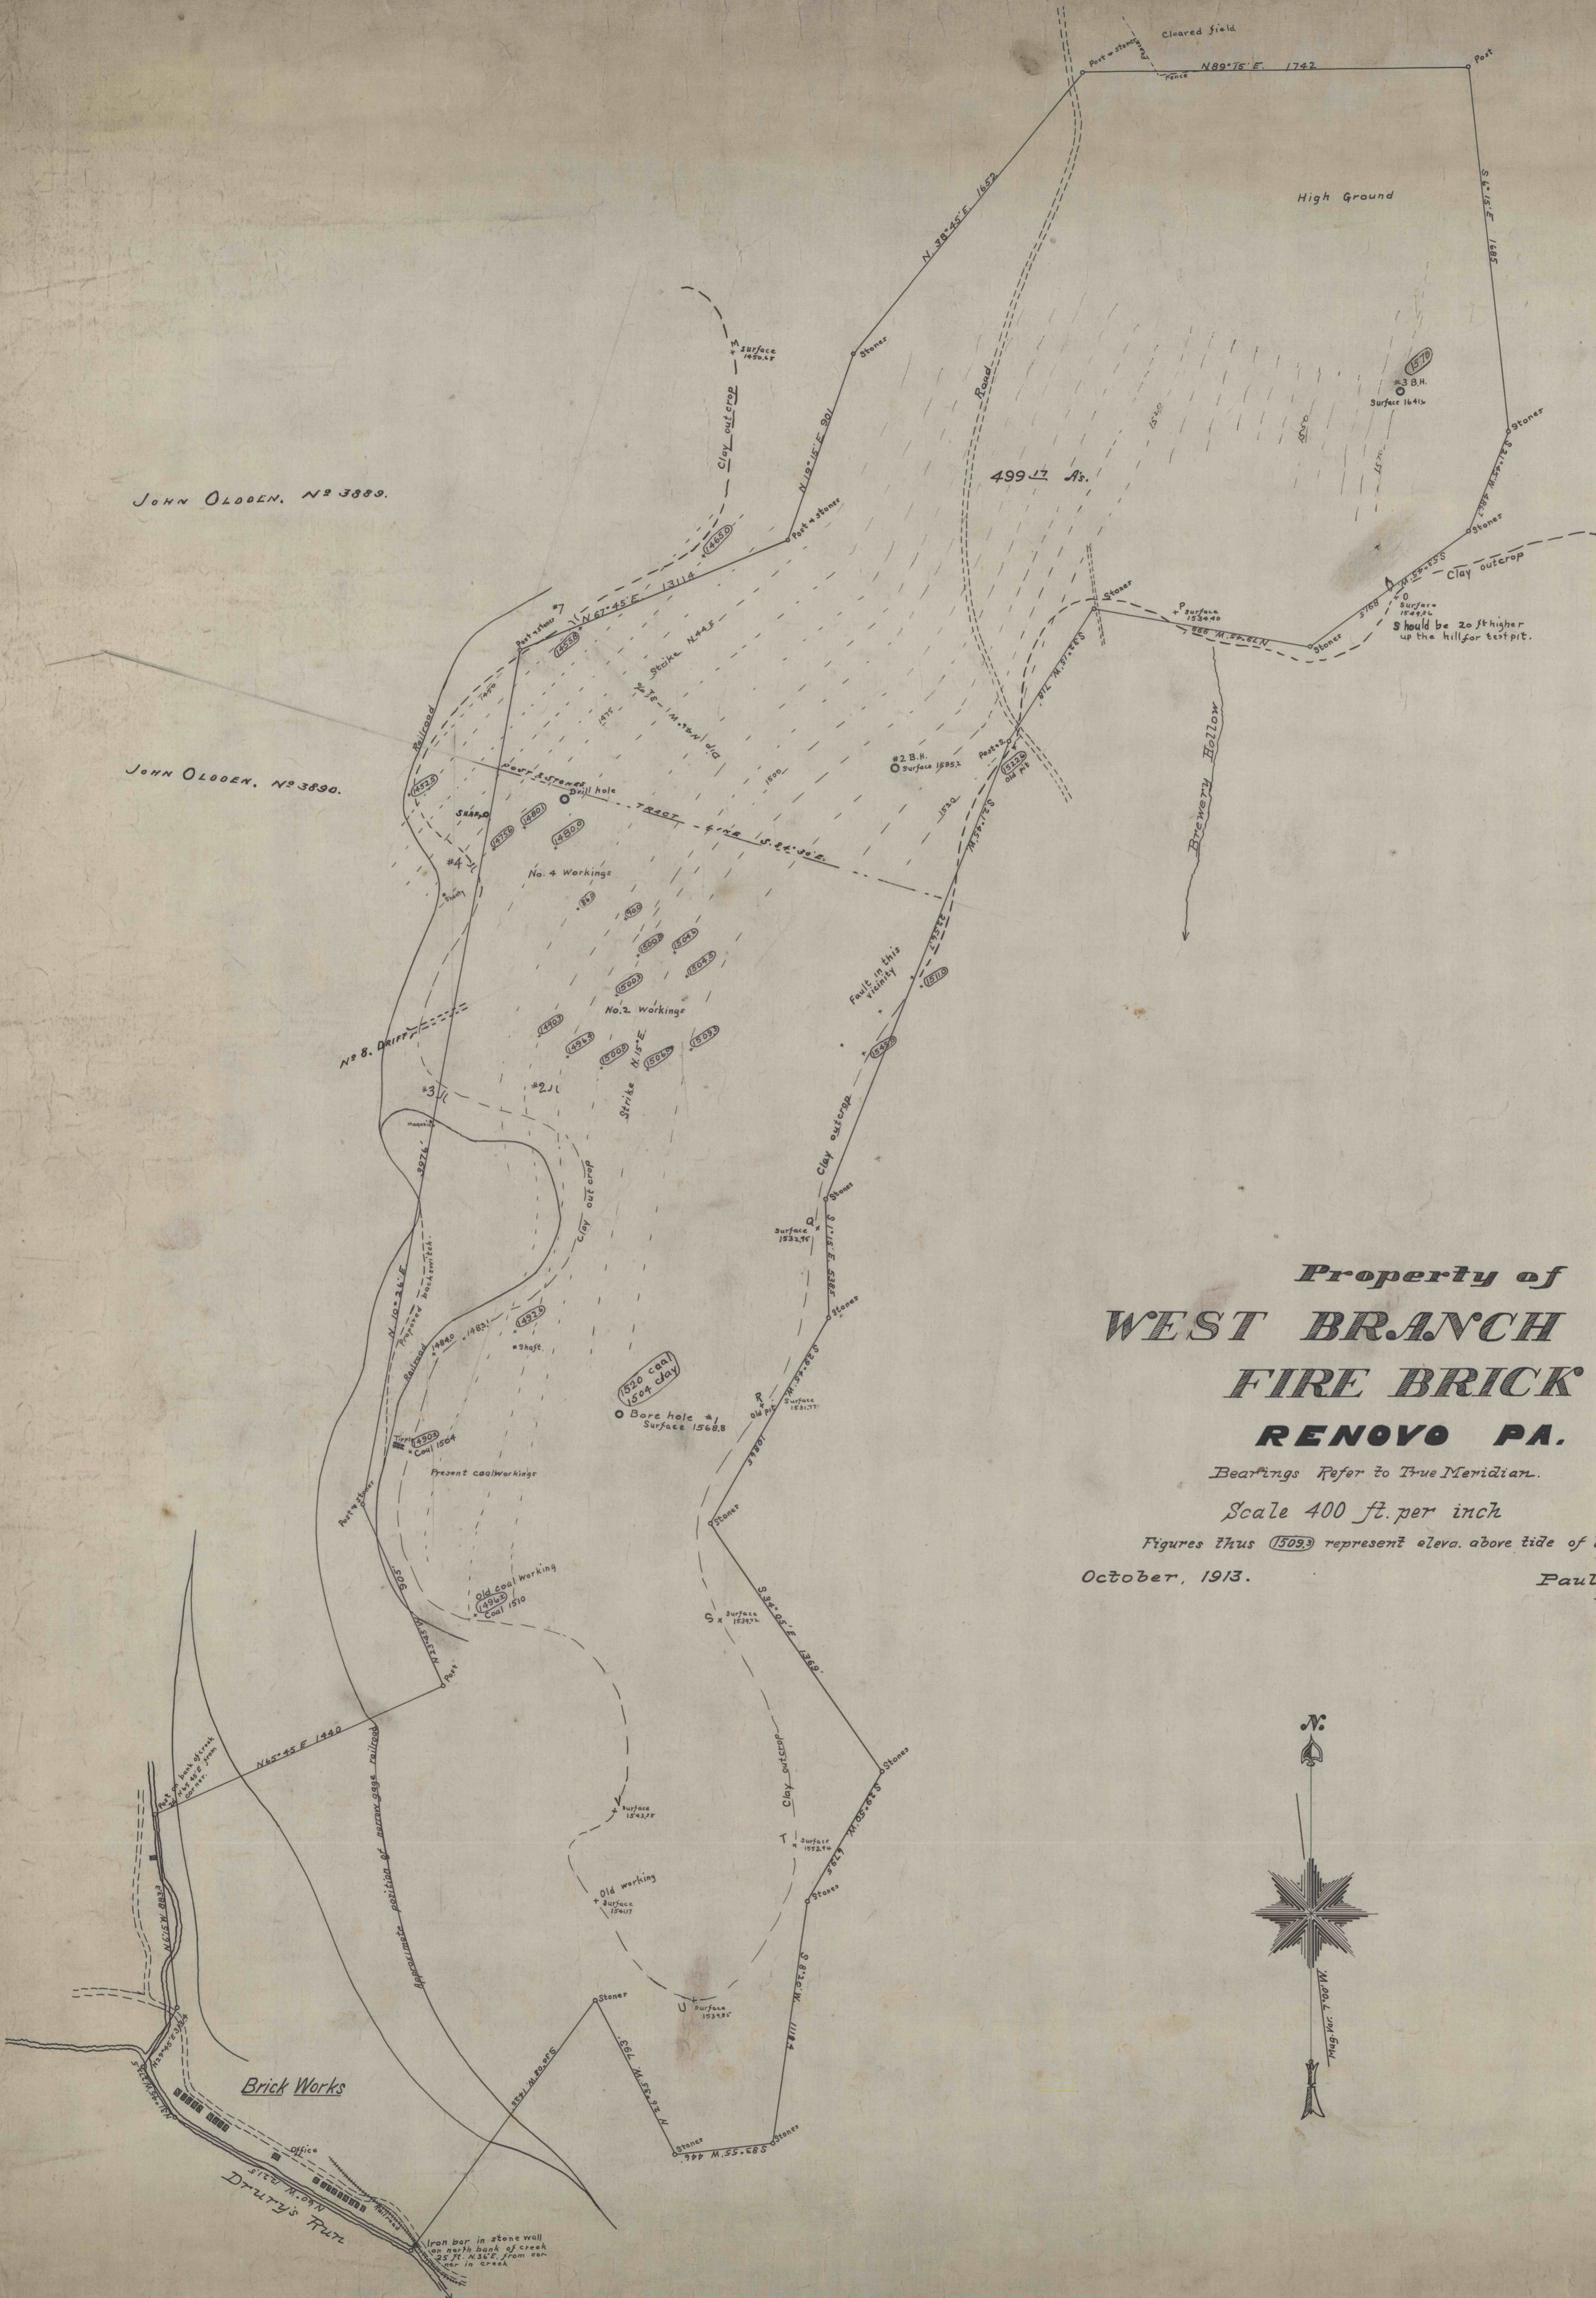

**Property of  
WEST BRANCH  
FIRE BRICK Co.  
RENOVO PA.**

Bearings Refer to True Meridian.

Scale 400 ft. per inch

Figures thus (1509) represent eleva. above tide of bottom of clay  
October, 1913.

Paul P. Lyon  
Bradford Pa.

