
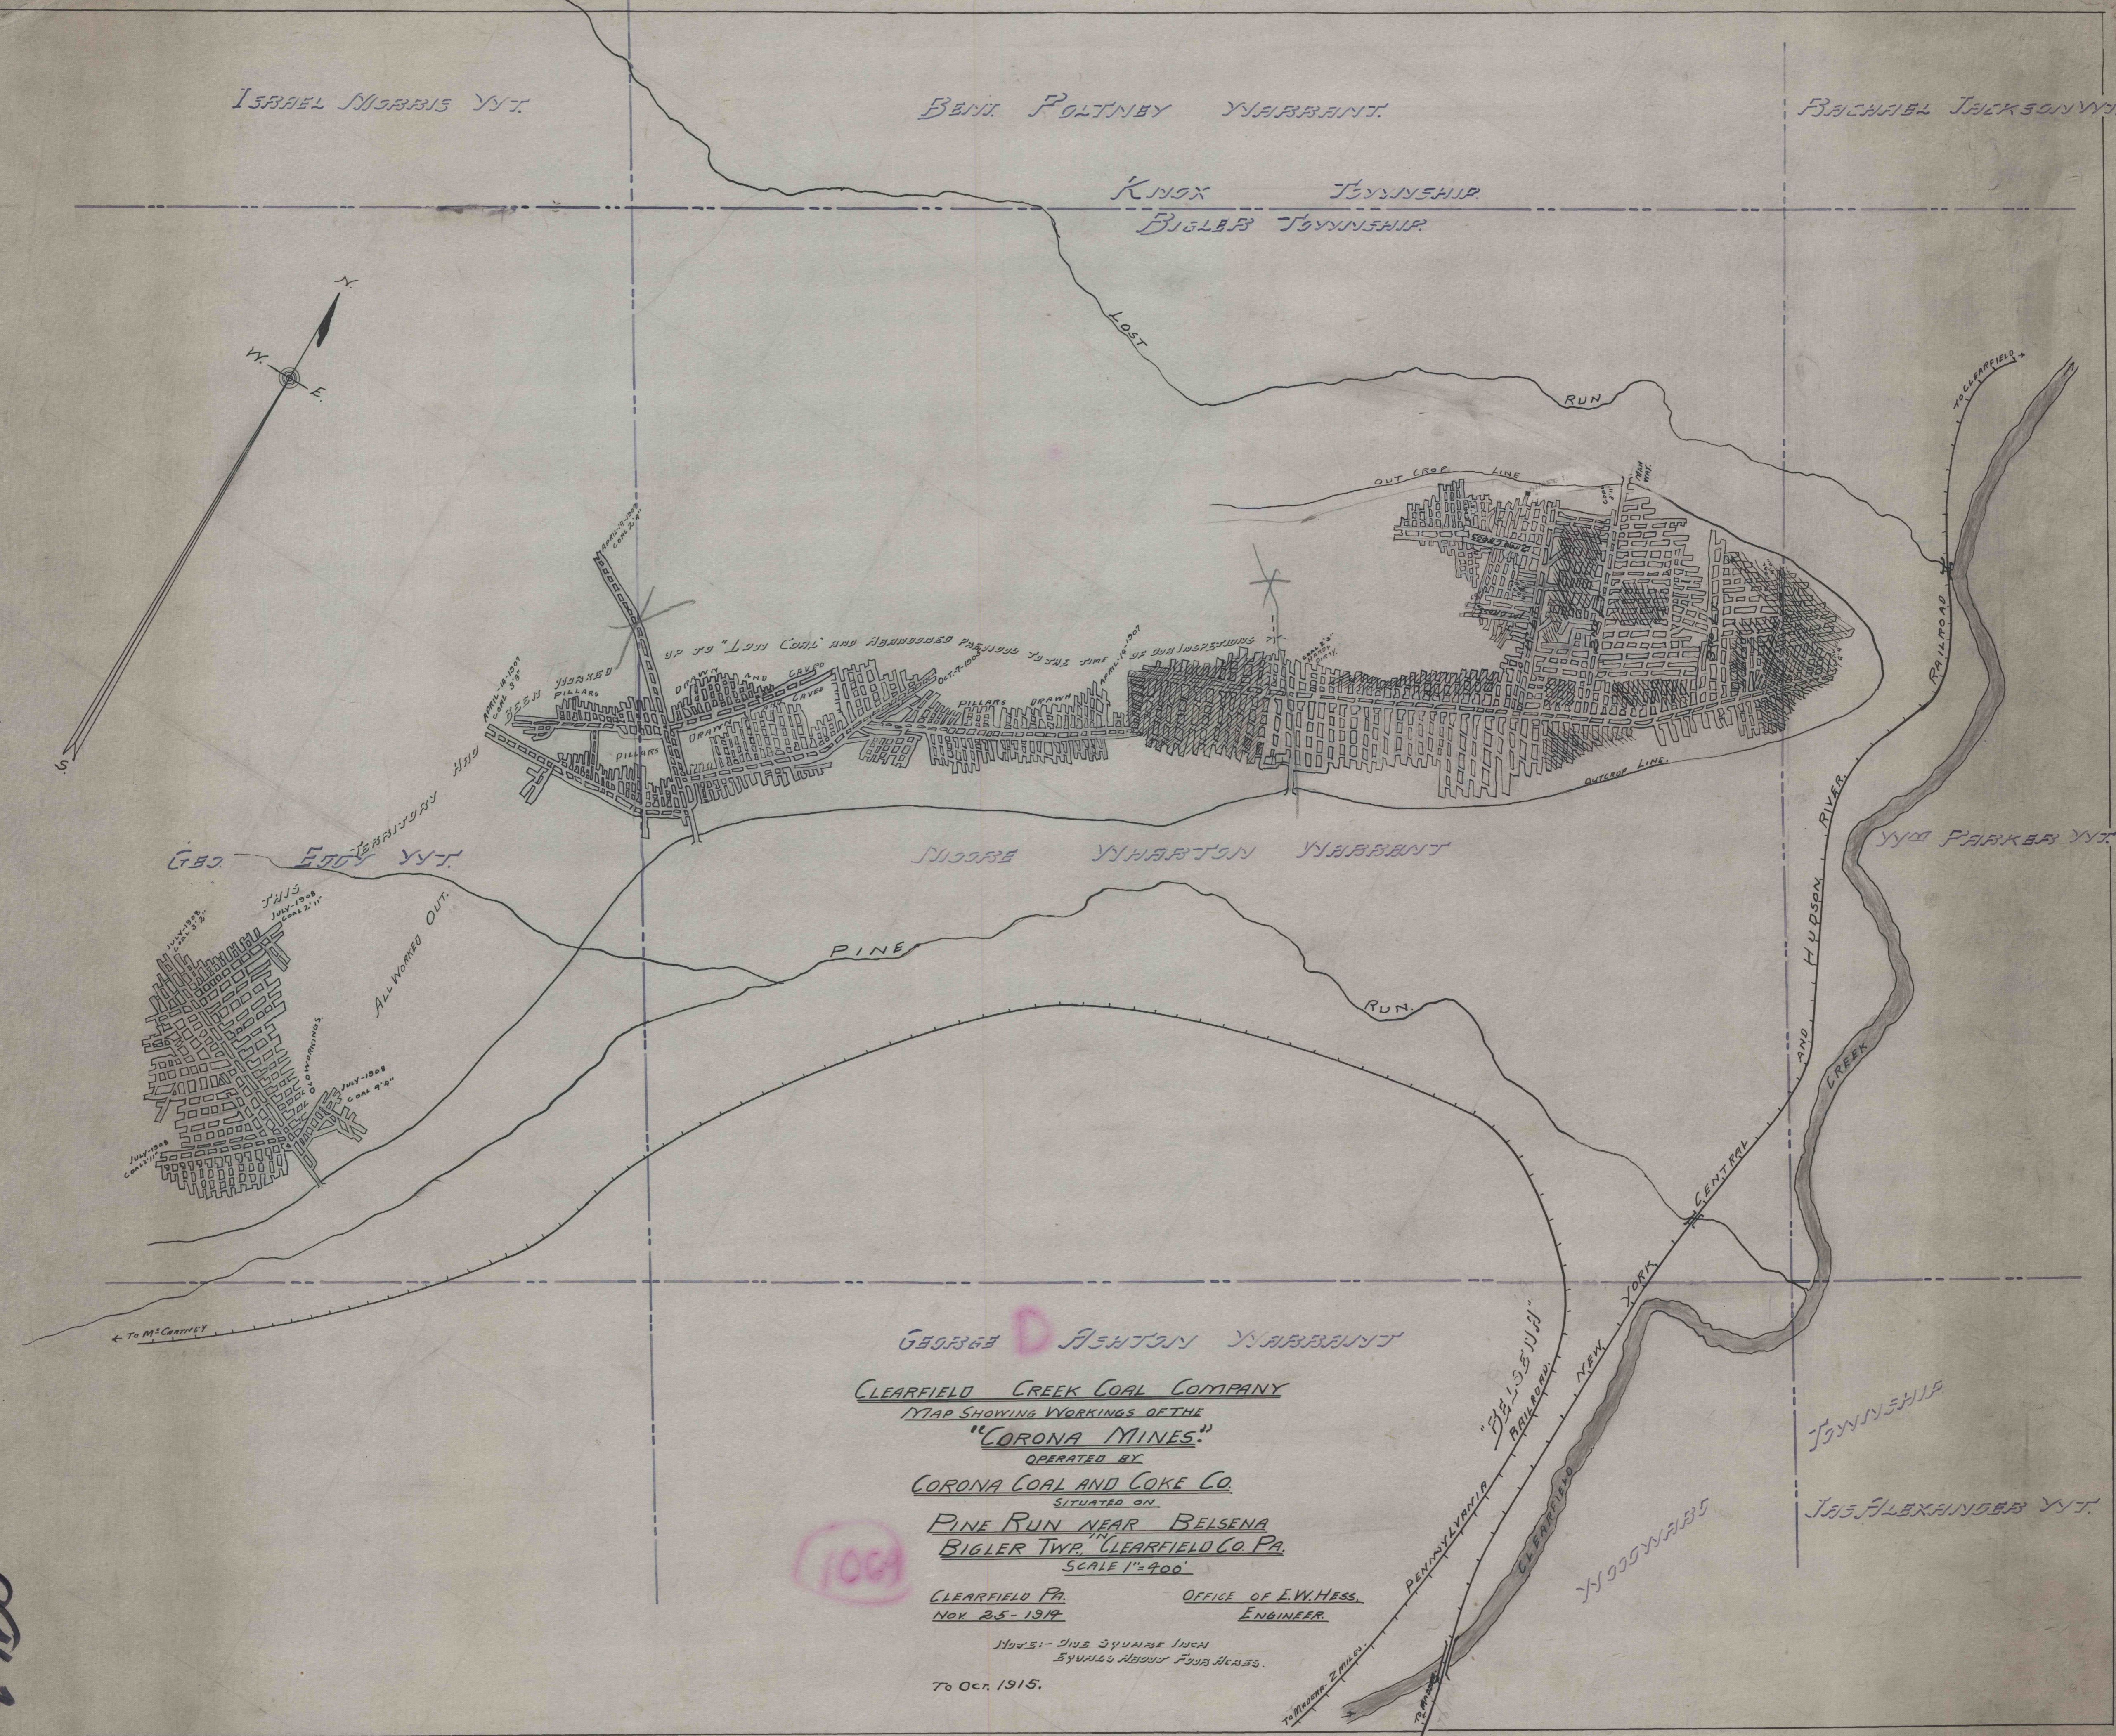


ISRAEL MORRIS YVT

BENT FOLTNBY YVARRANT.

RICHARD JACKSON YVT.

KINCK TOWNSHIP  
BIGLER TOWNSHIP

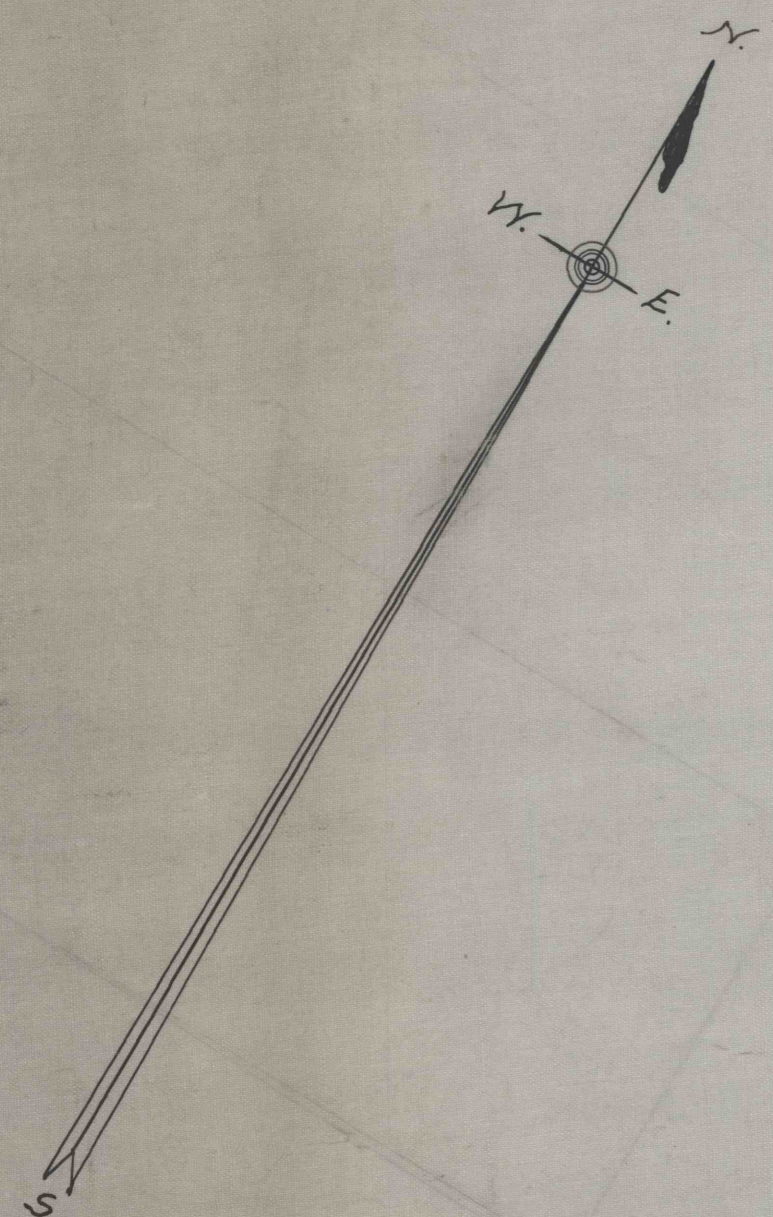

ALLOWED OUT.  
JULY 1908  
COAL 2' 11"  
JULY 1908  
COAL 4' 9"  
JULY 1908  
COAL 11'

GEORGE D. HEATON YVARRANT  
CLEARFIELD CREEK COAL COMPANY  
MAP SHOWING WORKINGS OF THE  
"CORONA MINES."  
OPERATED BY  
CORONA COAL AND COKE CO.  
SITUATED ON  
PINE RUN NEAR BELSENA  
BIGLER TWP., CLEARFIELD CO. PA.  
SCALE 1"=400'  
CLEARFIELD PA. OFFICE OF E. W. HESS.  
NOV. 25 - 1914. ENGINEER.

1069

NOT TO BE USED FOR ANY OTHER PURPOSES.  
TO OCT. 1915.

1069

2962

1069