


3360

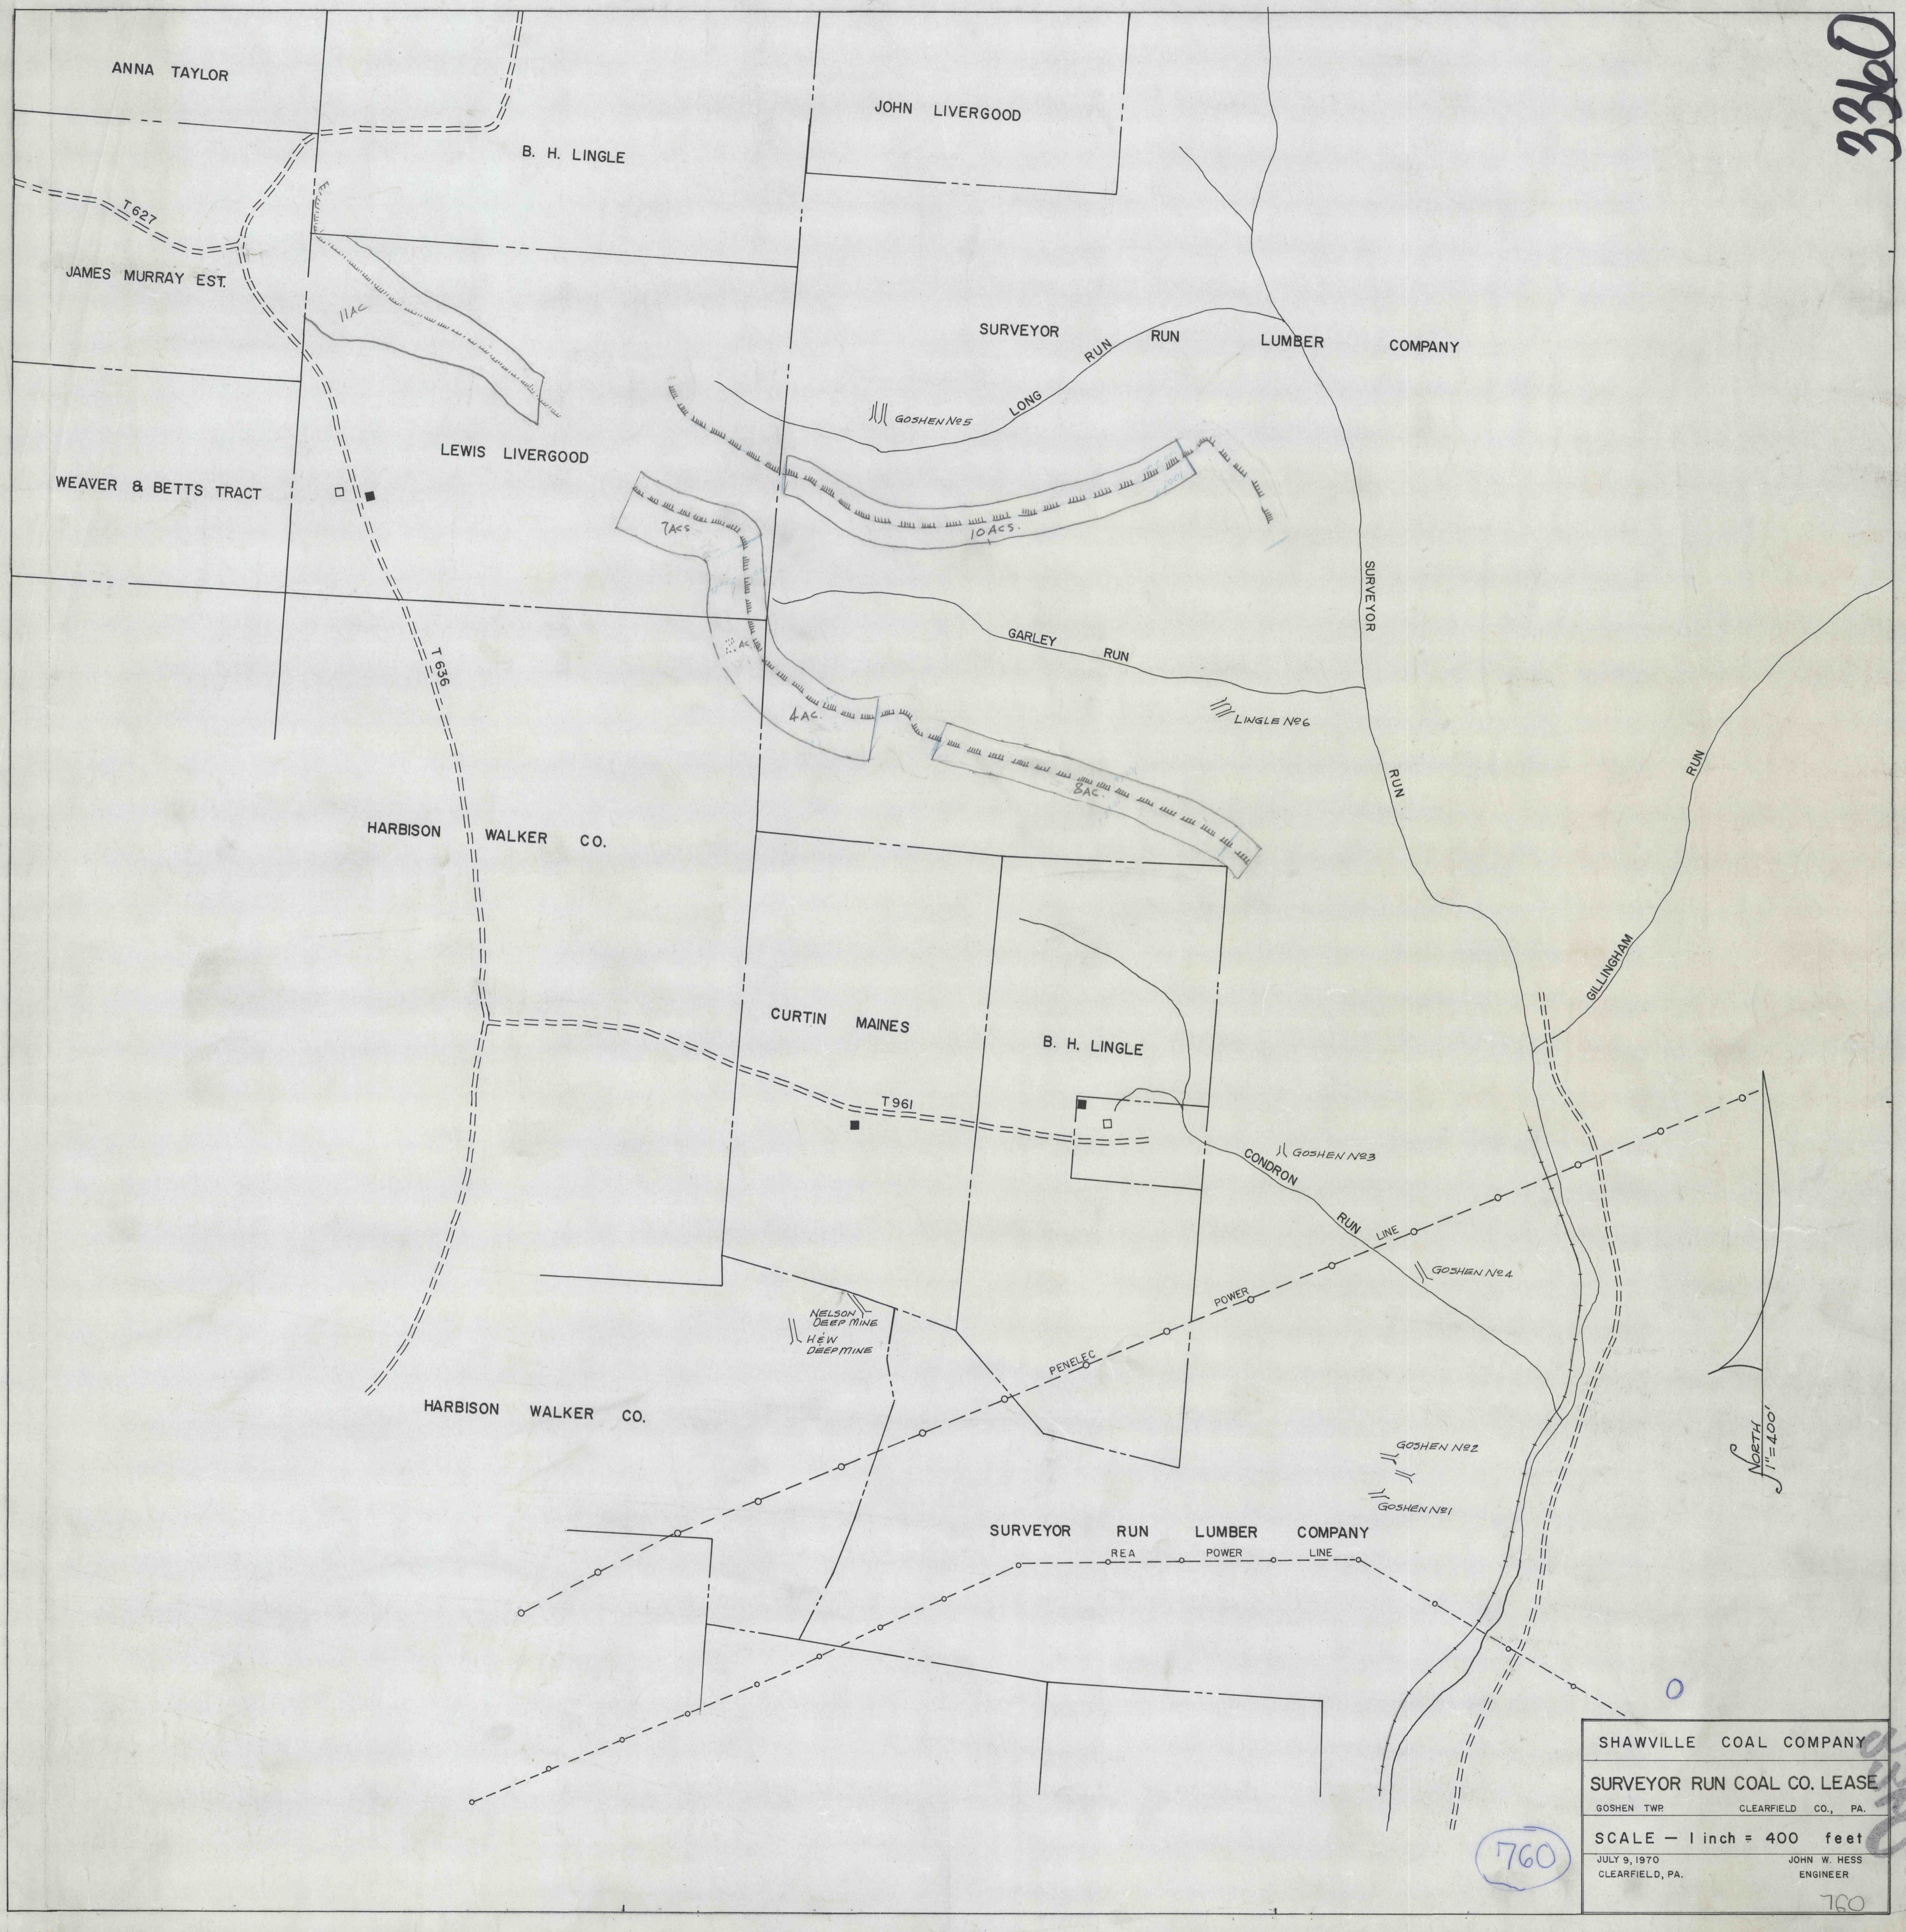

SHAWVILLE COAL COMPANY
 SURVEYOR RUN COAL CO. LEASE
 GOSHEN TWP CLEARFIELD CO., PA.
 SCALE - 1 inch = 400 feet
 JULY 9, 1970 JOHN W. HESS
 CLEARFIELD, PA. ENGINEER

760

760