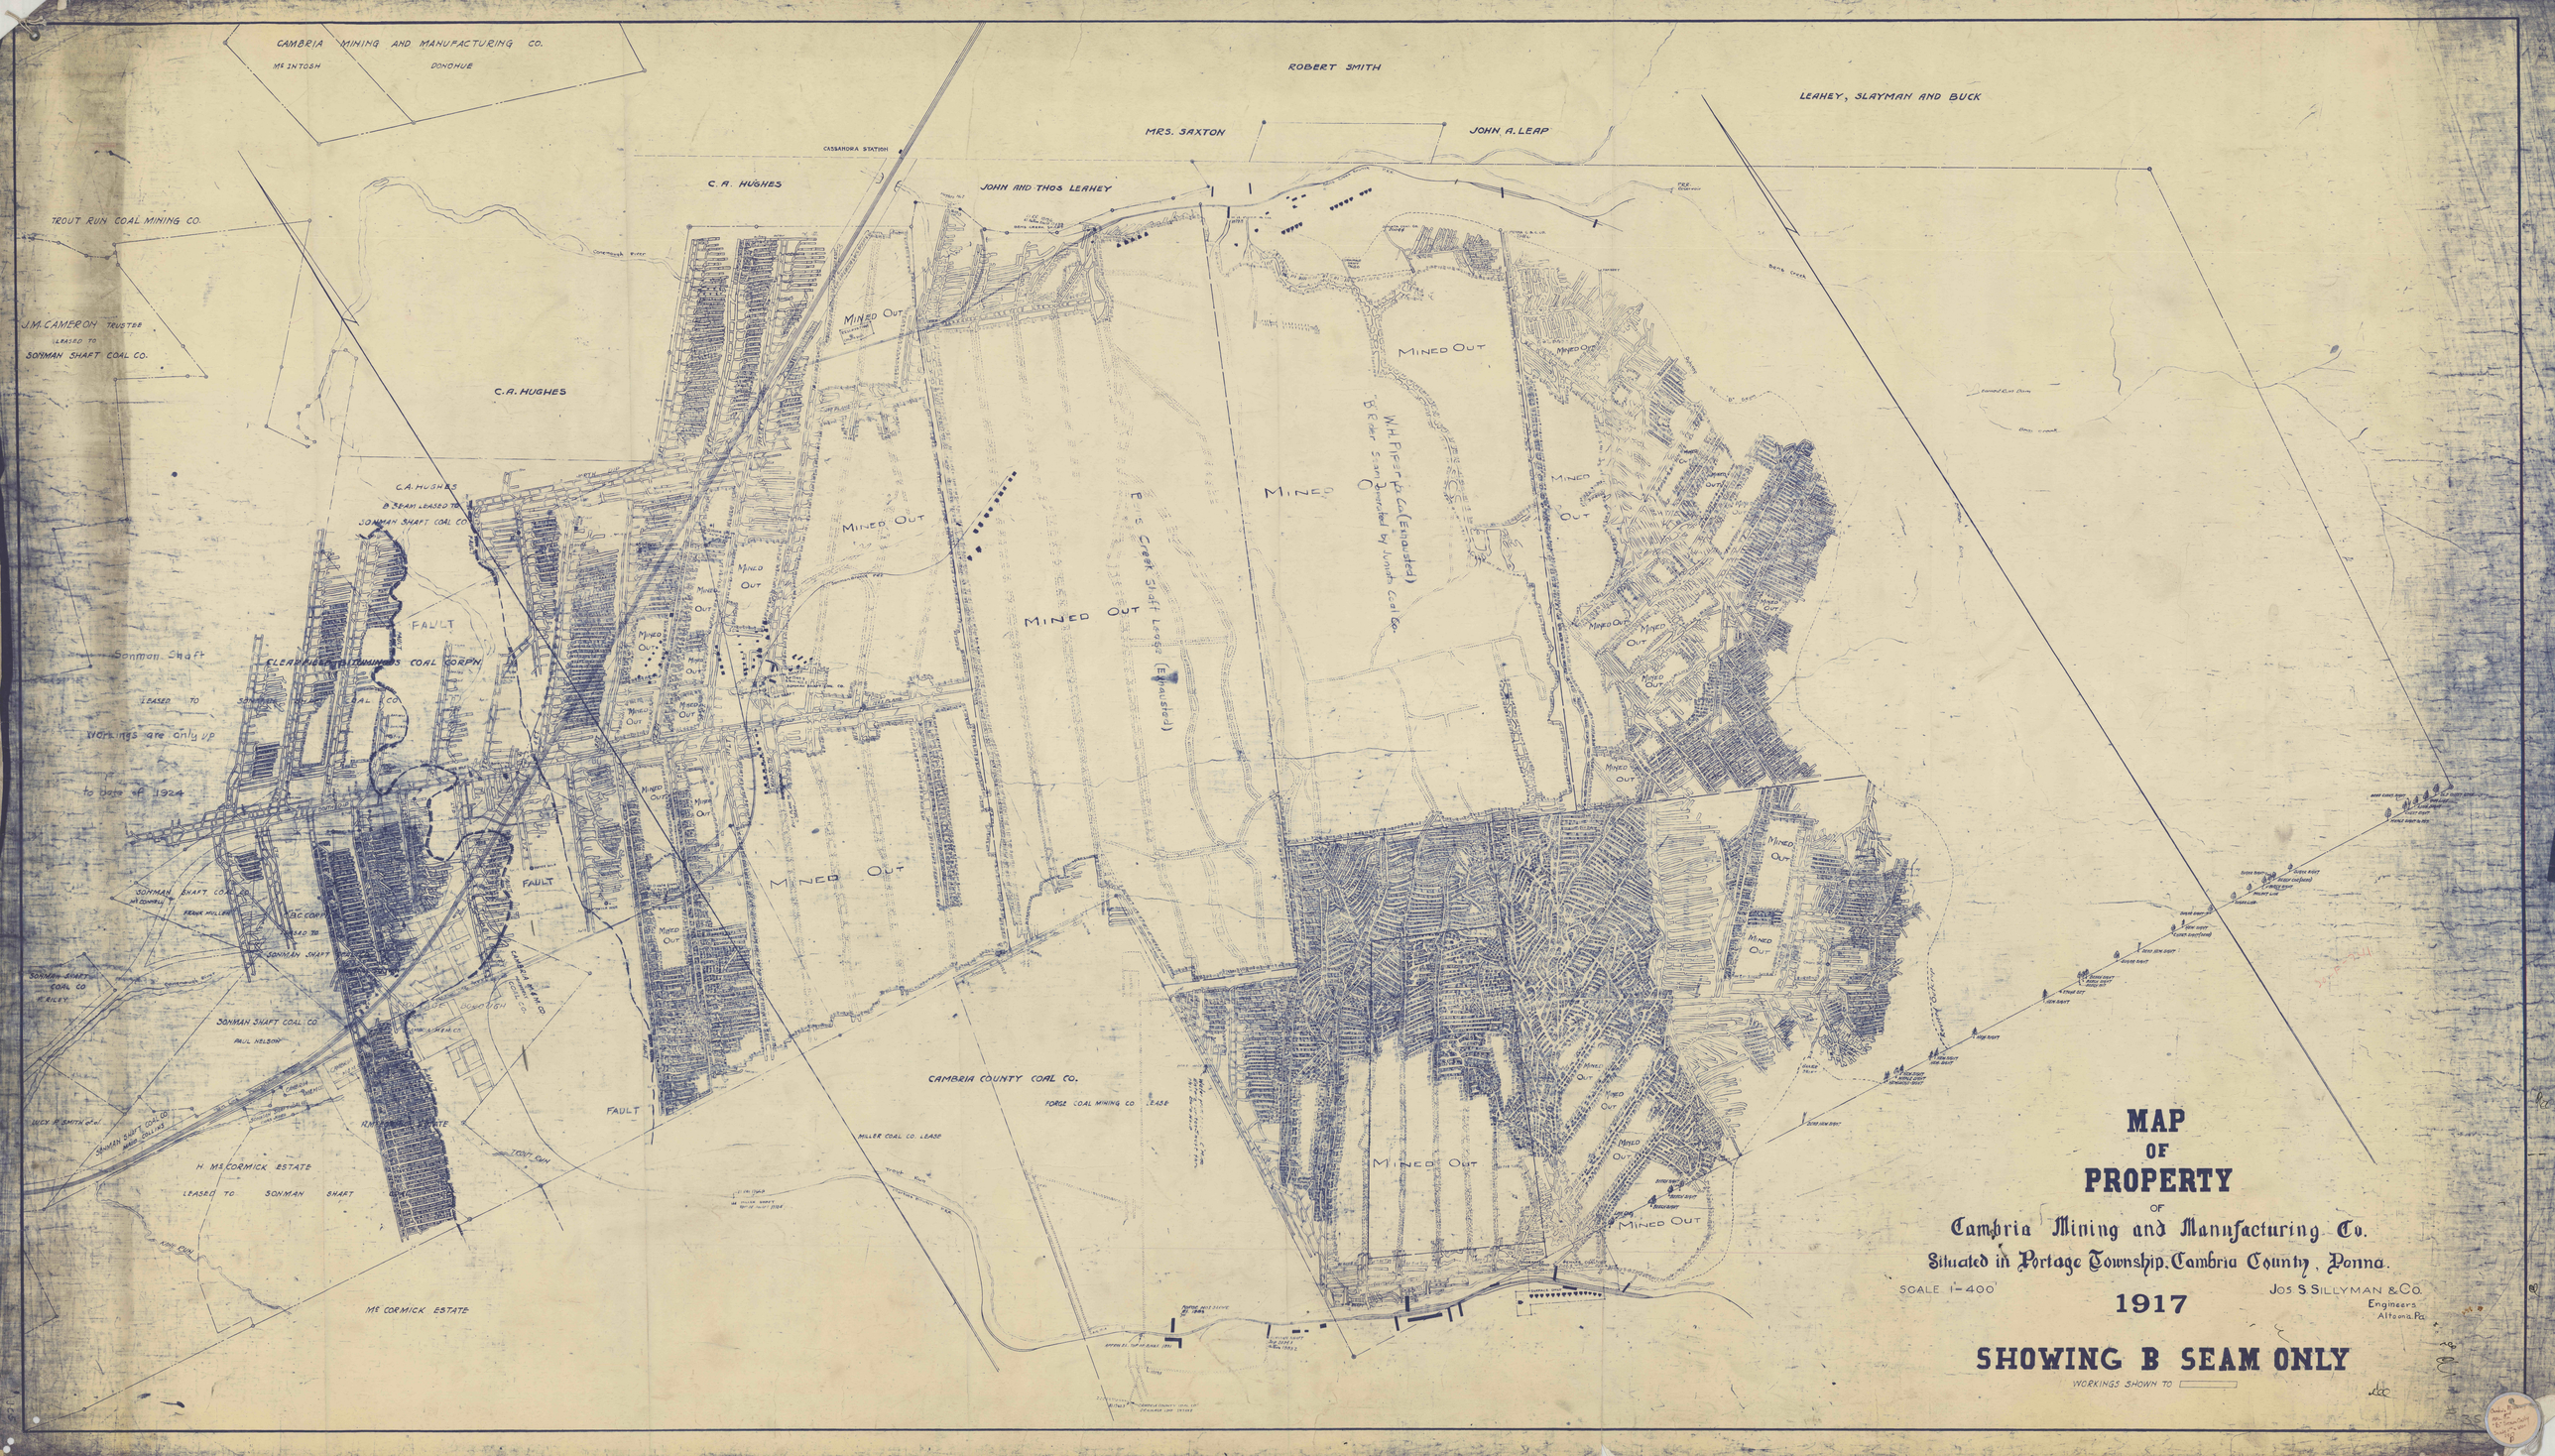
CAMBRIA MINING AND MANUFACTURING CO.
McINTOSH
DONOHUE
ROBERT SMITH
LEAHEY, SLAYMAN AND BUCK
MRS. SAXTON
JOHN A. LEAP
CASSANDRA STATION
C. A. HUGHES
JOHN AND THOS LEAHEY
TROUT RUN COAL MINING CO.
J.M. CAMERON TRUSTEE
LEASED TO
SONMAN SHAFT COAL CO.
C.A. HUGHES
C.A. HUGHES
B SEAM LEASED TO
SONMAN SHAFT COAL CO
FAULT
Sonman Shaft
LEASED TO
Workings are only up
to date of 1924
MINED OUT
MINED OUT
MINED OUT
MINED OUT
MINED OUT
MINED OUT
MINED OUT
MINED OUT
MINED OUT
MINED OUT
MINED OUT
MINED OUT
MINED OUT
MINED OUT
Bens Creek Shaft Lease (Exhausted)
W.H. Fiery Co. (Exhausted)
"B" Seam Leased by Lynch Coal Co.
FAULT
FAULT
FAULT
SONMAN SHAFT COAL CO
SONMAN SHAFT COAL CO
PAUL NELSON
LUCY R. SMITH et al
SONMAN SHAFT COAL CO
H McCORMICK ESTATE
LEASED TO SONMAN SHAFT
McCORMICK ESTATE
CAMBRIA COUNTY COAL CO.
FORGE COAL MINING CO LEASE
MILLER COAL CO. LEASE
MINED OUT
MINED OUT
MINED OUT
MINED OUT
MINED OUT
MINED OUT
MINED OUT
MINED OUT
MINED OUT
MINED OUT
MINED OUT
MINED OUT
MINED OUT
MINED OUT