

NO. 22 AIR-SHAFT

DP
CLEARFIELD CREEK COAL CO.
MAP SHOWING WORKINGS OF
STANDARD - 7 - MINE
NEAR
CHESTERFIELD

SCALE 1" = 400'

CLEARFIELD PA.

OFFICE E. W. HESS

JUNE - 10 - 1914

188

ENGINEER

DICKESON TRACT.

BEYERS


JOHN

CREEK

CLEARFIELD

SIDING

BANIAN RIVER BR.

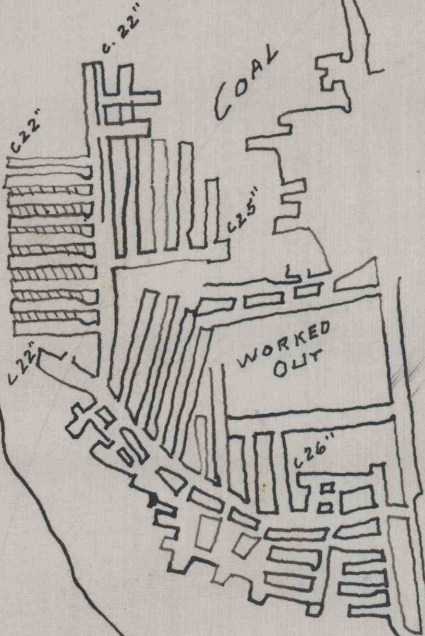

CO.

OLD WORKINGS

OLD

OLD DRIFT.

MECHLING TRACT

HIRSH TRACT

IRON PIN

POST.

361

105