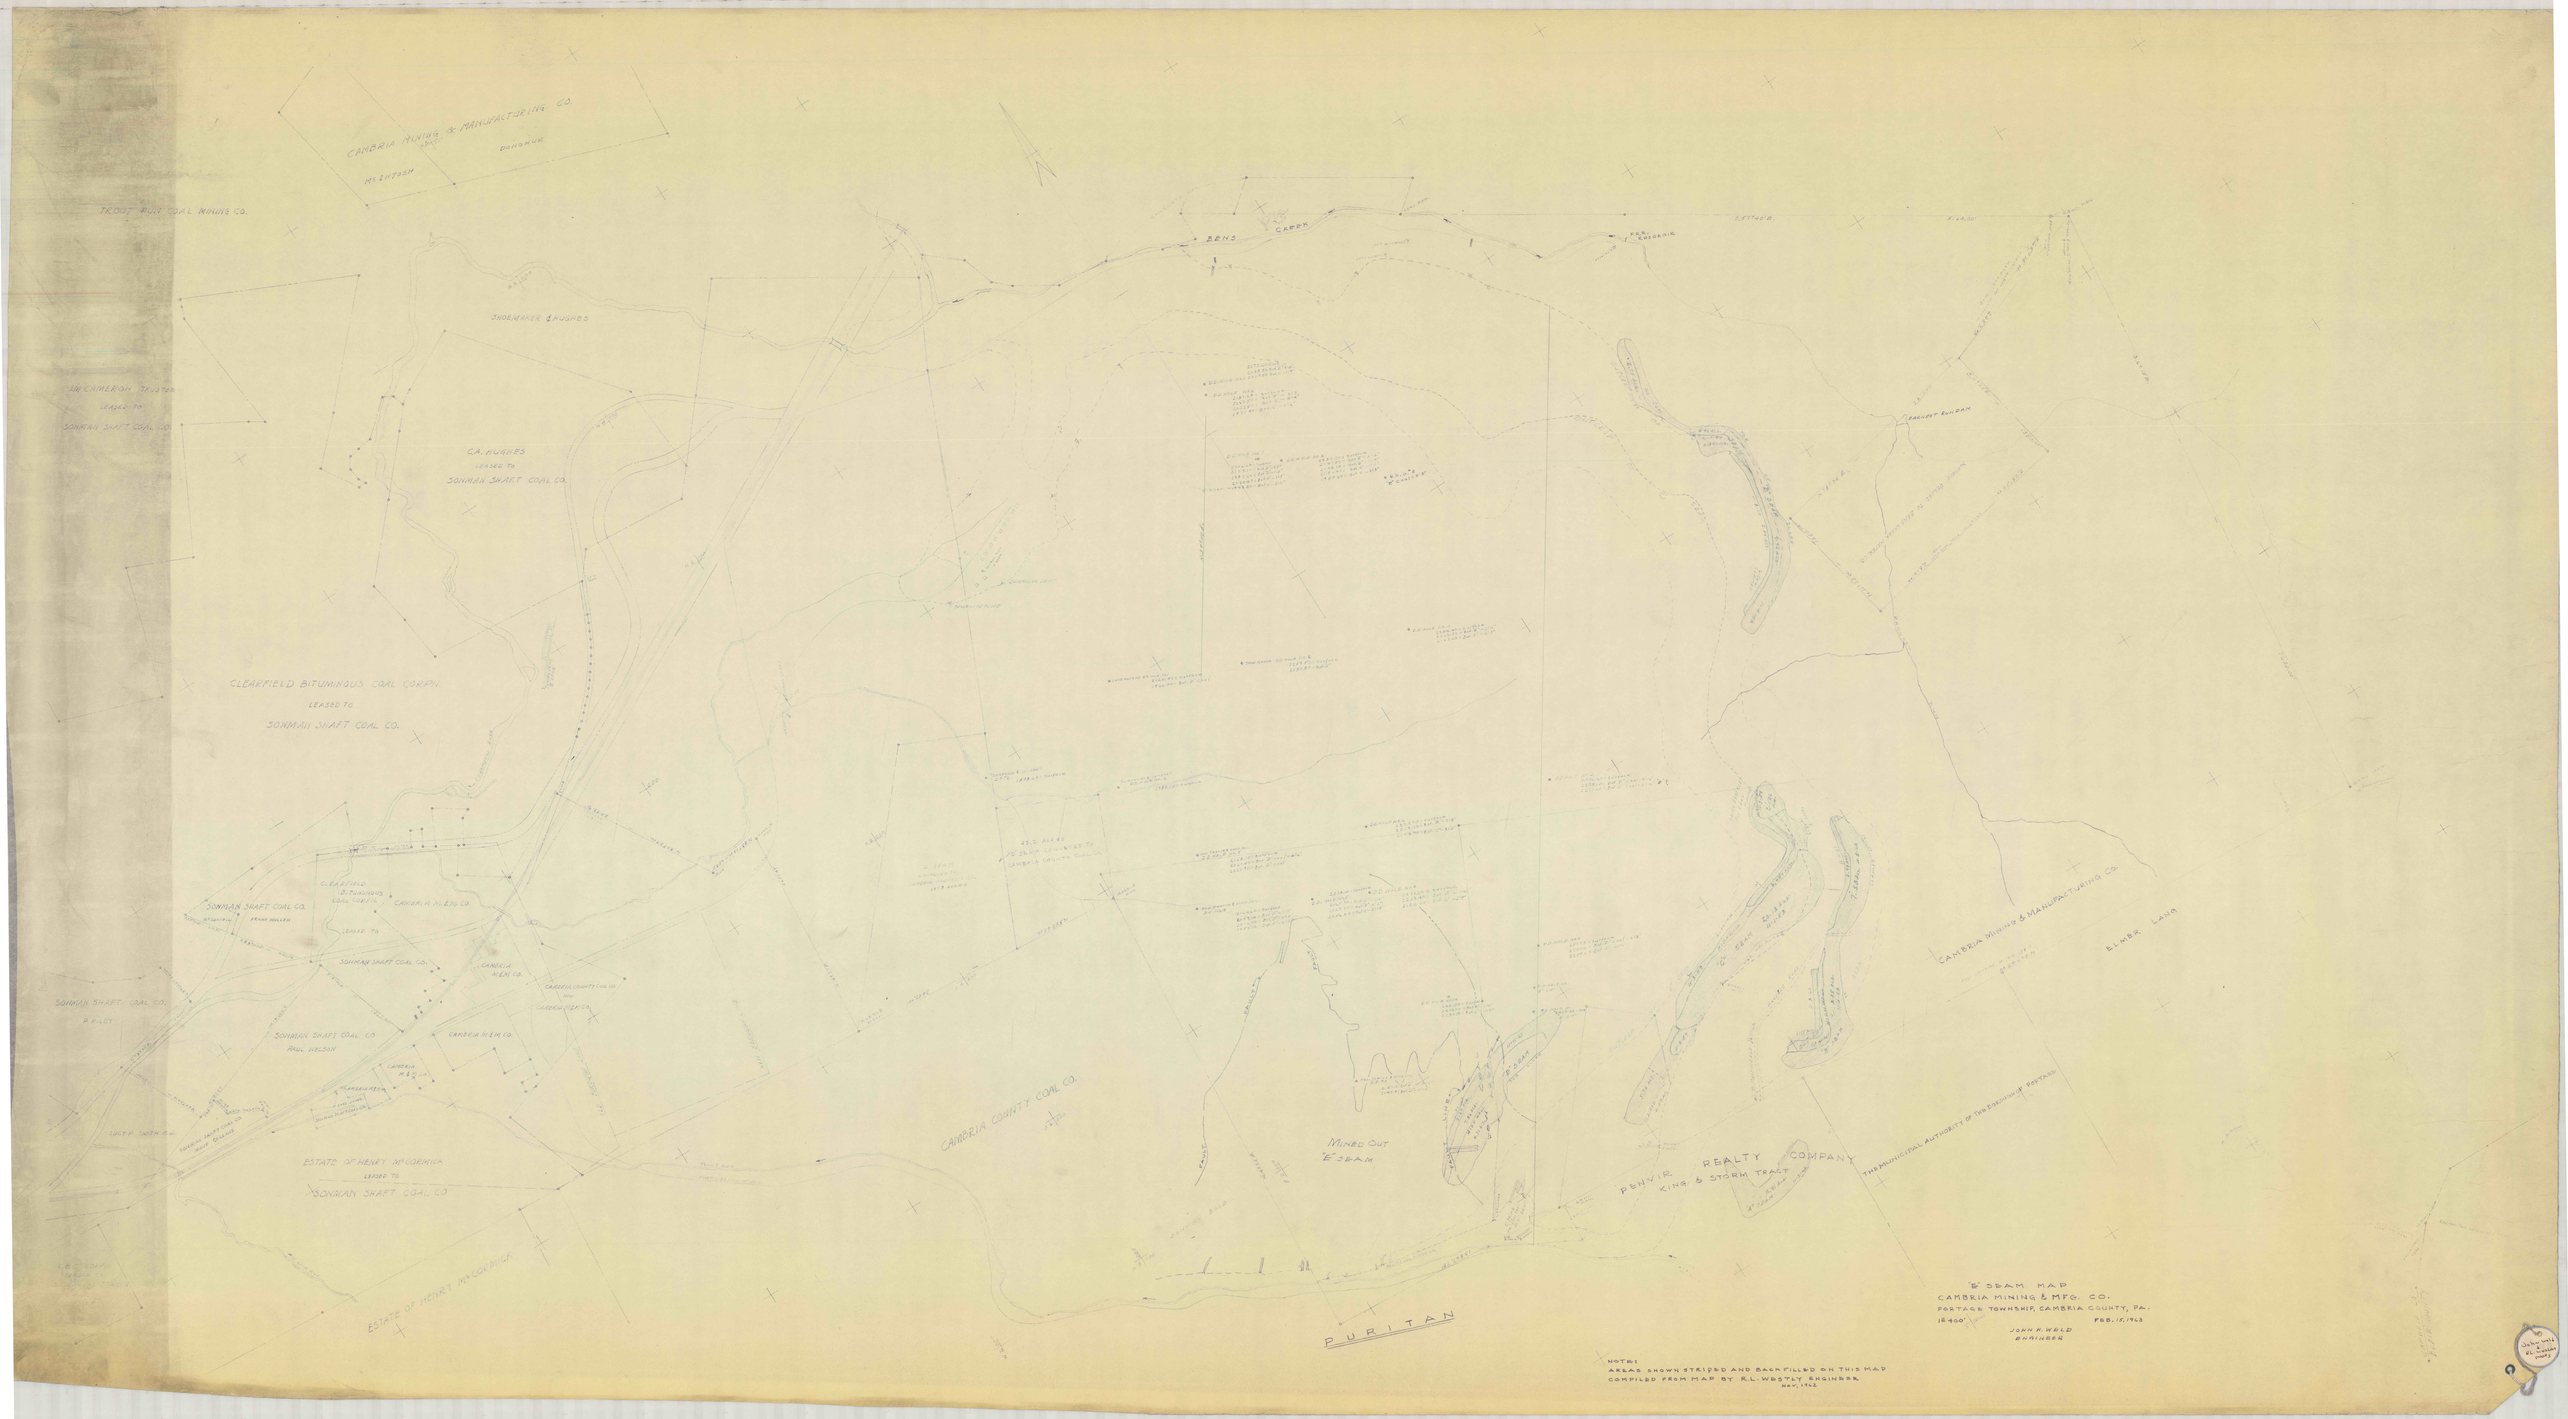
CAMBRIA MINING & MANUFACTURING CO.
McINTOSH
DONOHUE
TROUT RUN COAL MINING CO.
SHOEMAKER & HUGHES
J.M. CAMERON, TRUSTEE
LEASED TO
SONMAN SHAFT COAL CO.
C.A. HUGHES
LEASED TO
SONMAN SHAFT COAL CO.
CLEARFIELD BITUMINOUS COAL CORPN.
LEASED TO
SONMAN SHAFT COAL CO.
SONMAN SHAFT COAL CO.
FRANK WALLER
CLEARFIELD BITUMINOUS COAL CORP'N
CAMBRIA M. & M. CO.
LEASED TO
SONMAN SHAFT COAL CO.
CAMBRIA M. & M. CO.
CAMBRIA COUNTY COAL CO.
CAMBRIA COAL CO.
SONMAN SHAFT COAL CO.
PAUL WELSON
CAMBRIA M. & M. CO.
SONMAN SHAFT COAL CO.
R. RILEY
LUCY P. SMITH ET AL
ESTATE OF HENRY McCORMICK
LEASED TO
SONMAN SHAFT COAL CO.
ESTATE OF HENRY McCORMICK
CAMBRIA COUNTY COAL CO.
MINED OUT
"E" SEAM
PURITAN
PENVIR REALTY COMPANY
KING & STORM TRACT
THE MUNICIPAL AUTHORITY OF THE BOROUGH OF PORTAGE
CAMBRIA MINING & MANUFACTURING CO.
ELMER LAND
"E" SEAM MAP
CAMBRIA MINING & MFG. CO.
PORTAGE TOWNSHIP, CAMBRIA COUNTY, PA.
1" = 400'
FEB. 16, 1943
JOHN R. WELD
ENGINEER
NOTE:
AREAS SHOWN STRIPED AND BACKFILLED ON THIS MAP
COMPILED FROM MAP BY R.L. WESTLY ENGINEER
MAY, 1942