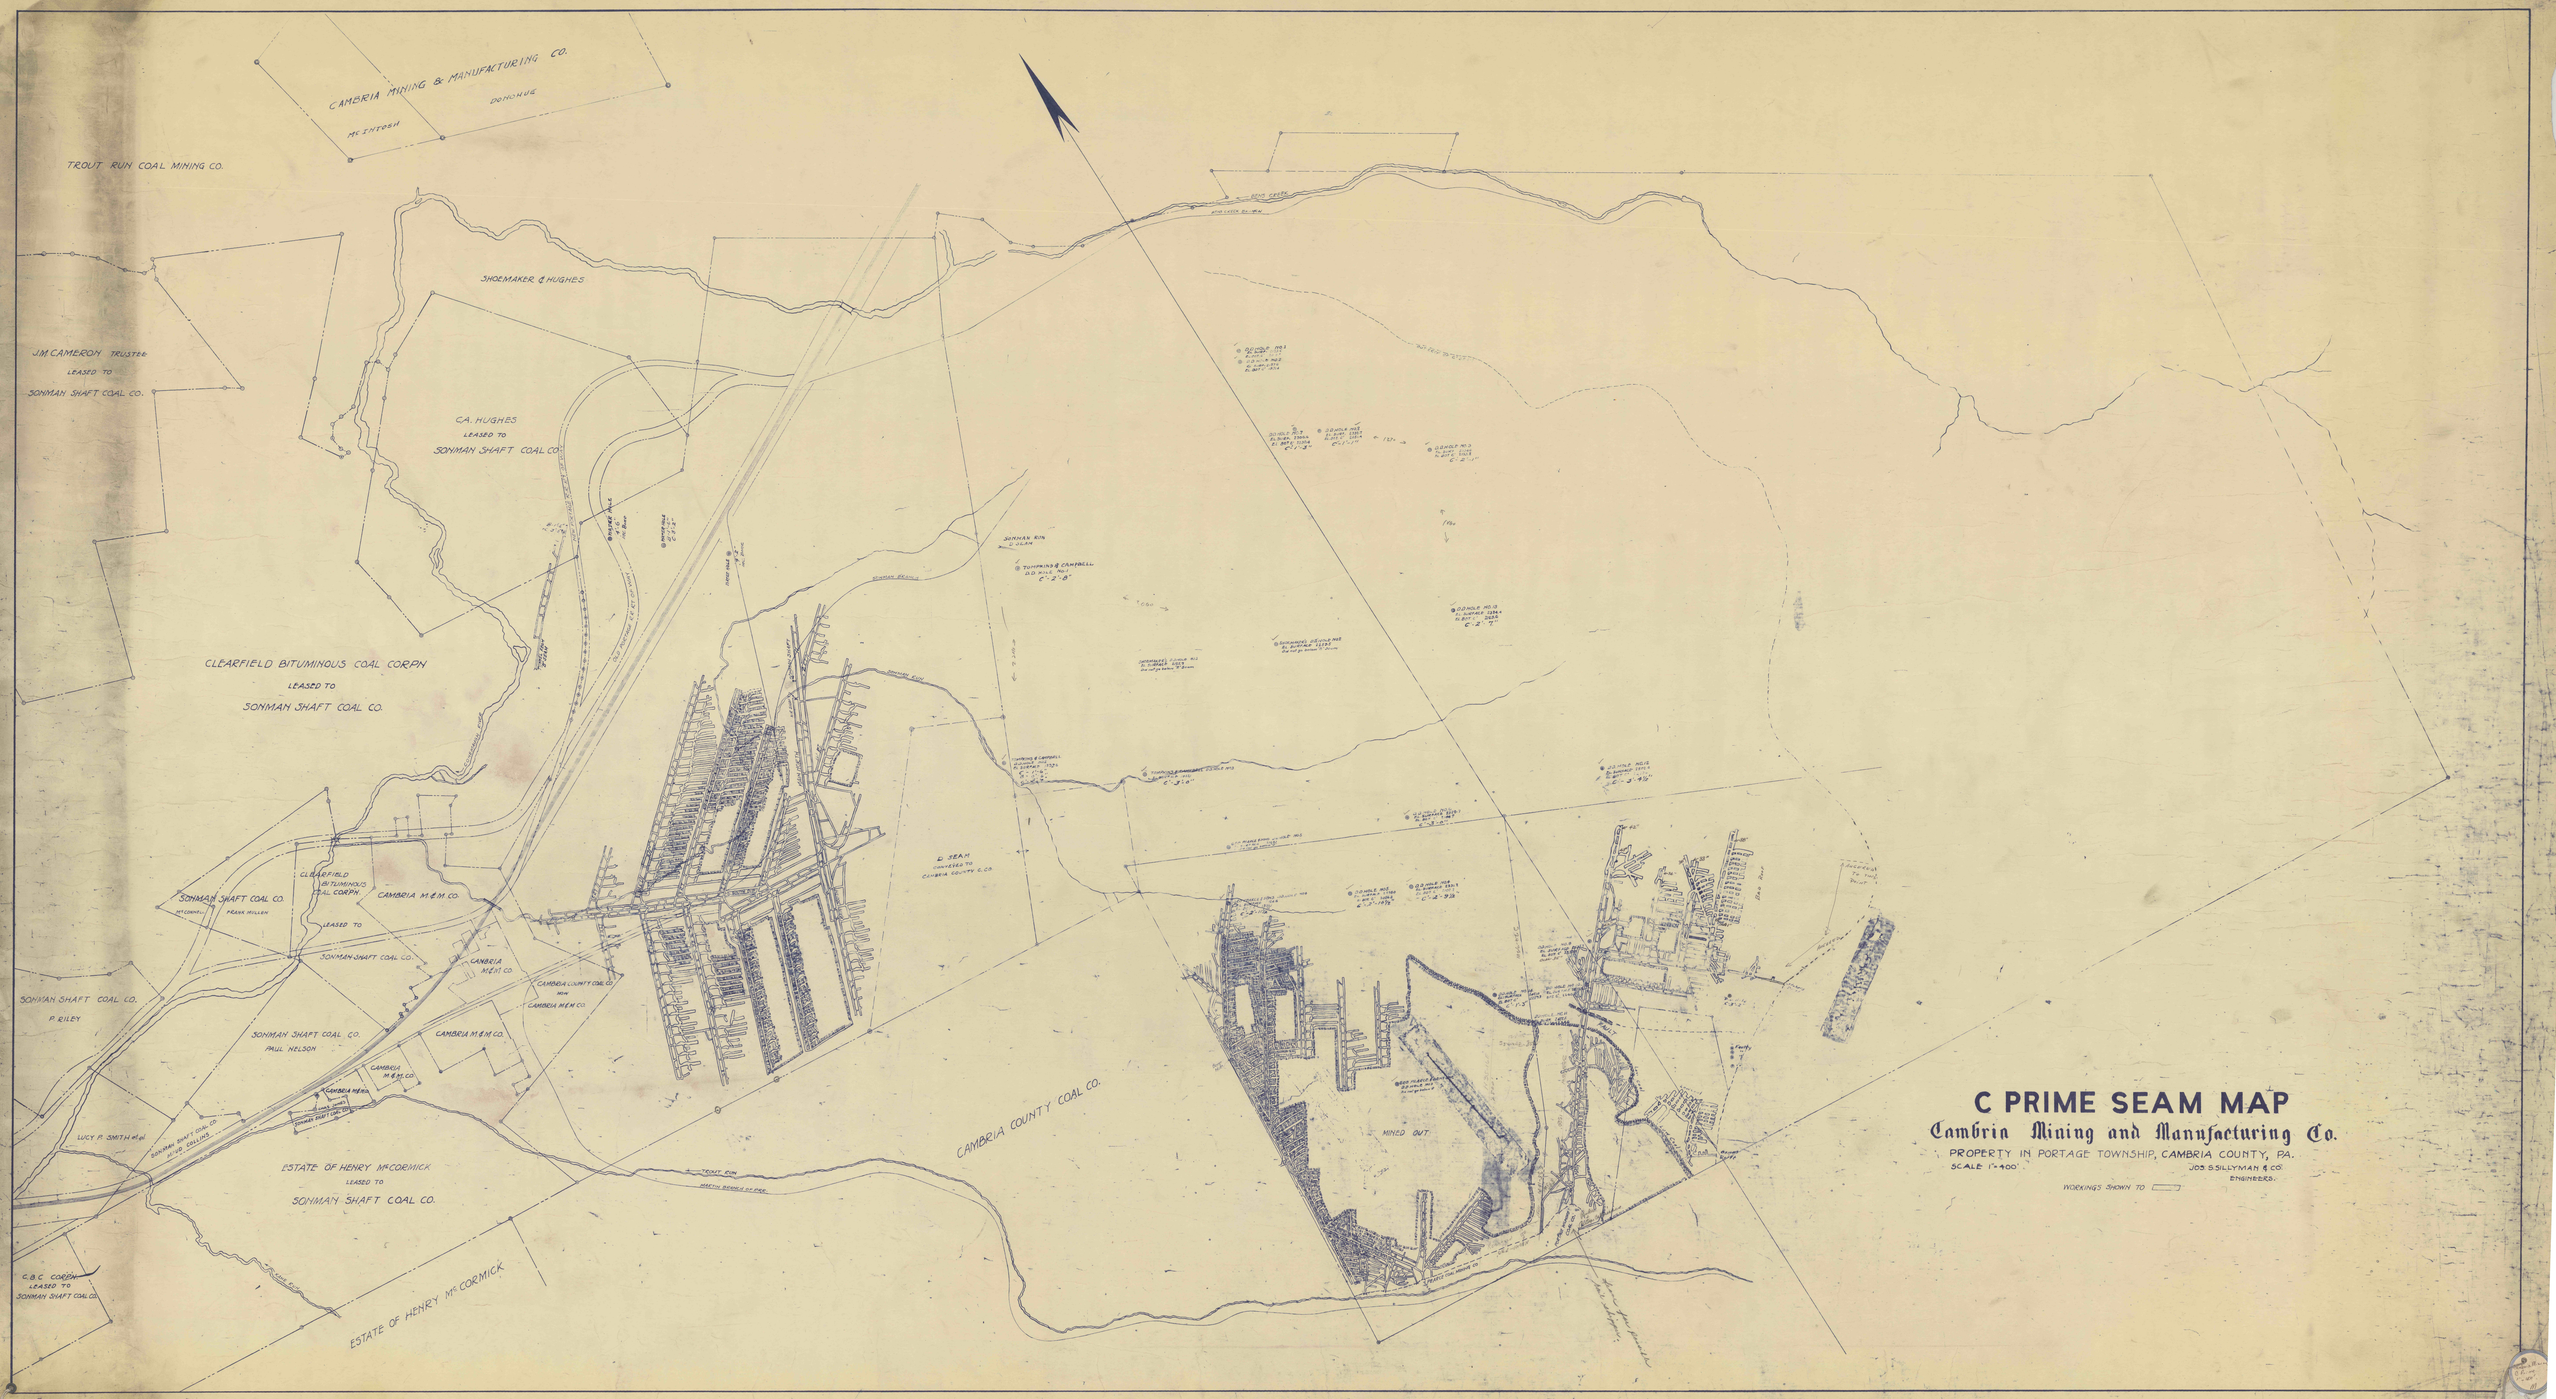
CAMBRIA MINING & MANUFACTURING CO.
McINTOSH
DEHONUE
TROUT RUN COAL MINING CO.
SHOEMAKER & HUGHES
J.M. CAMERON TRUSTEE
LEASED TO
SONMAN SHAFT COAL CO.
C.A. HUGHES
LEASED TO
SONMAN SHAFT COAL CO.
CLEARFIELD BITUMINOUS COAL CORP'N
LEASED TO
SONMAN SHAFT COAL CO.
SONMAN RUN
TOMPKINS & CAMPBELL
D.D. HOLE NO.1
E. SEAM
CONVERTED TO
CAMBRIA COUNTY C.CO.
SONMAN SHAFT COAL CO.
CLEARFIELD BITUMINOUS COAL CORP'N
CAMBRIA M.&M. CO.
LEASED TO
SONMAN SHAFT COAL CO.
CAMBRIA M.&M. CO.
CAMBRIA COUNTY COAL CO.
NOW
CAMBRIA M.&M. CO.
SONMAN SHAFT COAL CO.
P. RILEY
SONMAN SHAFT COAL CO.
PAUL NELSON
CAMBRIA M.&M. CO.
CAMBRIA M.&M. CO.
CAMBRIA M.&M.
LUCY P. SMITH et al
SONMAN SHAFT COAL CO.
W.D. COLLINS
ESTATE OF HENRY McCORMICK
LEASED TO
SONMAN SHAFT COAL CO.
TROUT RUN
MARTIN BORNER SR. PRE.
CAMBRIA COUNTY COAL CO.
MINED OUT
ESTATE OF HENRY McCORMICK
C.B.C. CORP'N
LEASED TO
SONMAN SHAFT COAL CO.
C PRIME SEAM MAP
Cambria Mining and Manufacturing Co.
PROPERTY IN PORTAGE TOWNSHIP, CAMBRIA COUNTY, PA.
SCALE 1"=400'
JOS. S. SILLYMAN & CO.
ENGINEERS.
WORKINGS SHOWN TO