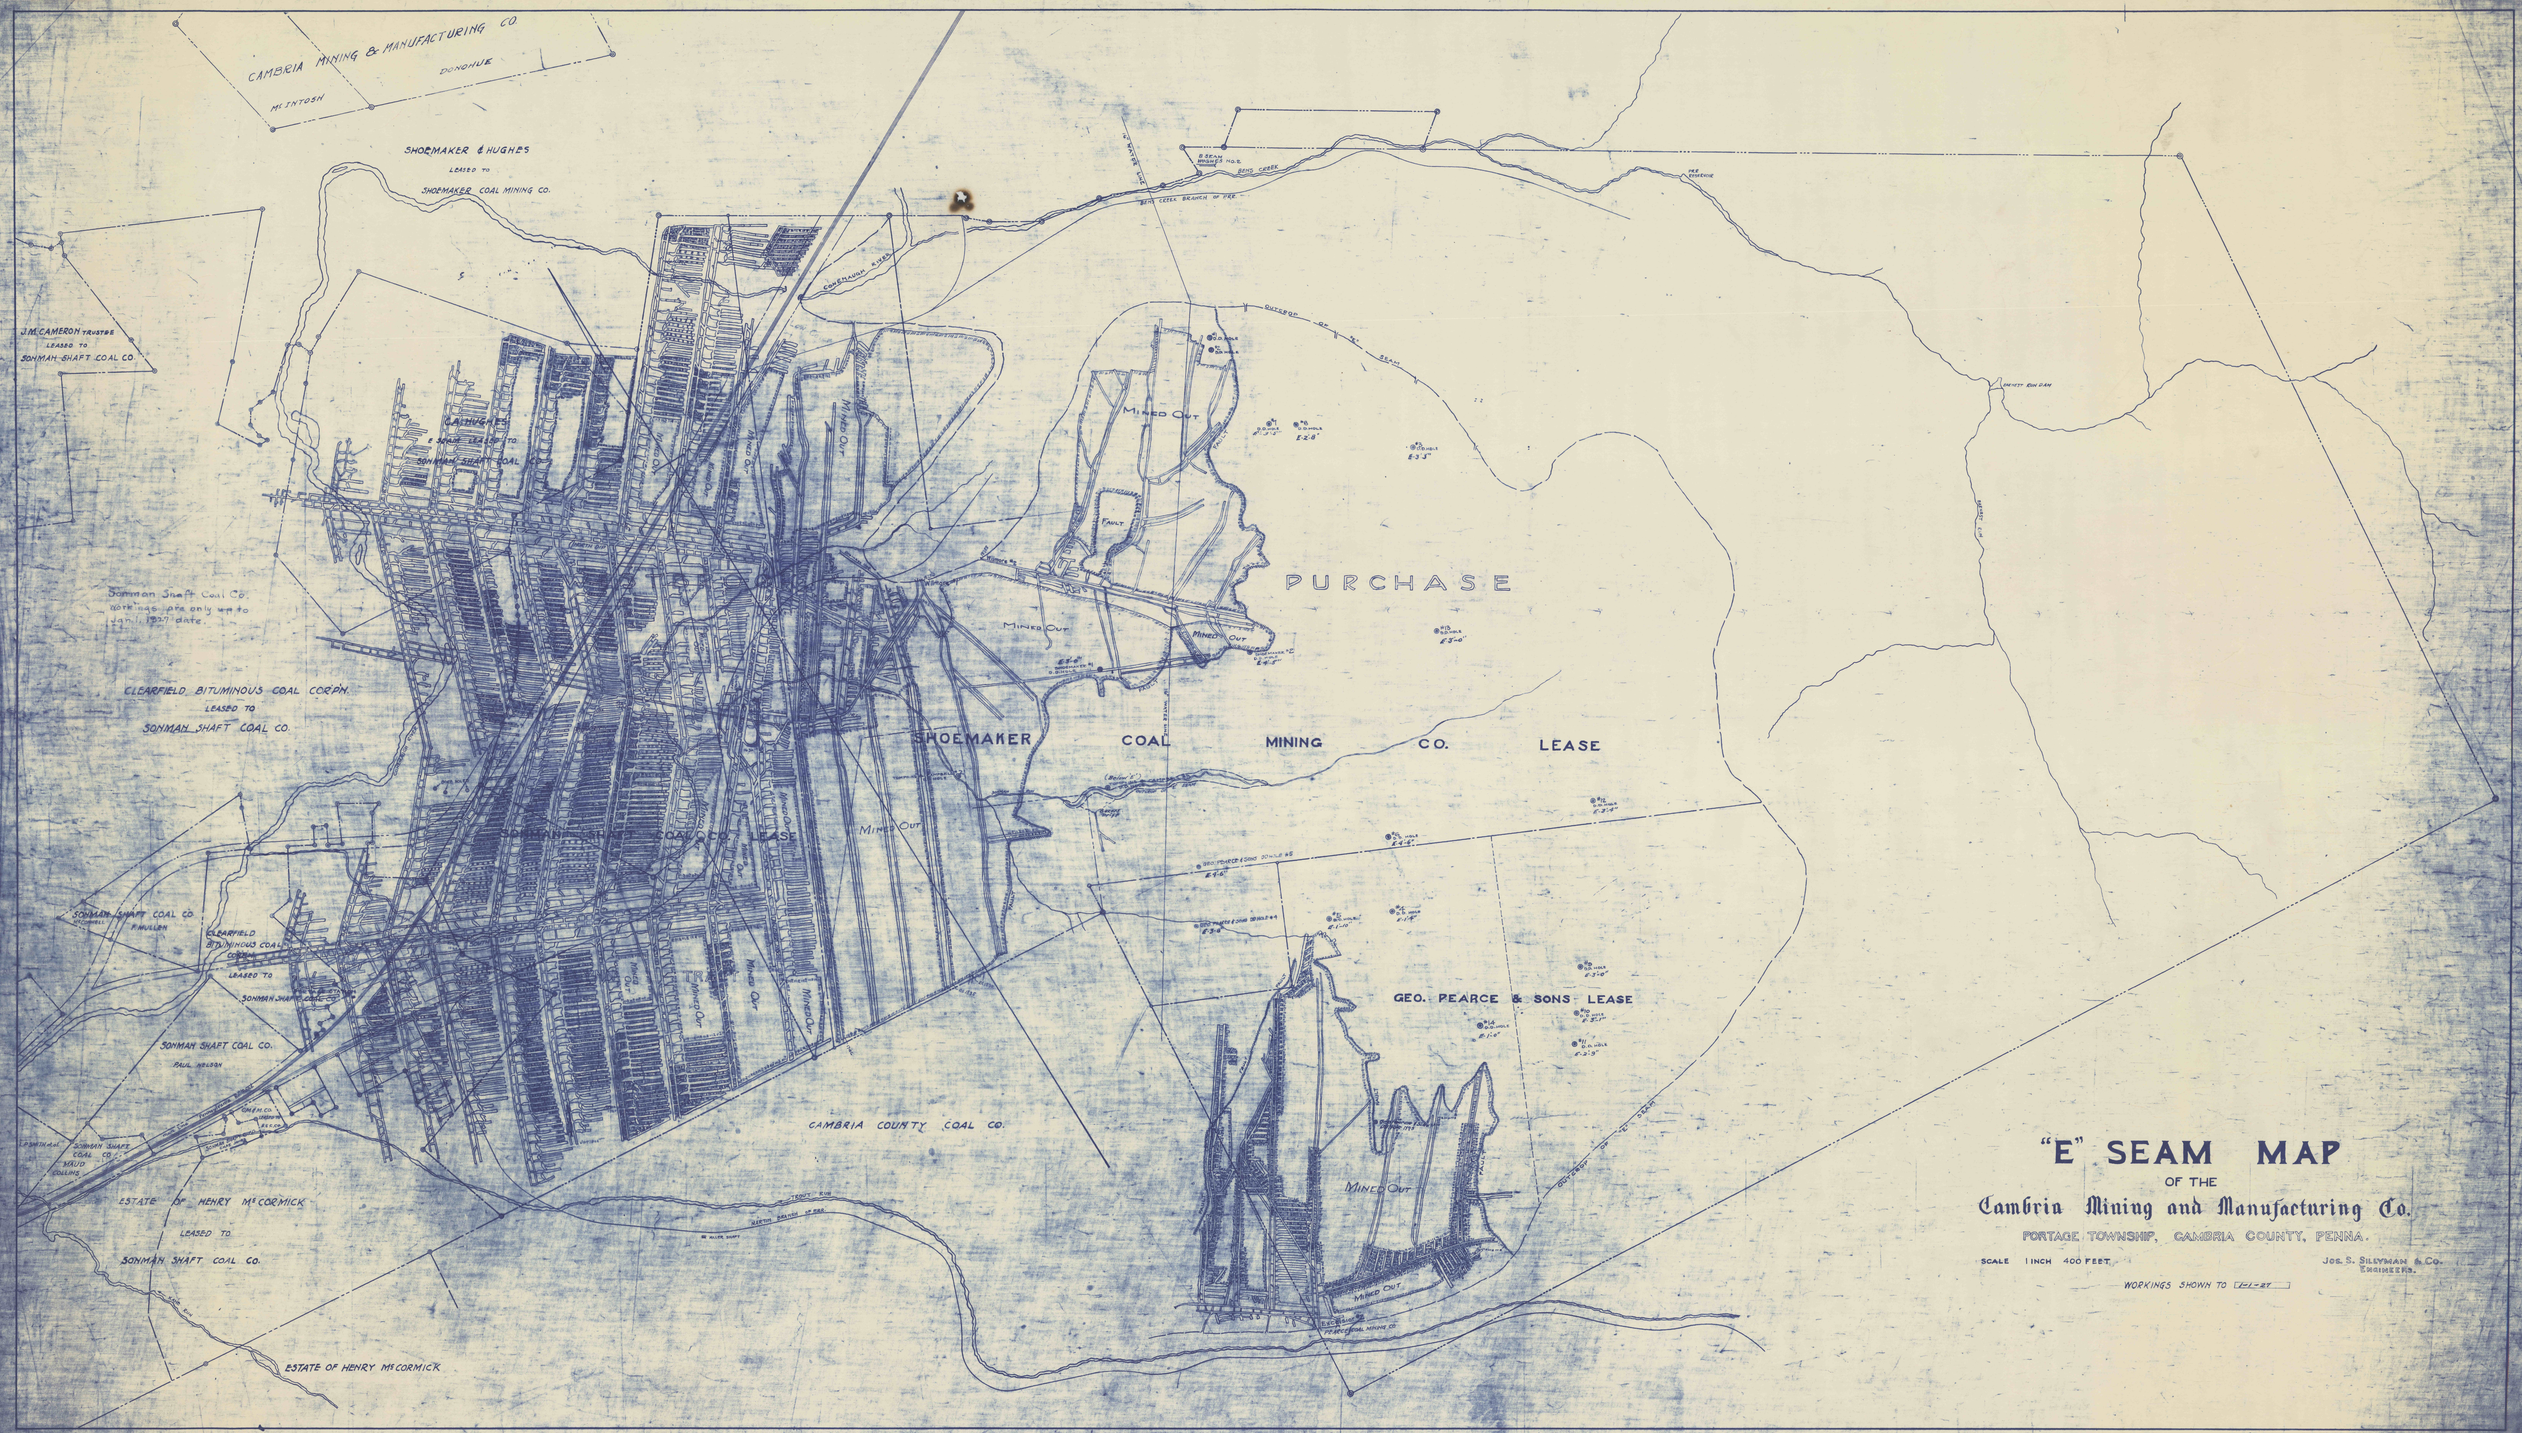
CAMBRIA MINING & MANUFACTURING CO
DONOHUE
McINTOSH
SHOEMAKER & HUGHES
LEASED TO
SHOEMAKER COAL MINING CO.
J.M. CAMERON TRUSTEE
LEASED TO
SONMAN SHAFT COAL CO.
C.A. HUGHES
E SEAM LEASED TO
SONMAN SHAFT COAL CO.
Sonman Shaft Coal Co.
workings are only up to
Jan. 1927 date
CLEARFIELD BITUMINOUS COAL CO. PA.
LEASED TO
SONMAN SHAFT COAL CO.
SHOEMAKER COAL MINING CO. LEASE
PURCHASE
MINED OUT
FAULT
SONMAN SHAFT COAL CO.
F. MULLEN
CLEARFIELD BITUMINOUS COAL CO.
LEASED TO
SONMAN SHAFT COAL CO.
SONMAN SHAFT COAL CO.
PAUL NELSON
CAMBRIA COUNTY COAL CO.
GEO. PEARCE & SONS LEASE
ESTATE OF HENRY McCORMICK
LEASED TO
SONMAN SHAFT COAL CO.
ESTATE OF HENRY McCORMICK
"E" SEAM MAP
OF THE
Cambria Mining and Manufacturing Co.
PORTAGE TOWNSHIP, CAMBRIA COUNTY, PENNA.
SCALE 1 INCH 400 FEET.
JOS. S. SILLYMAN & CO.
ENGINEERS.
WORKINGS SHOWN TO 1-1-27