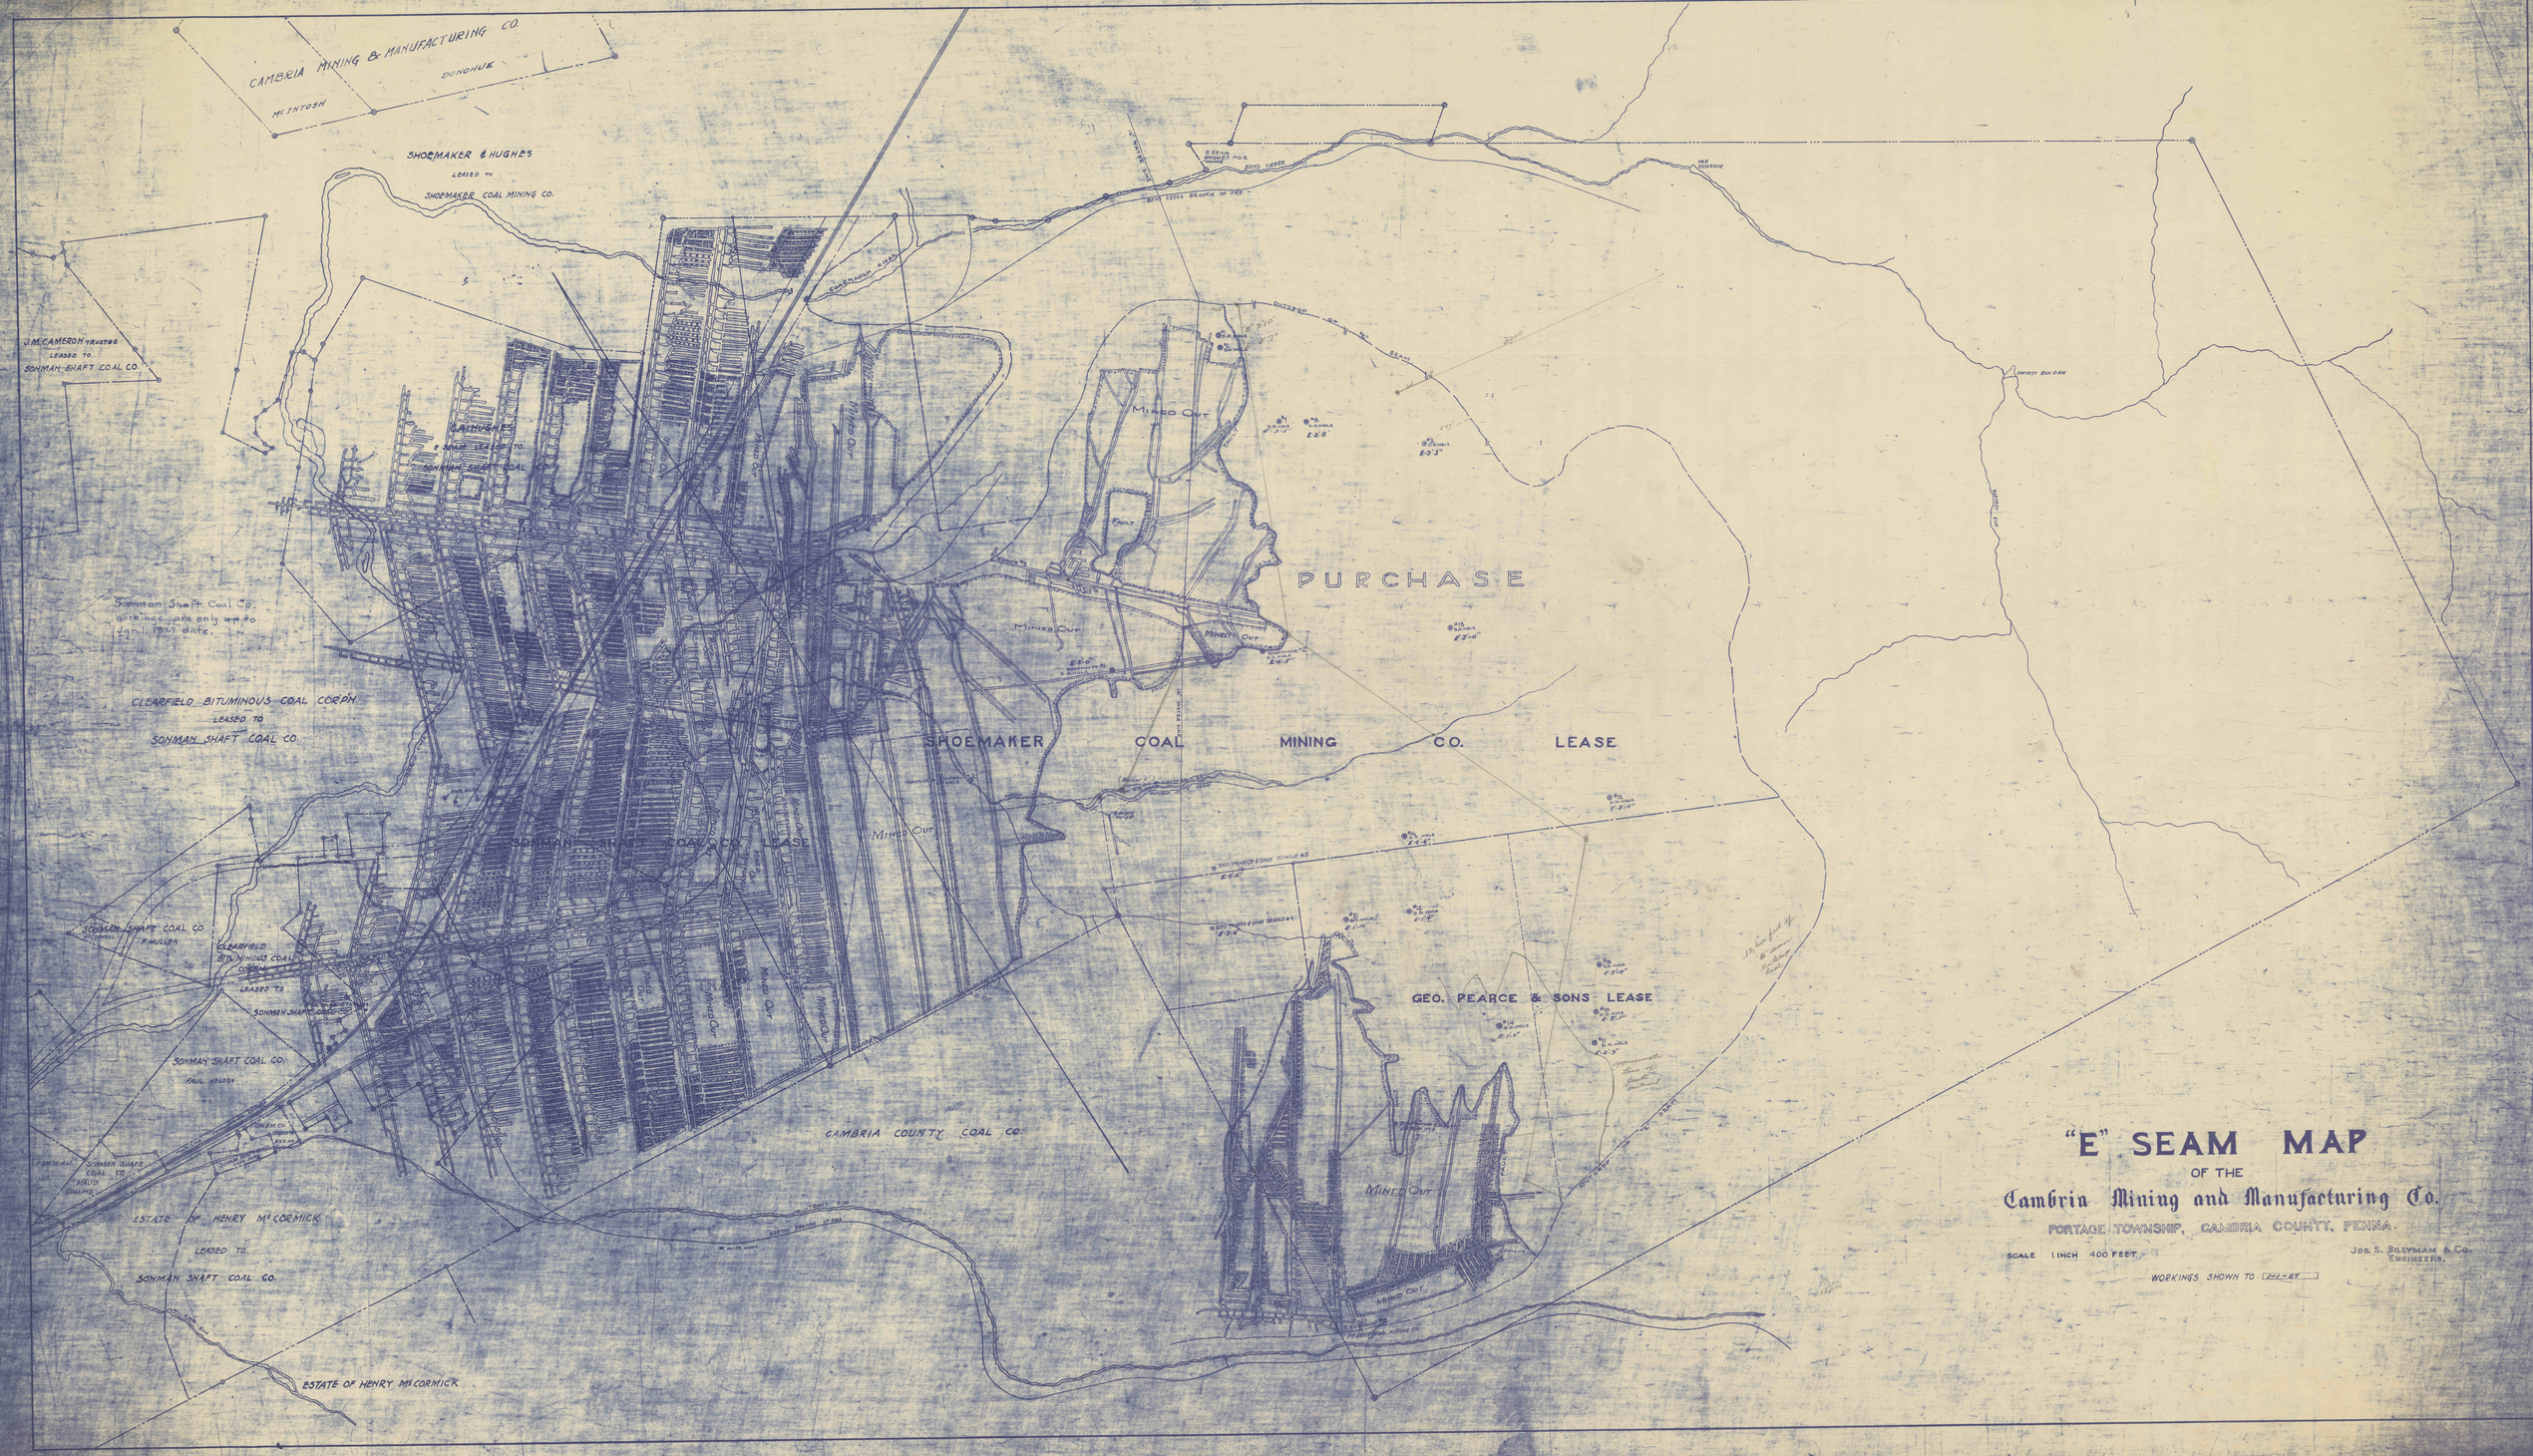
CAMBRIA MINING & MANUFACTURING CO.
McINTOSH
DONOHUE
SHOEMAKER & HUGHES
LEASED TO
SHOEMAKER COAL MINING CO.
J.M. CAMERON TRUSTEE
LEASED TO
SONMAN SHAFT COAL CO.
Sonman Shaft Coal Co.
workings are only up to
Jan. 1, 1927 date.
CLEARFIELD BITUMINOUS COAL CORP'N.
LEASED TO
SONMAN SHAFT COAL CO.
SONMAN SHAFT COAL CO.
SONMAN SHAFT COAL CO.
PAUL NELSON
ESTATE OF HENRY McCORMICK
LEASED TO
SONMAN SHAFT COAL CO.
ESTATE OF HENRY McCORMICK
CAMBRIA COUNTY COAL CO.
PURCHASE
SHOEMAKER COAL MINING CO. LEASE
GEO. PEARCE & SONS LEASE
MINED OUT
FAULT
OUTCROP OF "E" SEAM
"E" SEAM MAP
OF THE
Cambria Mining and Manufacturing Co.
PORTAGE TOWNSHIP, CAMBRIA COUNTY, PENNA.
SCALE 1 INCH 400 FEET
JOS. S. SILLYMAN & CO.
ENGINEERS.
WORKINGS SHOWN TO 1-1-27