


4007

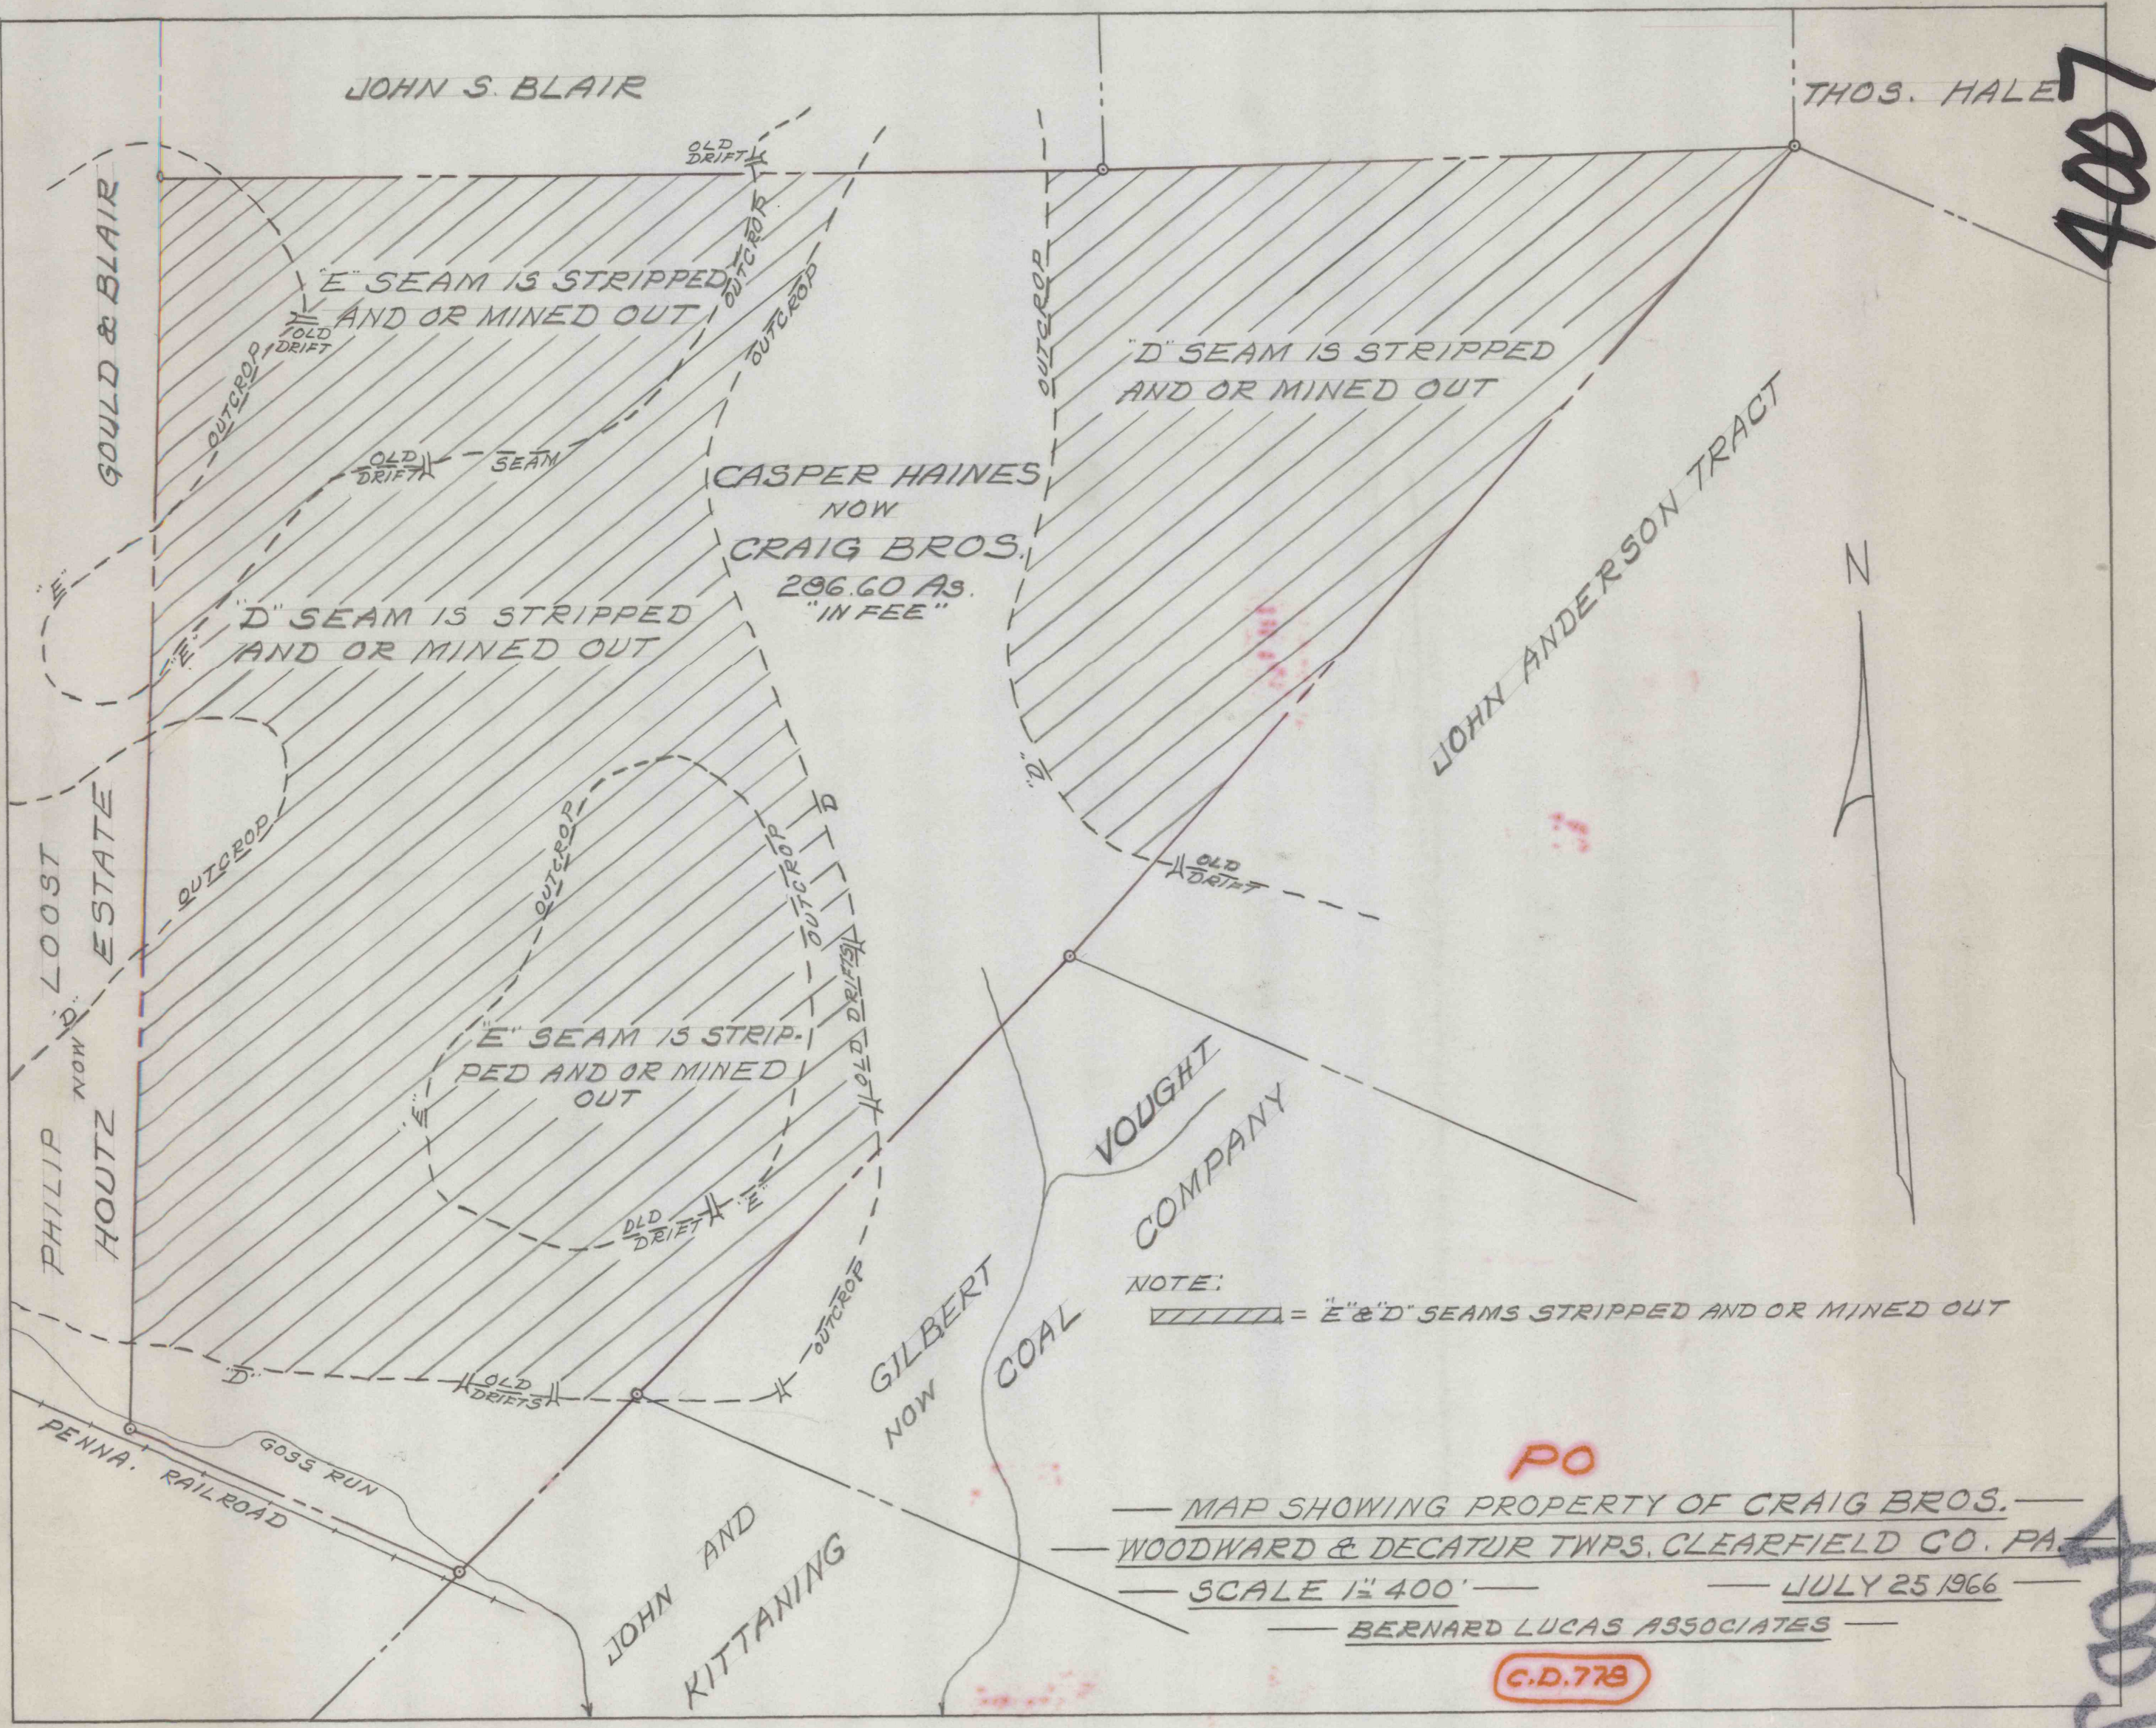

NOTE:
 [Hatched Area] = "E" & "D" SEAMS STRIPPED AND OR MINED OUT

PO
 — MAP SHOWING PROPERTY OF CRAIG BROS. —
 — WOODWARD & DECATUR TWP., CLEARFIELD CO., PA. —
 — SCALE 1" = 400' — JULY 25 1966 —
 — BERNARD LUCAS ASSOCIATES —

C.D. 778

4007