


EXHIBITS "B" and "C"

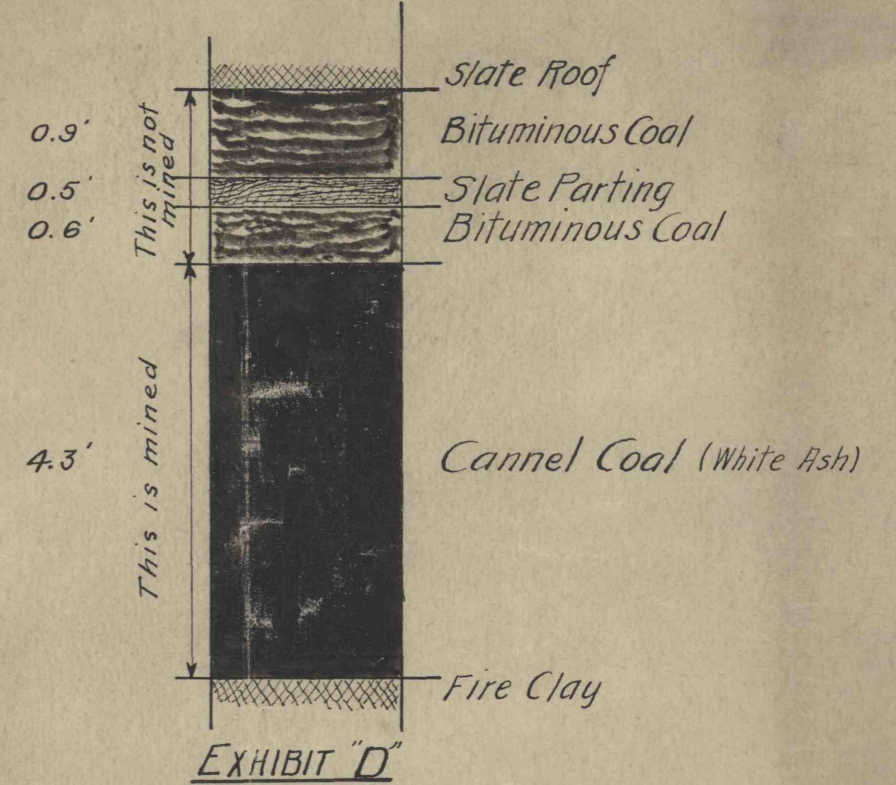

PD

Map Showing Mine Workings and Location of Mine, of the Moshannon Creek Coal Mining Company, in the Borough of South Philipsburg, Centre County, Pennsylvania, and also the Leaseholds of Said Company.

Scale 1"=400'

Philpsburg, Pa. Jan. 1, 1923.

H.M.D. Lorain, Mining Engineer

CD. 829

4455