


4694

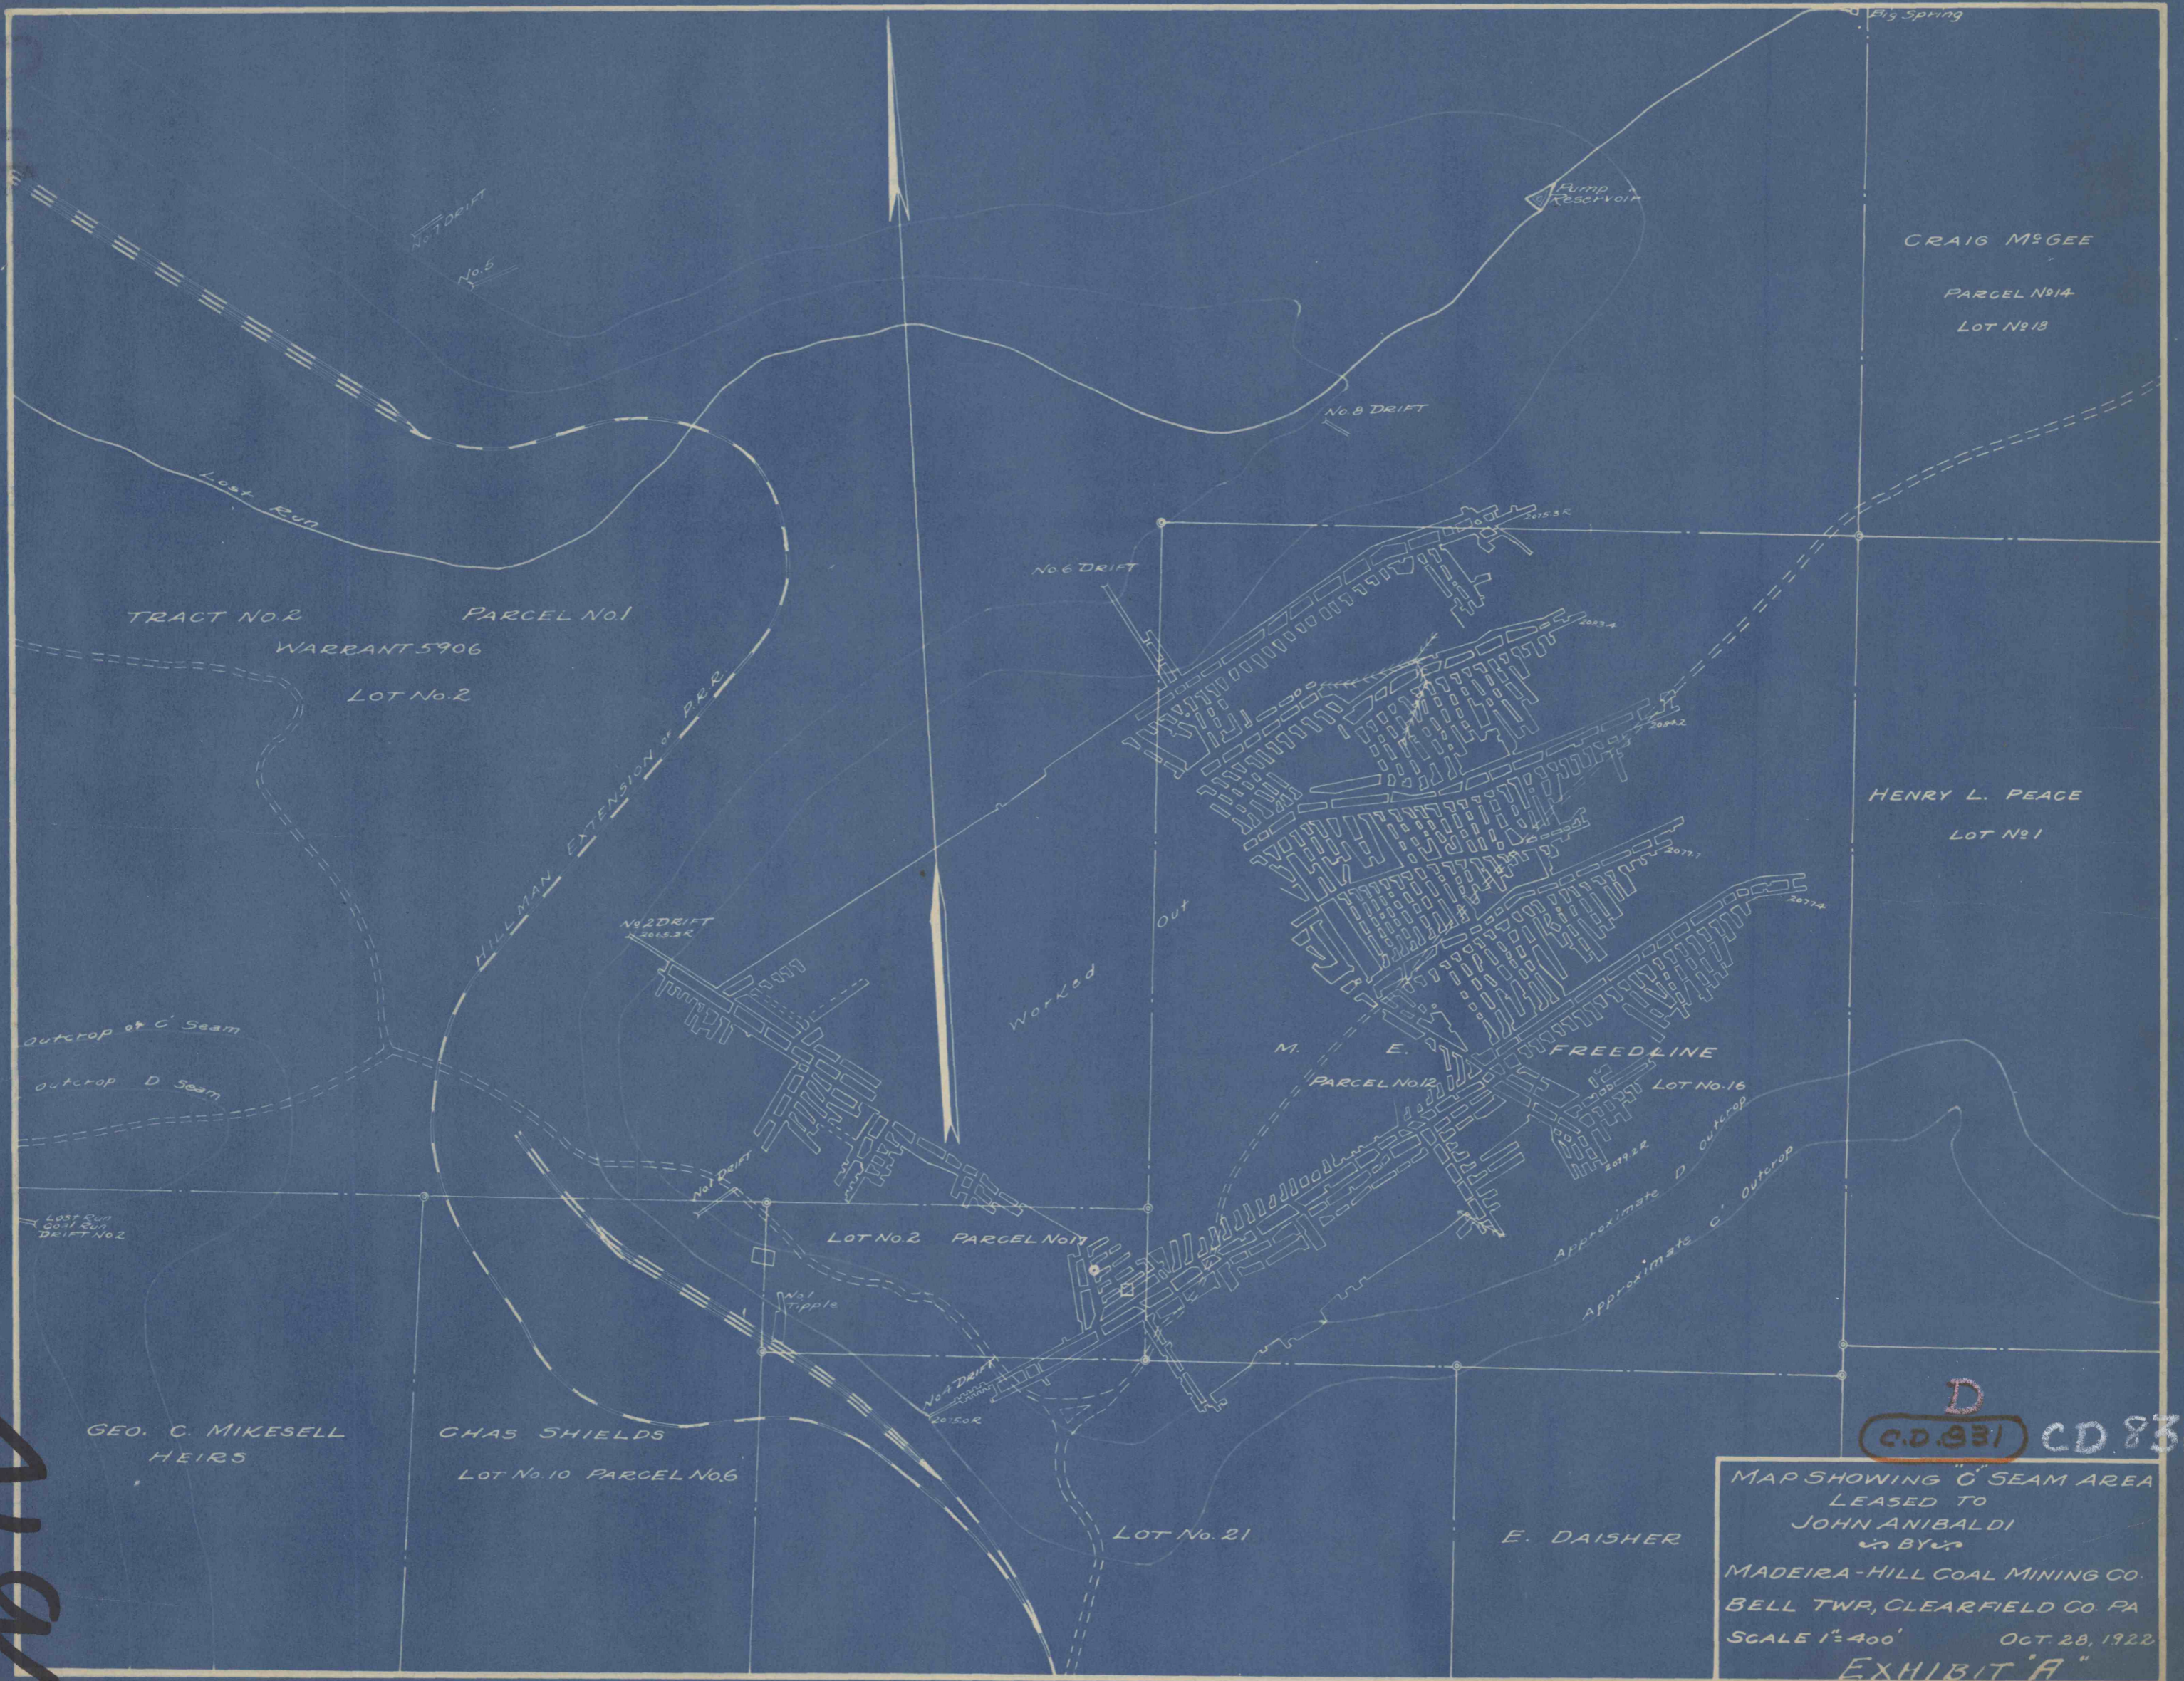

D  
 C.D. 931 CD 831

MAP SHOWING "G" SEAM AREA  
 LEASED TO  
 JOHN ANIBALDI  
 BY  
 MADEIRA-HILL COAL MINING CO.  
 BELL TWP, CLEARFIELD CO. PA  
 SCALE 1"=400' OCT. 28, 1922  
 EXHIBIT "A"