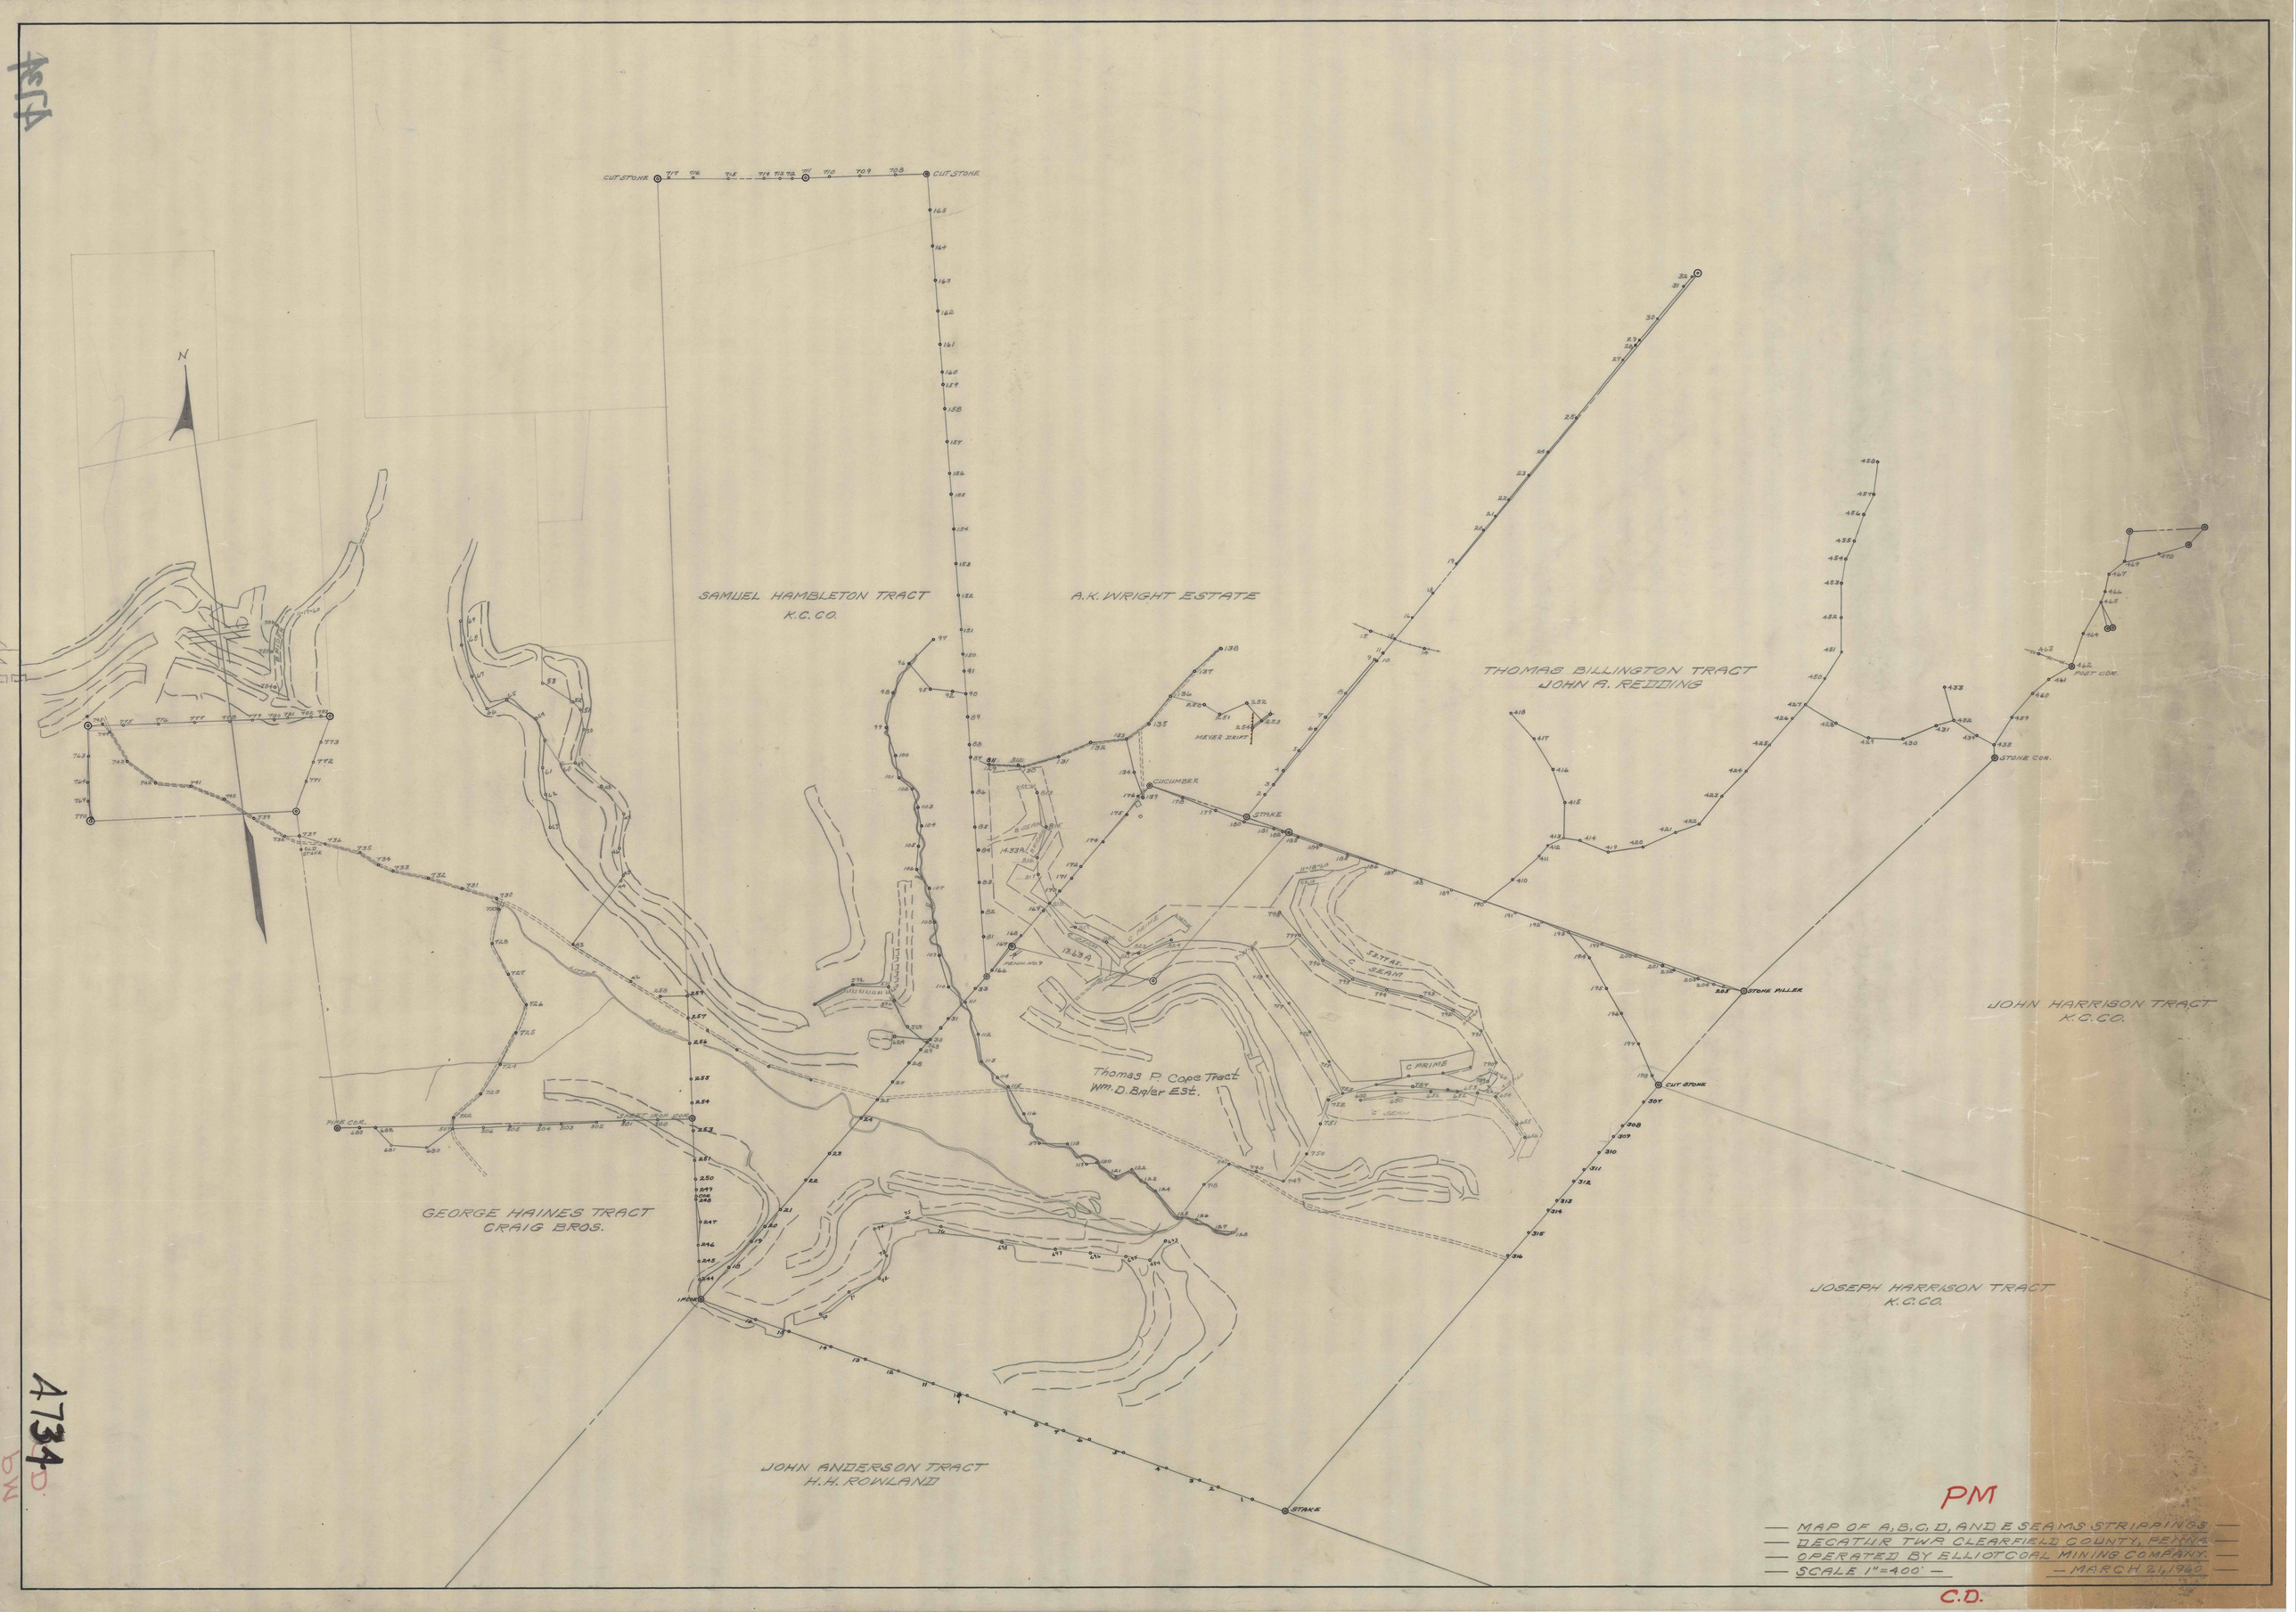
N
SAMUEL HAMBLETON TRACT
K.C.CO.
A.K. WRIGHT ESTATE
THOMAS BILLINGTON TRACT
JOHN A. REIDING
JOHN HARRISON TRACT
K.C.CO.
JOSEPH HARRISON TRACT
K.C.CO.
GEORGE HAINES TRACT
CRAIG BROS.
JOHN ANDERSON TRACT
H.H. ROWLAND
Thomas P. Cope Tract
Wm. D. Bixler Est.
CUT STONE
STONE COR.
STONE PILLER
POST COR.
PINE COR.
STAKE
CUCUMBER
MEYER DRIFT
C PRIME
C SEAM
PM
MAP OF A, B, C, D, AND E SEAMS STRIPPINGS
DECATUR TWP. CLEARFIELD COUNTY, PENNA.
OPERATED BY ELLIOT COAL MINING COMPANY.
SCALE 1" = 400'
MARCH 21, 1960
C.D.

4734