

and Bradley Tract

Right owned by Dr. J. Hughes

Daniel Lantry
55 Acres

Samuel Lantry
95 Acres


Blair Coal & Iron Co

Hood
300 Acres

W. H. Piper
231 Acres

McDonough
100 Acres

118 Acres

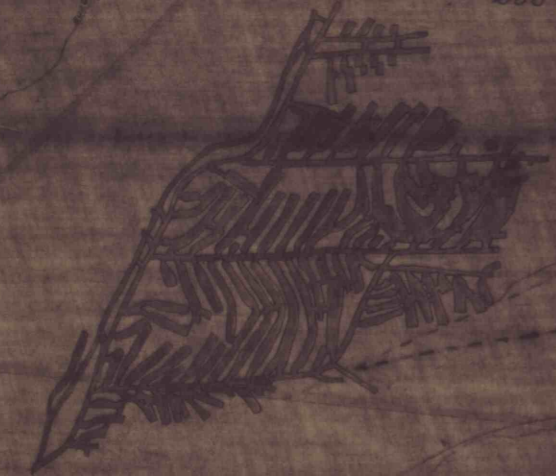

W. H. Piper & Co
Sharp trail

Wagon

Quadrant No. 17
2000 ft. on road
L. MacDonell

