


4766

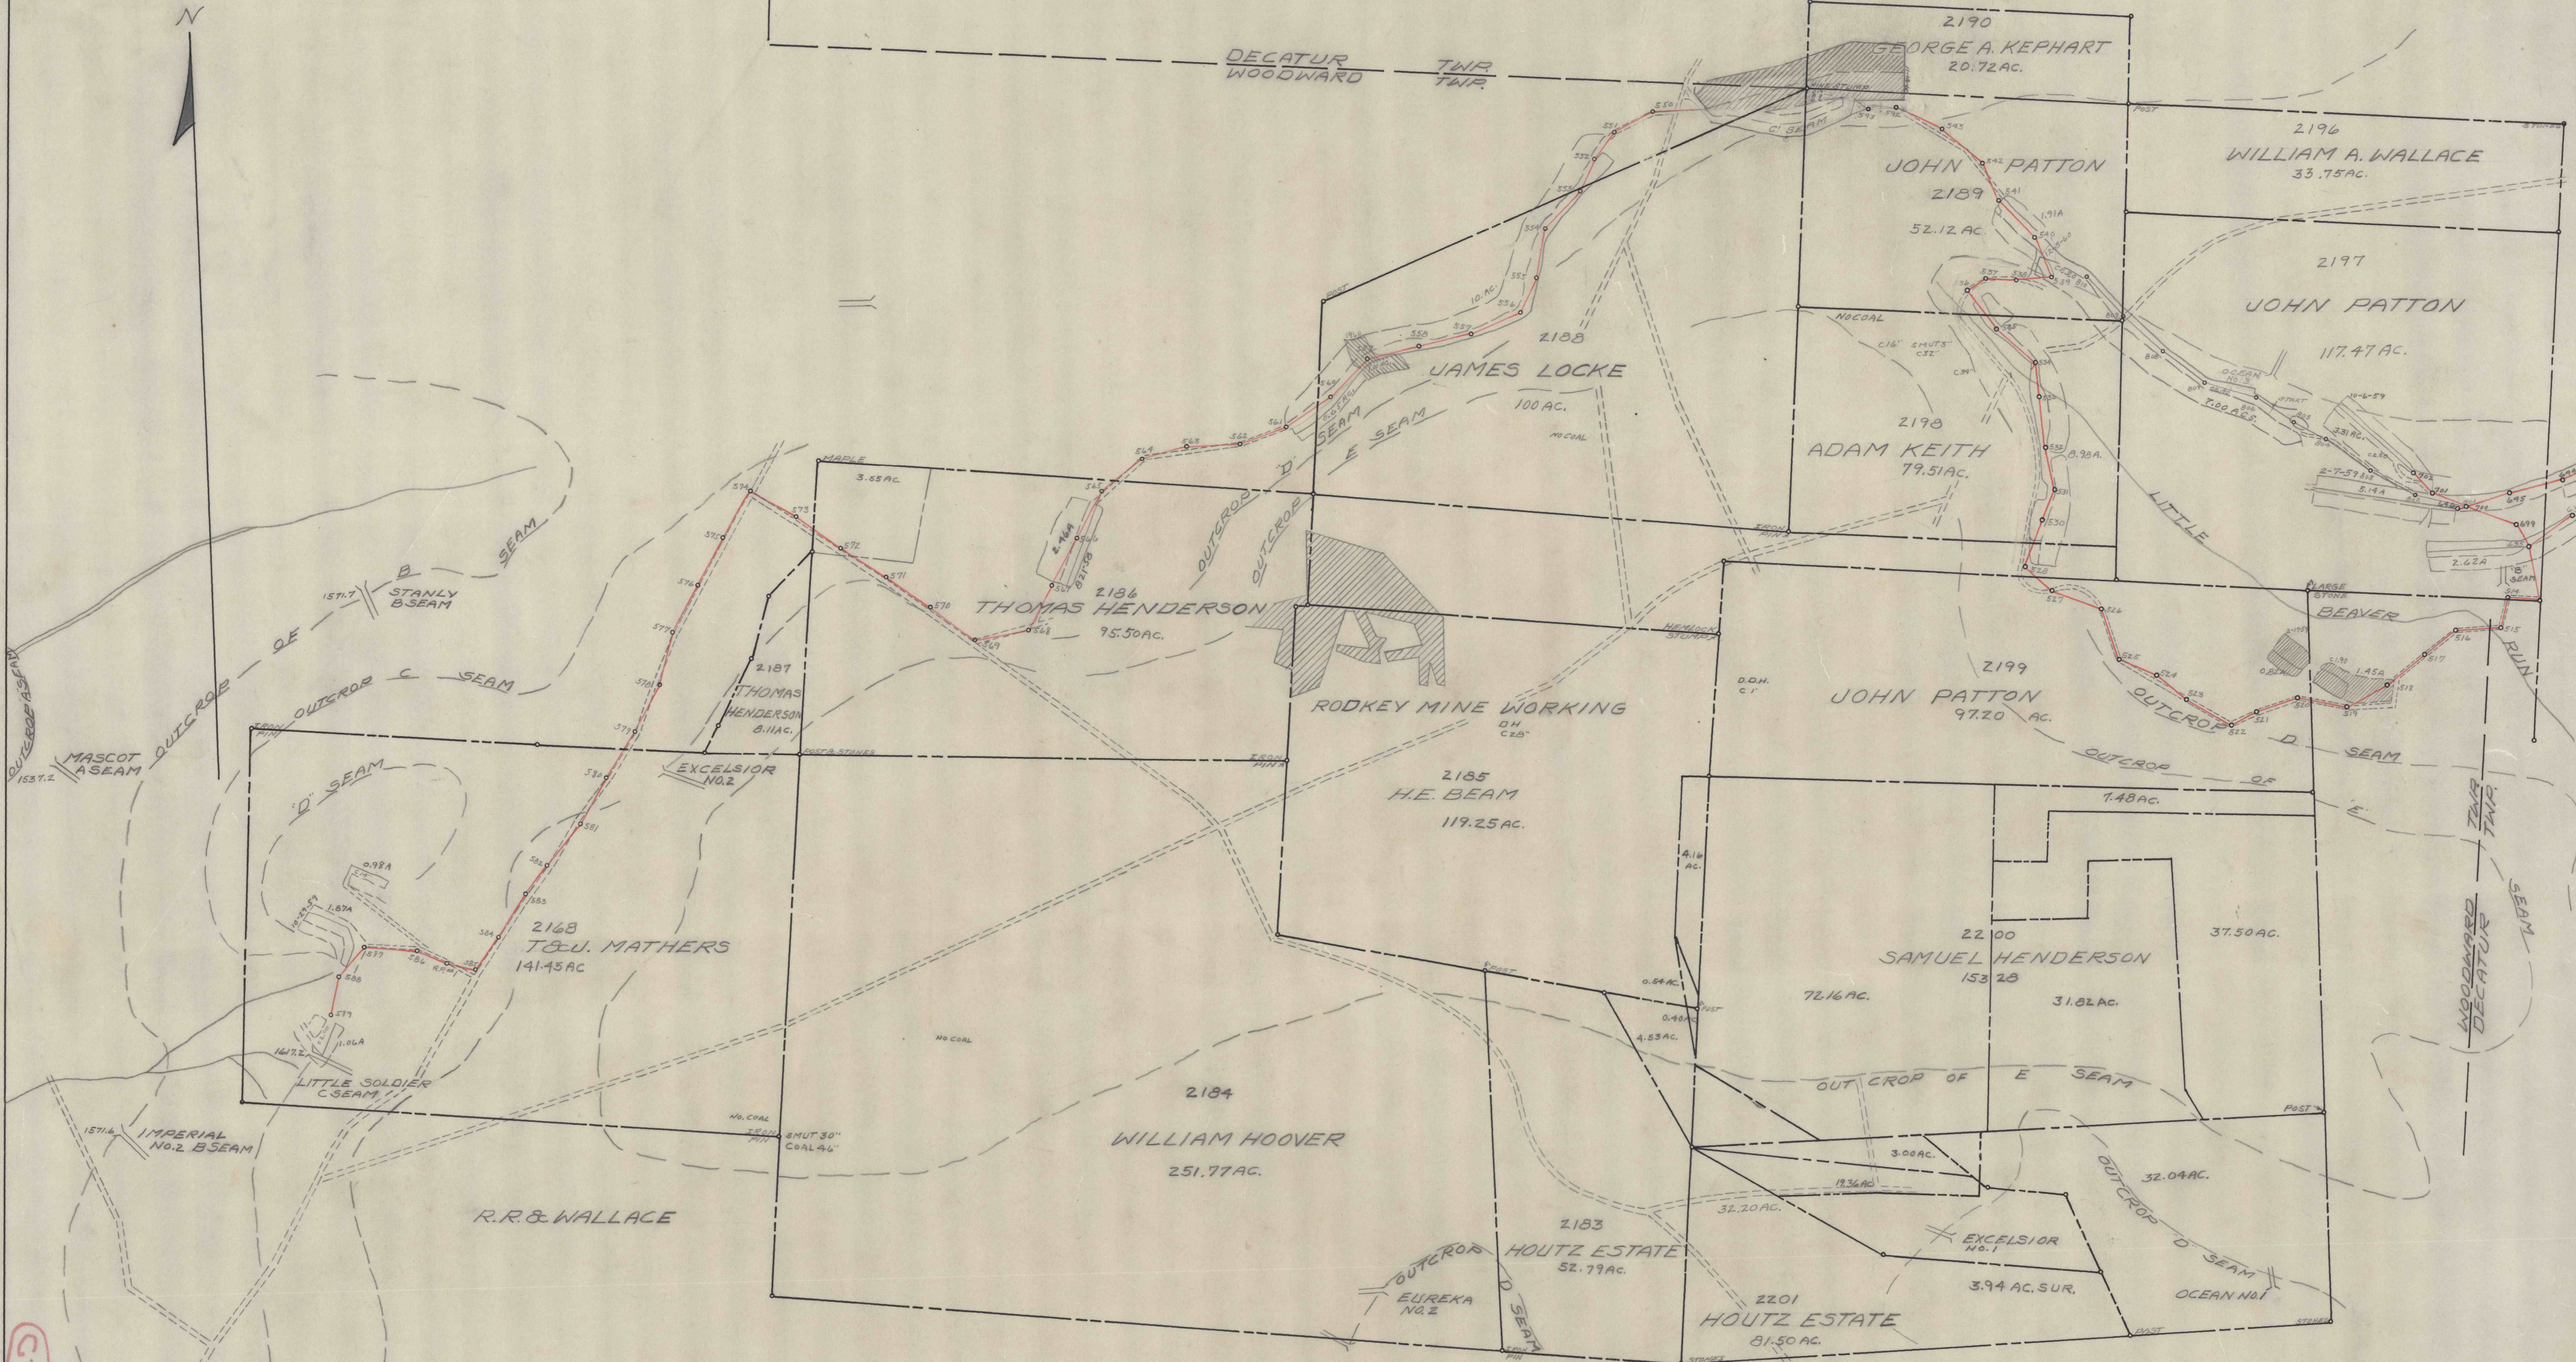

C.D.

M

— ELLIOT COAL MINING CO. —
 — PHILIPSBURG PENNSYLVANIA —

— MAP SHOWING STRIPPING OPERATIONS IN WOODWARD —
 — TOWNSHIP CLEARFIELD COUNTY PENNSYLVANIA ON THE —
 — MISS MEGLYNN LEASE —

— SCALE 1"=400' —

— FEBRUARY 4TH 1959

4588