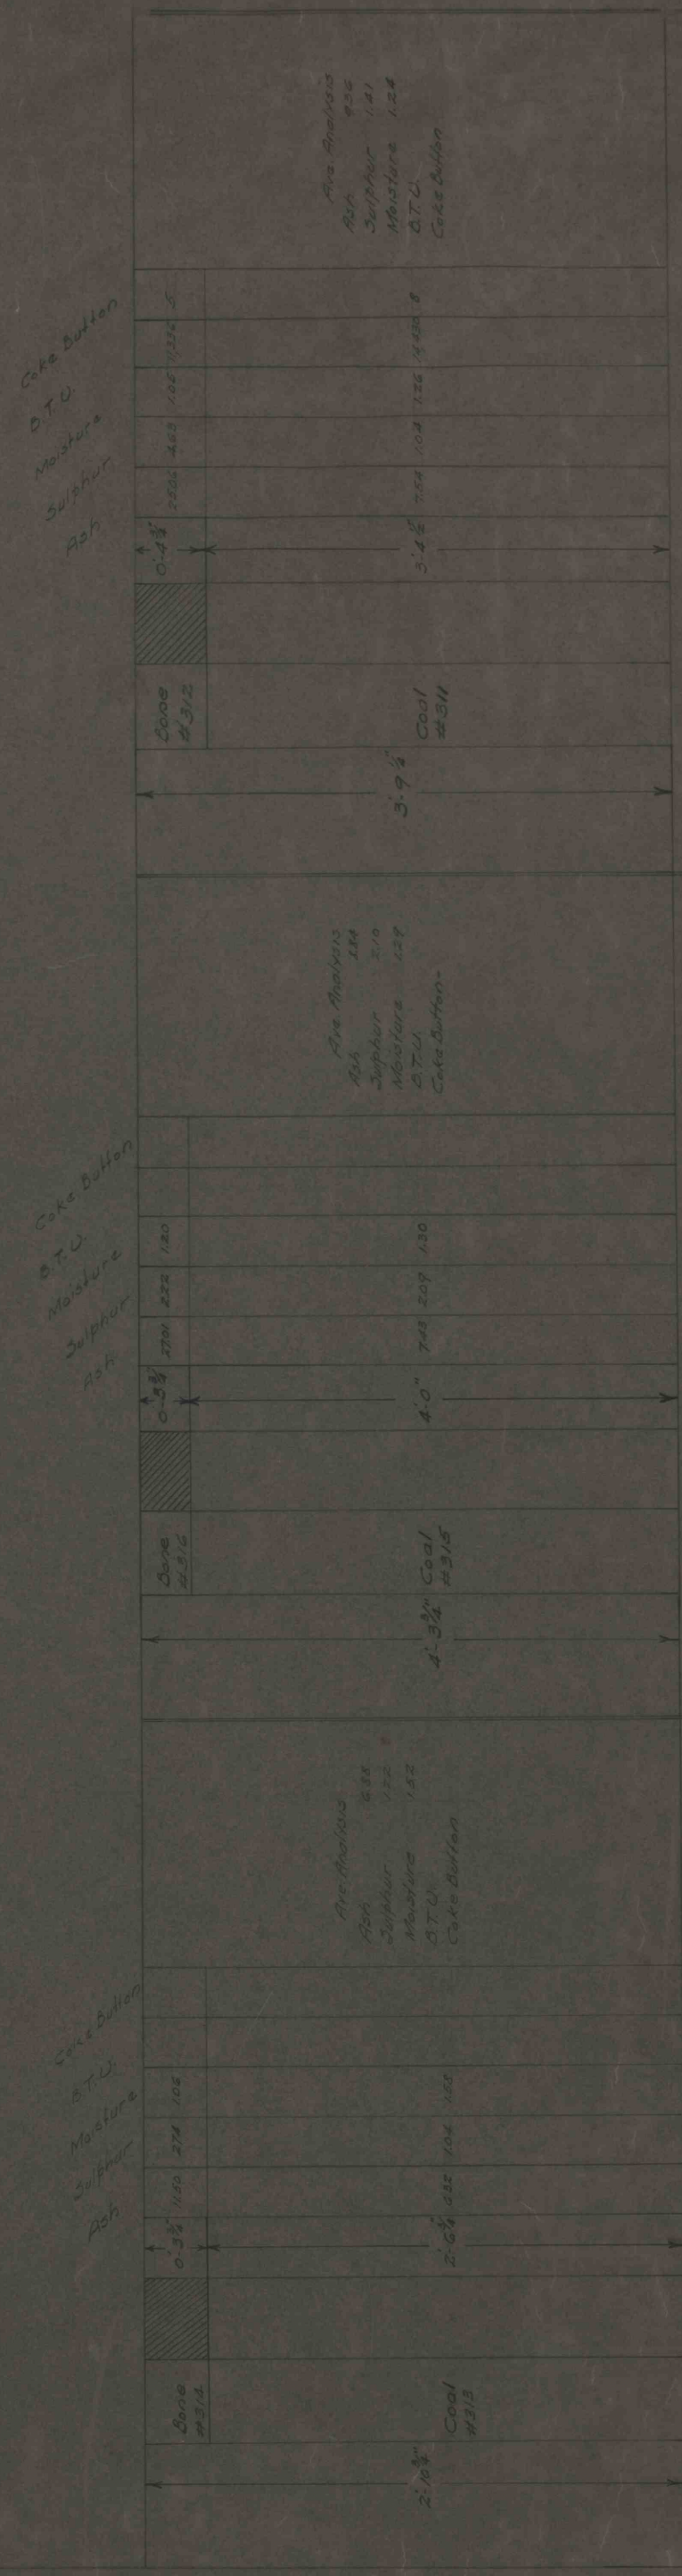JOHNSTOWN COAL AND COKE CO
PORTAGE No 4 MINE
COAL ANALYSES
No 1 MAIN SOUTH AND PANEL HDGS
JULY 20-1951